


Profile & Deck Plan of Nos 81 & 82
Scale 1/4" = one foot

No 81. S.S. "Risueglia" Glasgow Report No 5566.
No 82. S.S. "Persevero" Glasgow Report No 5605

H. MONTYRE & CO.,
3rd June 1881
Tracing No 1651

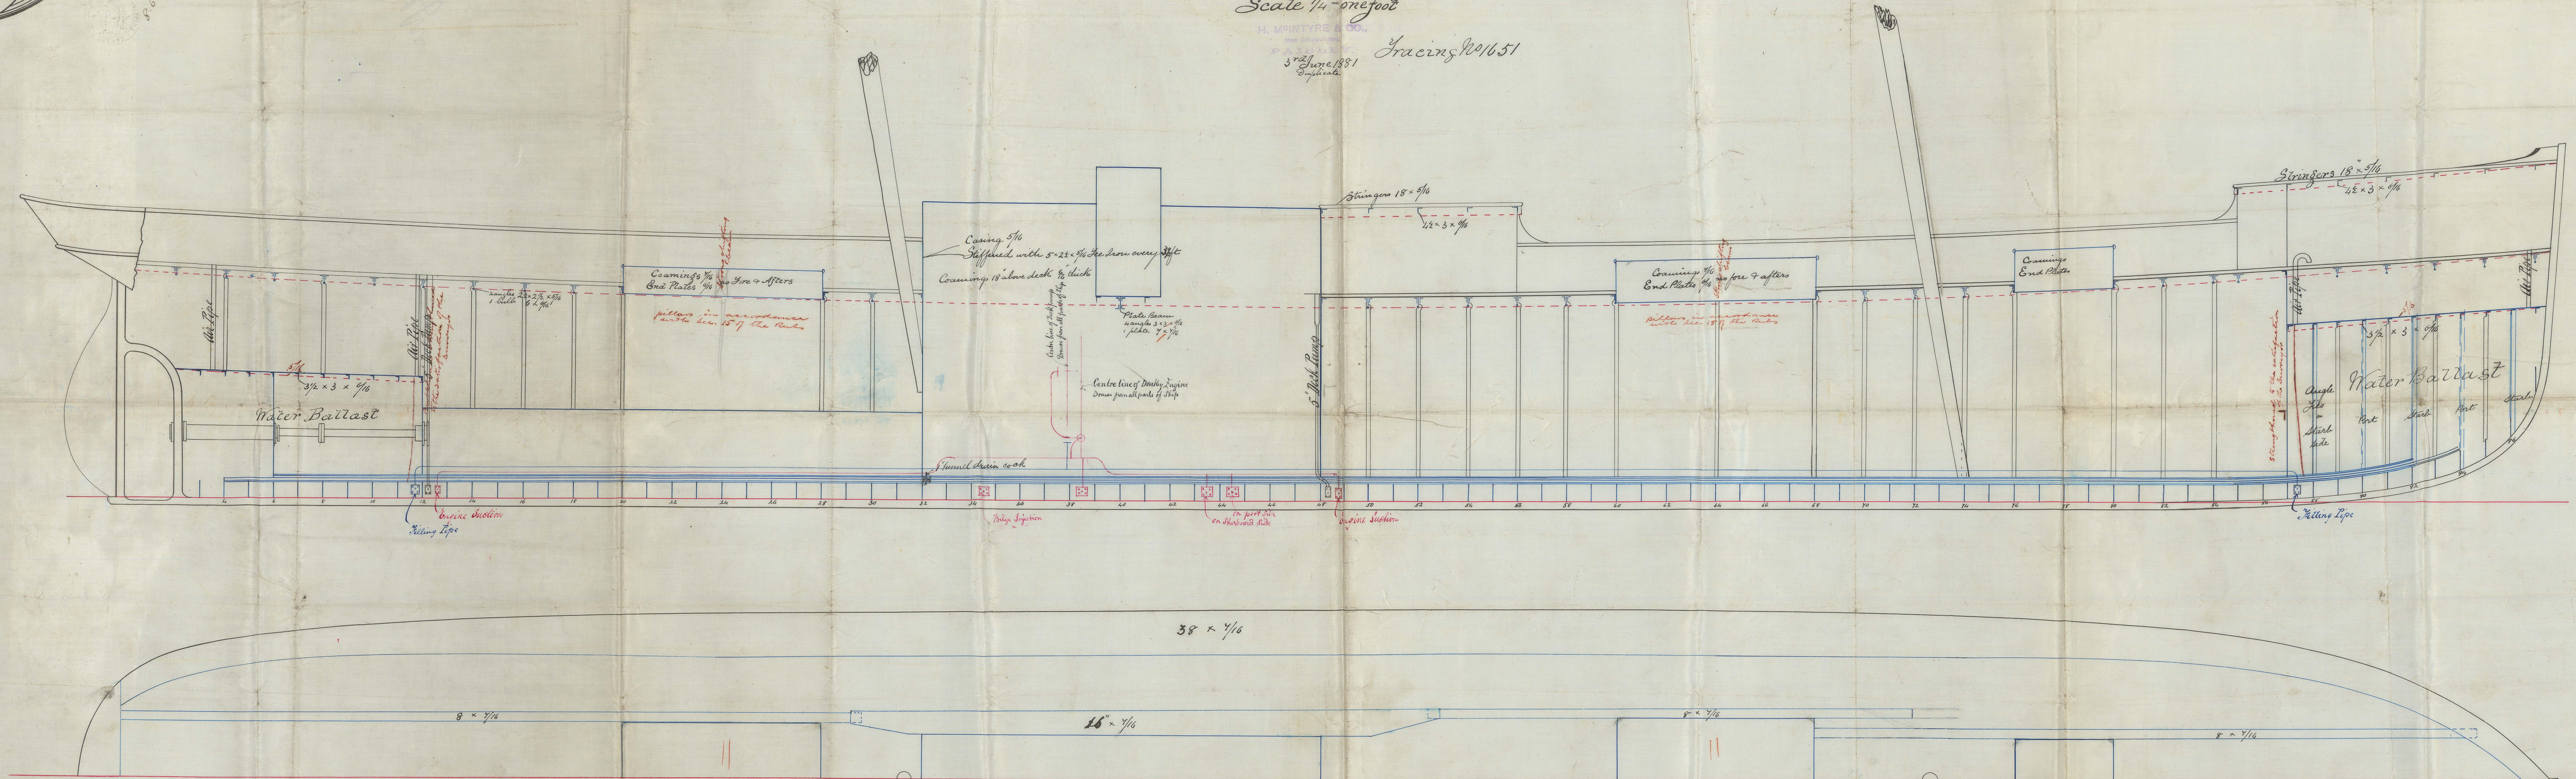

14/2
8/1/81