


26.11.80

PLAN SHOWING DIAGONALS &c, as Compensation for $\frac{1}{2}$ iron deck Required by Rule
SS N° 302 & 3

SCALE $\frac{1}{8}$ INCH TO A FOOT

Glasgow Report of 5504 & 5540
iron ship "Loche Noisart" & "Loche Terridon"

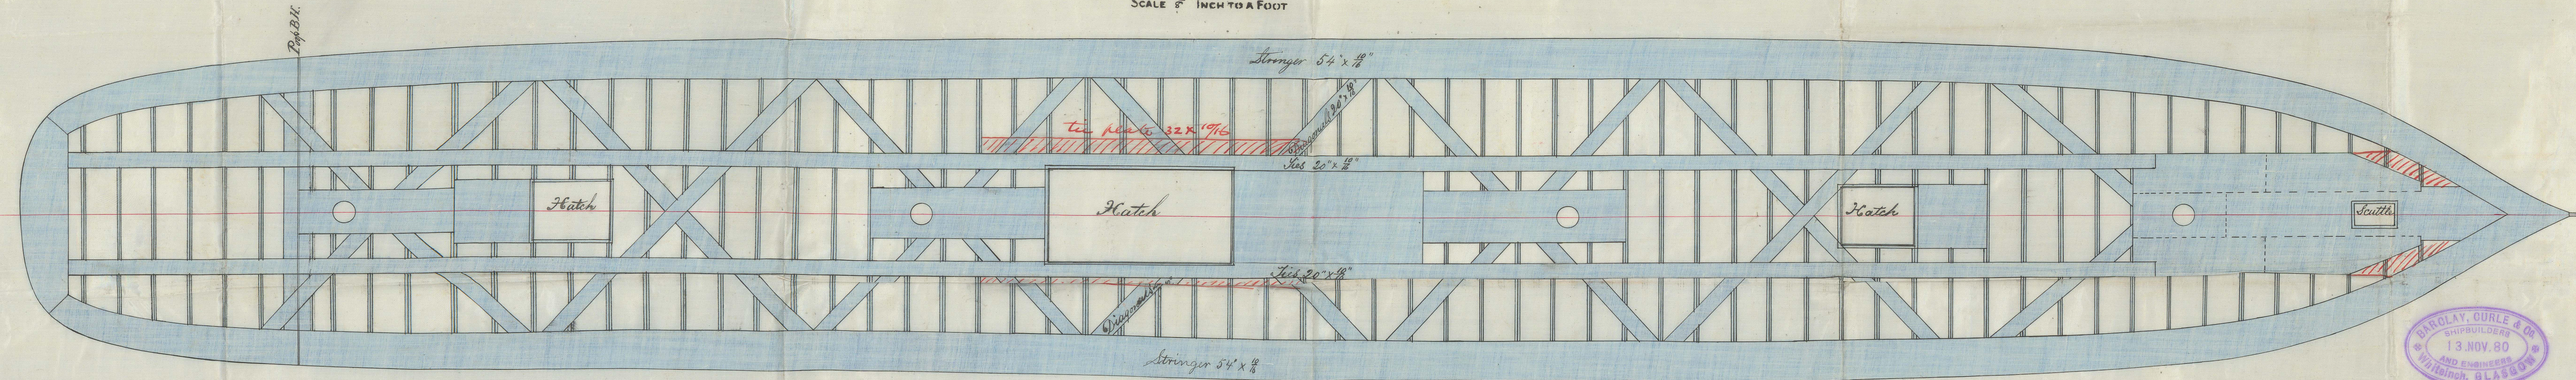

BARCLAY, CURLE & CO
SHIPBUILDERS
13 NOV. 80
AND ENGINEERS
Whiteinch, GLASGOW

1822
25/11/80