


26-11-80

Depths 10.33

SCALE $\frac{1}{2}$ INCH TO A FOOT.



3 Bower Anchors	114 Cuts	Collective Weight	Ex Stock
1 Stream "	12 "	"	"
1 Hedge "	6 "	"	"
1 " "	3 "	1 "	"
240 Fathoms Stud Chain Cable	2 1/4	76 5/10 tons	Admiralty List
100 " Stream	1 3/16		
90 " Towline	12 "		
90 " Warp	11 "		
90 " "	7 "		

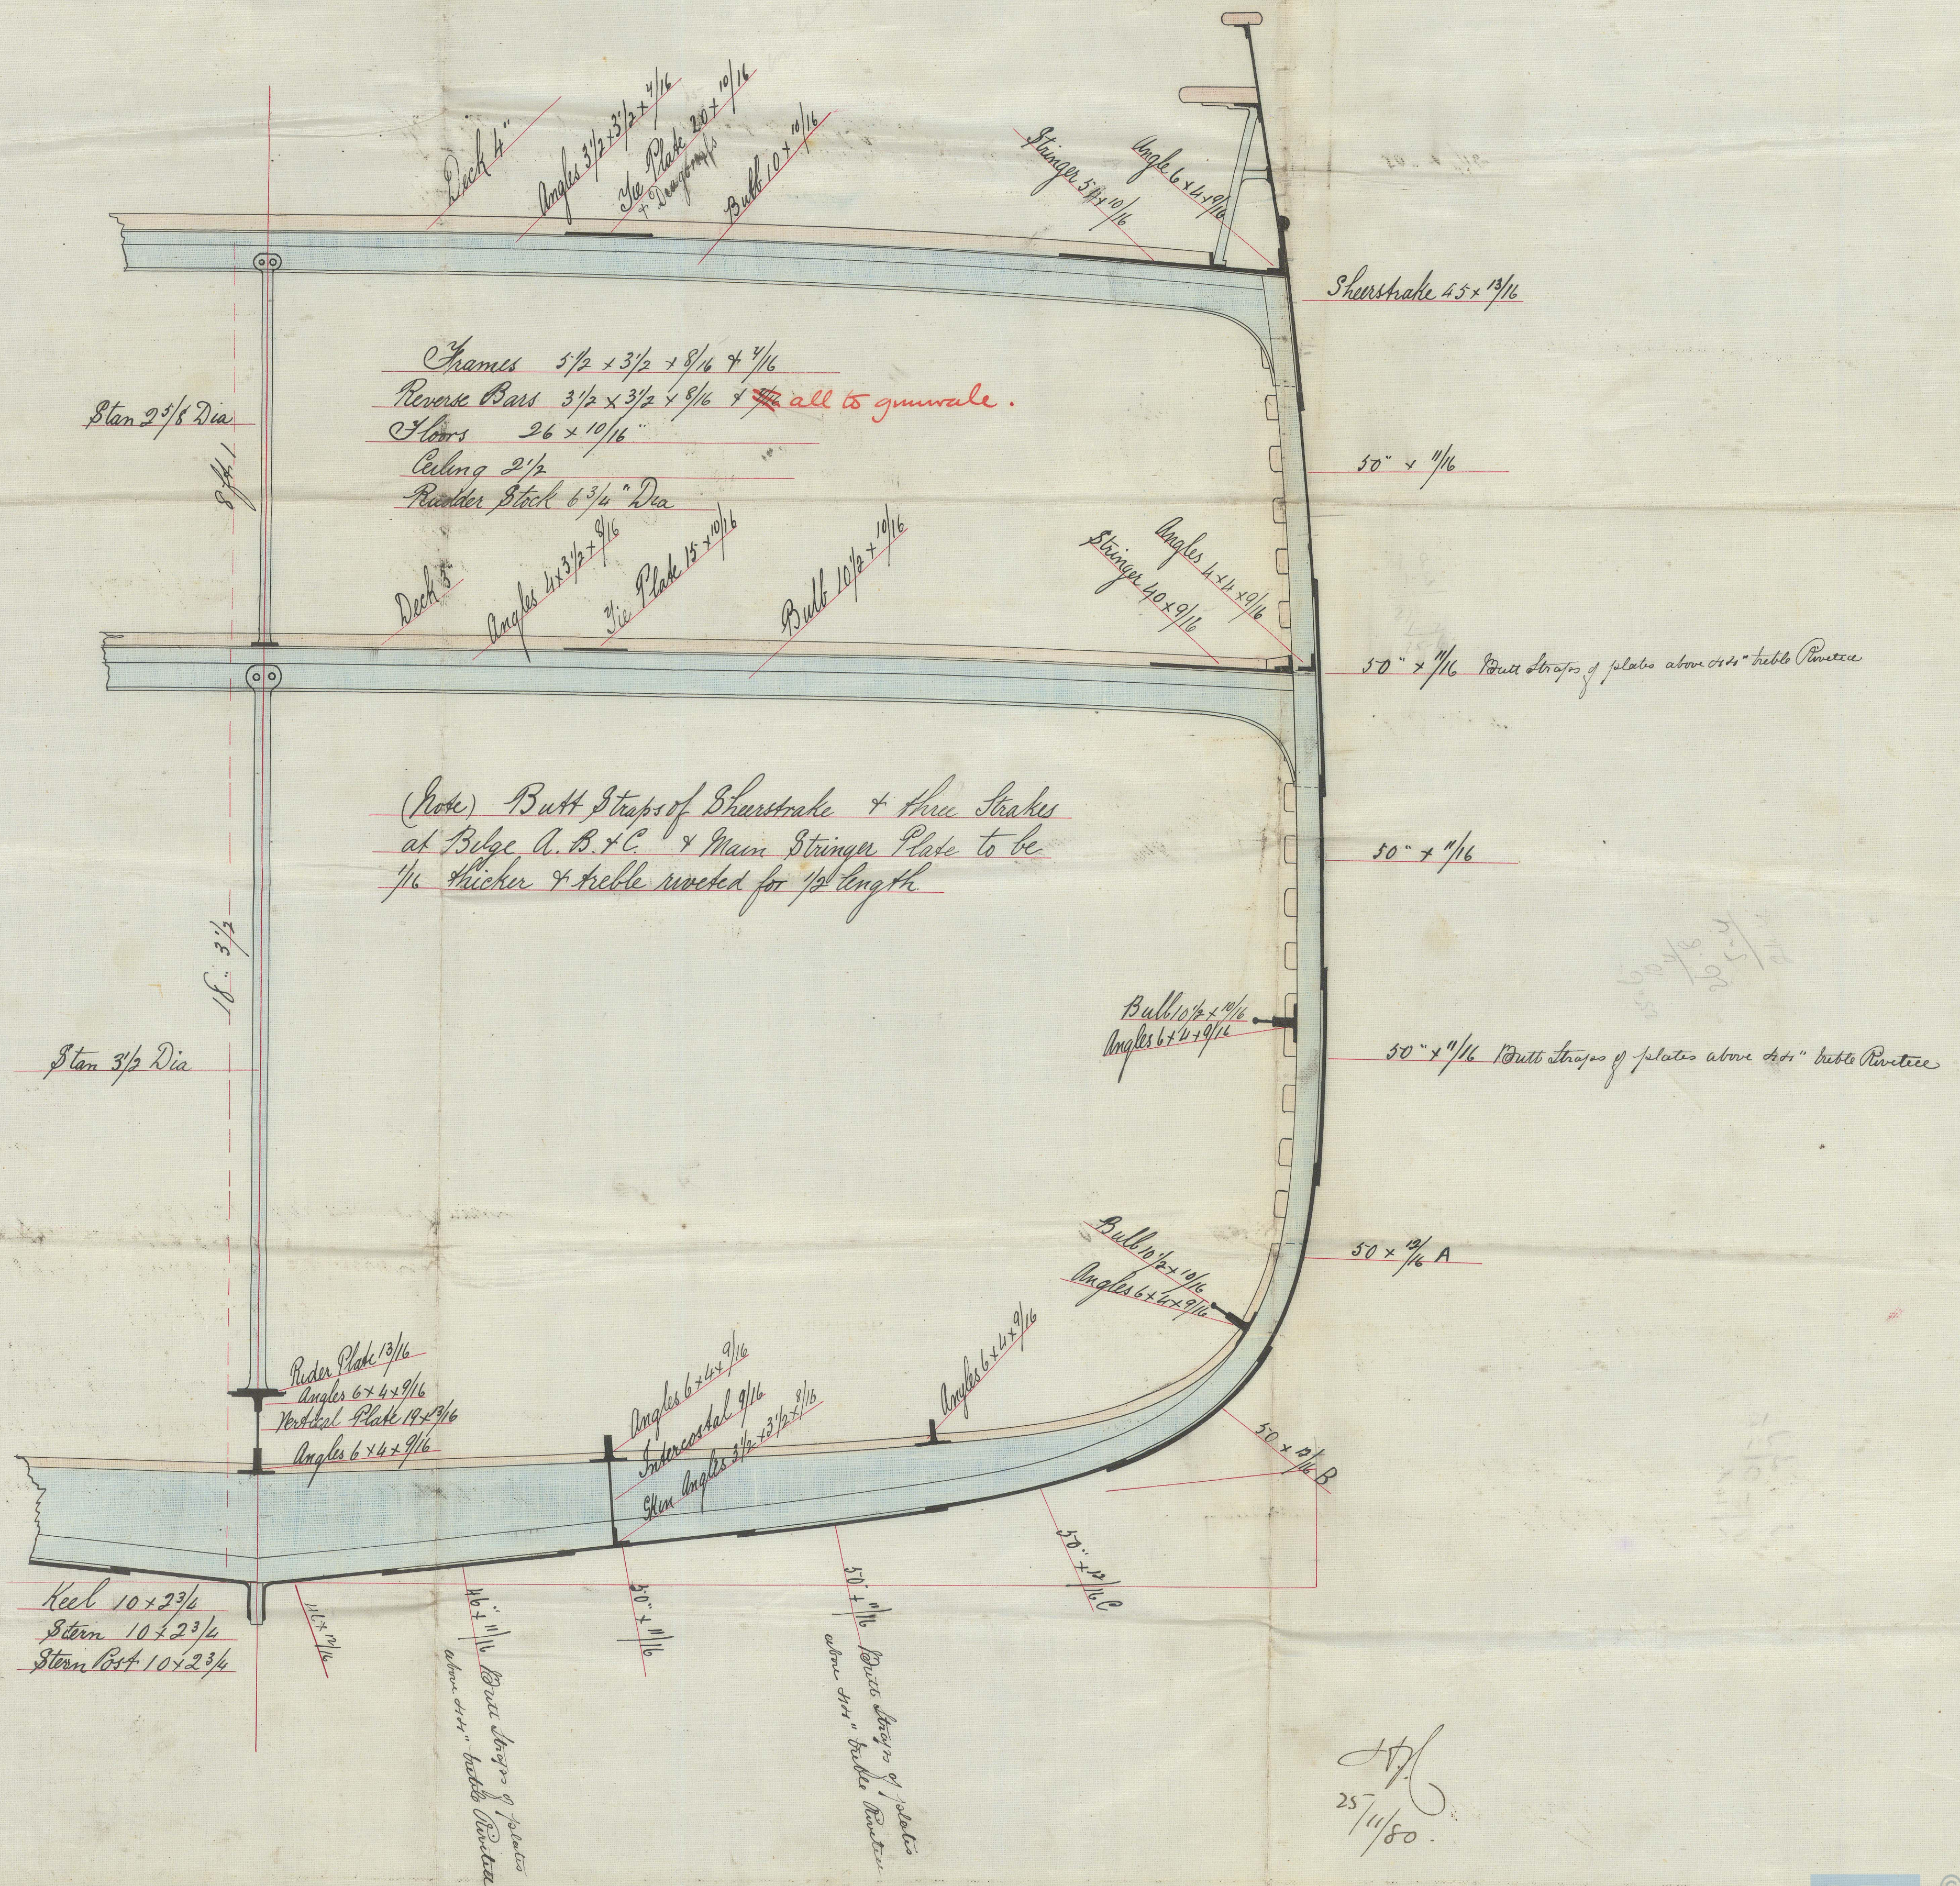

25-
11/80.