


28.2.81

rearrangement of the
Sketch shewing top of water ballast tank and connection at bilge

N^o 18 19

SCALE 1" INCH TO 1 FOOT

Tibor
5444
5 x 3 1/2 x 9/16

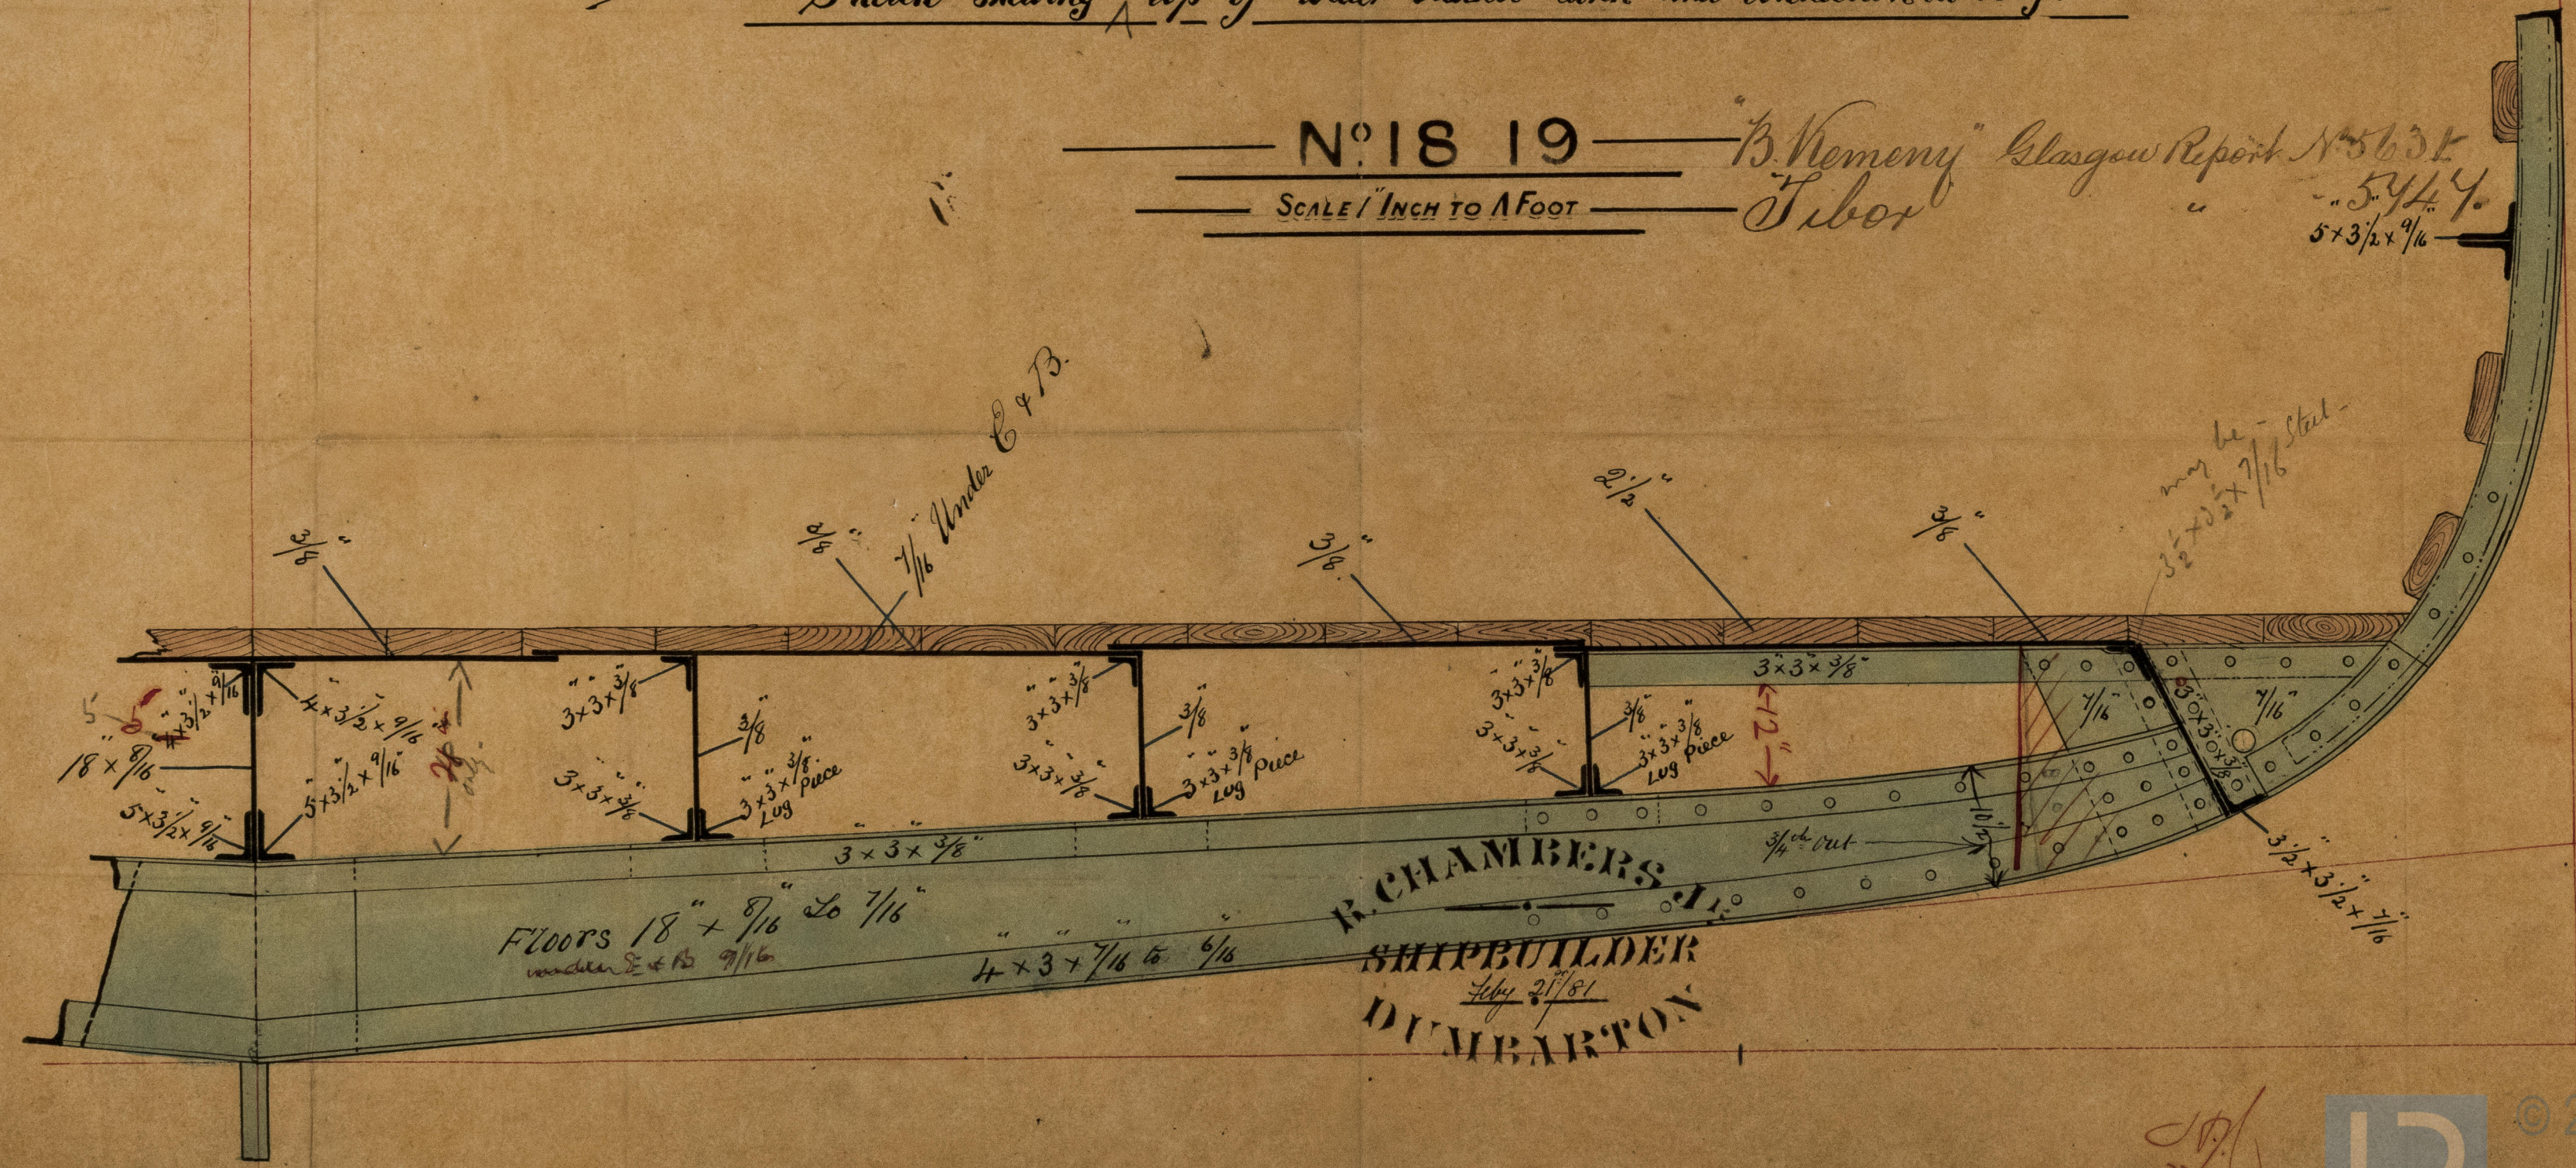

R. CHAMBERS
SHIPBUILDER
Feb 21/81

23/2/81



© 2021
Lloyd's Register
Foundation
GLS190-0038

8300-0121