


Fore Mast 72'-6" Overall.


S. S's N^{os} 18-19.

"B. Kemény" Glasgow Report 5631.
"Sibor" " 5747.

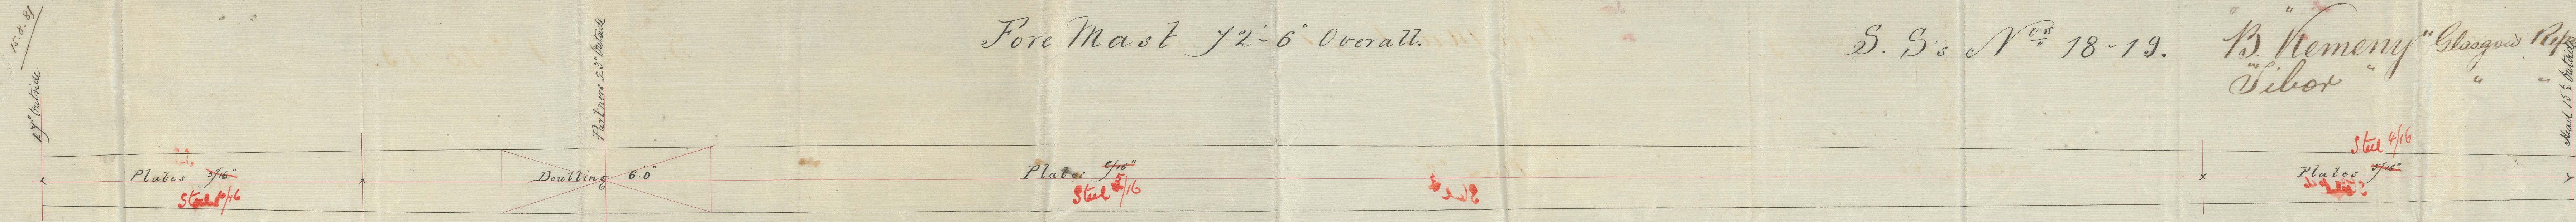


Main Mast 64'-0" Overall.

Section of Fore & Main Masts.

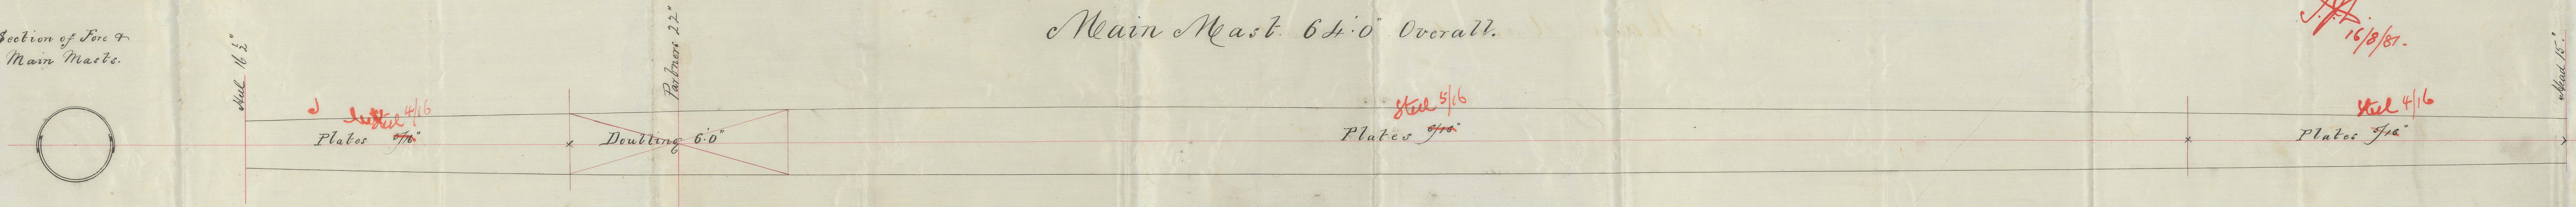


Steel Fore Yard 55'-0" Overall.

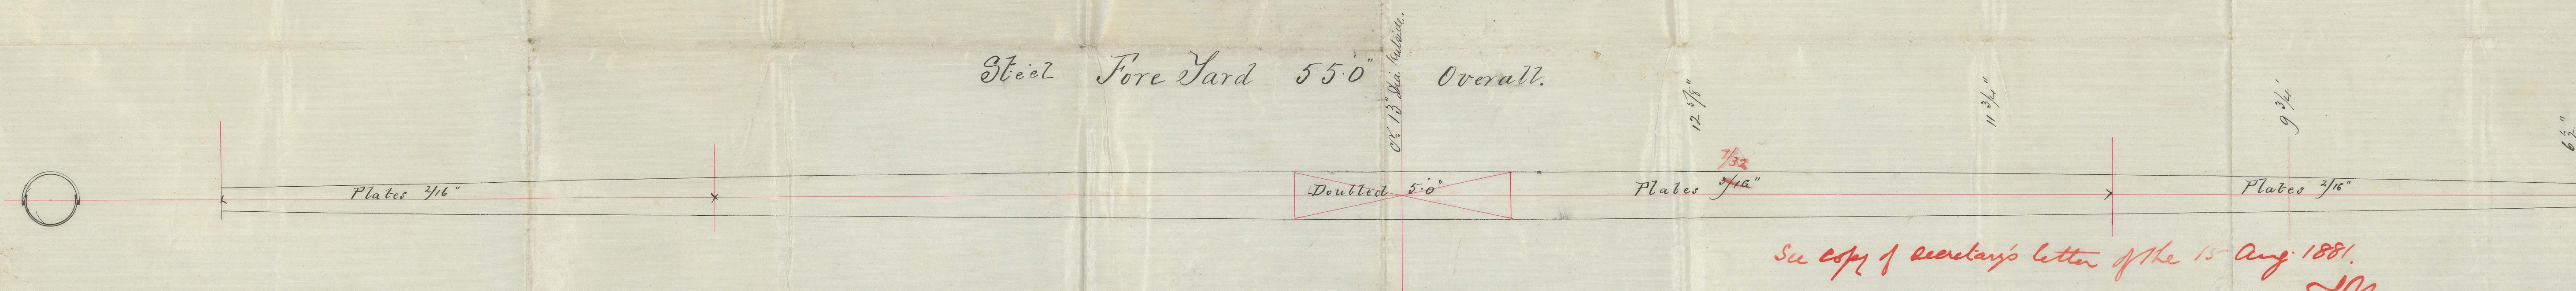

Russell & Son
Lawn Wood Yard
Dumfries.

B. Kemény


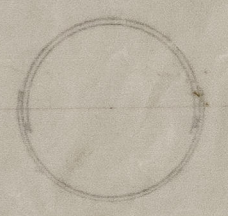











