

N^o 18 and 19 Midship Section


B. Komony Glasgow Report 5631.
Tibor 5444

$\frac{1}{2}$ Birth 31.9
 $\frac{1}{2}$ Breadth 17.3
Depth 8.75

$67.95 \times 243.66 = 16556.6$ Plating
~~16556.6~~ Equipment
18212.2

$\frac{L}{D} = 12.99$

$\frac{L}{B} = 7.3$

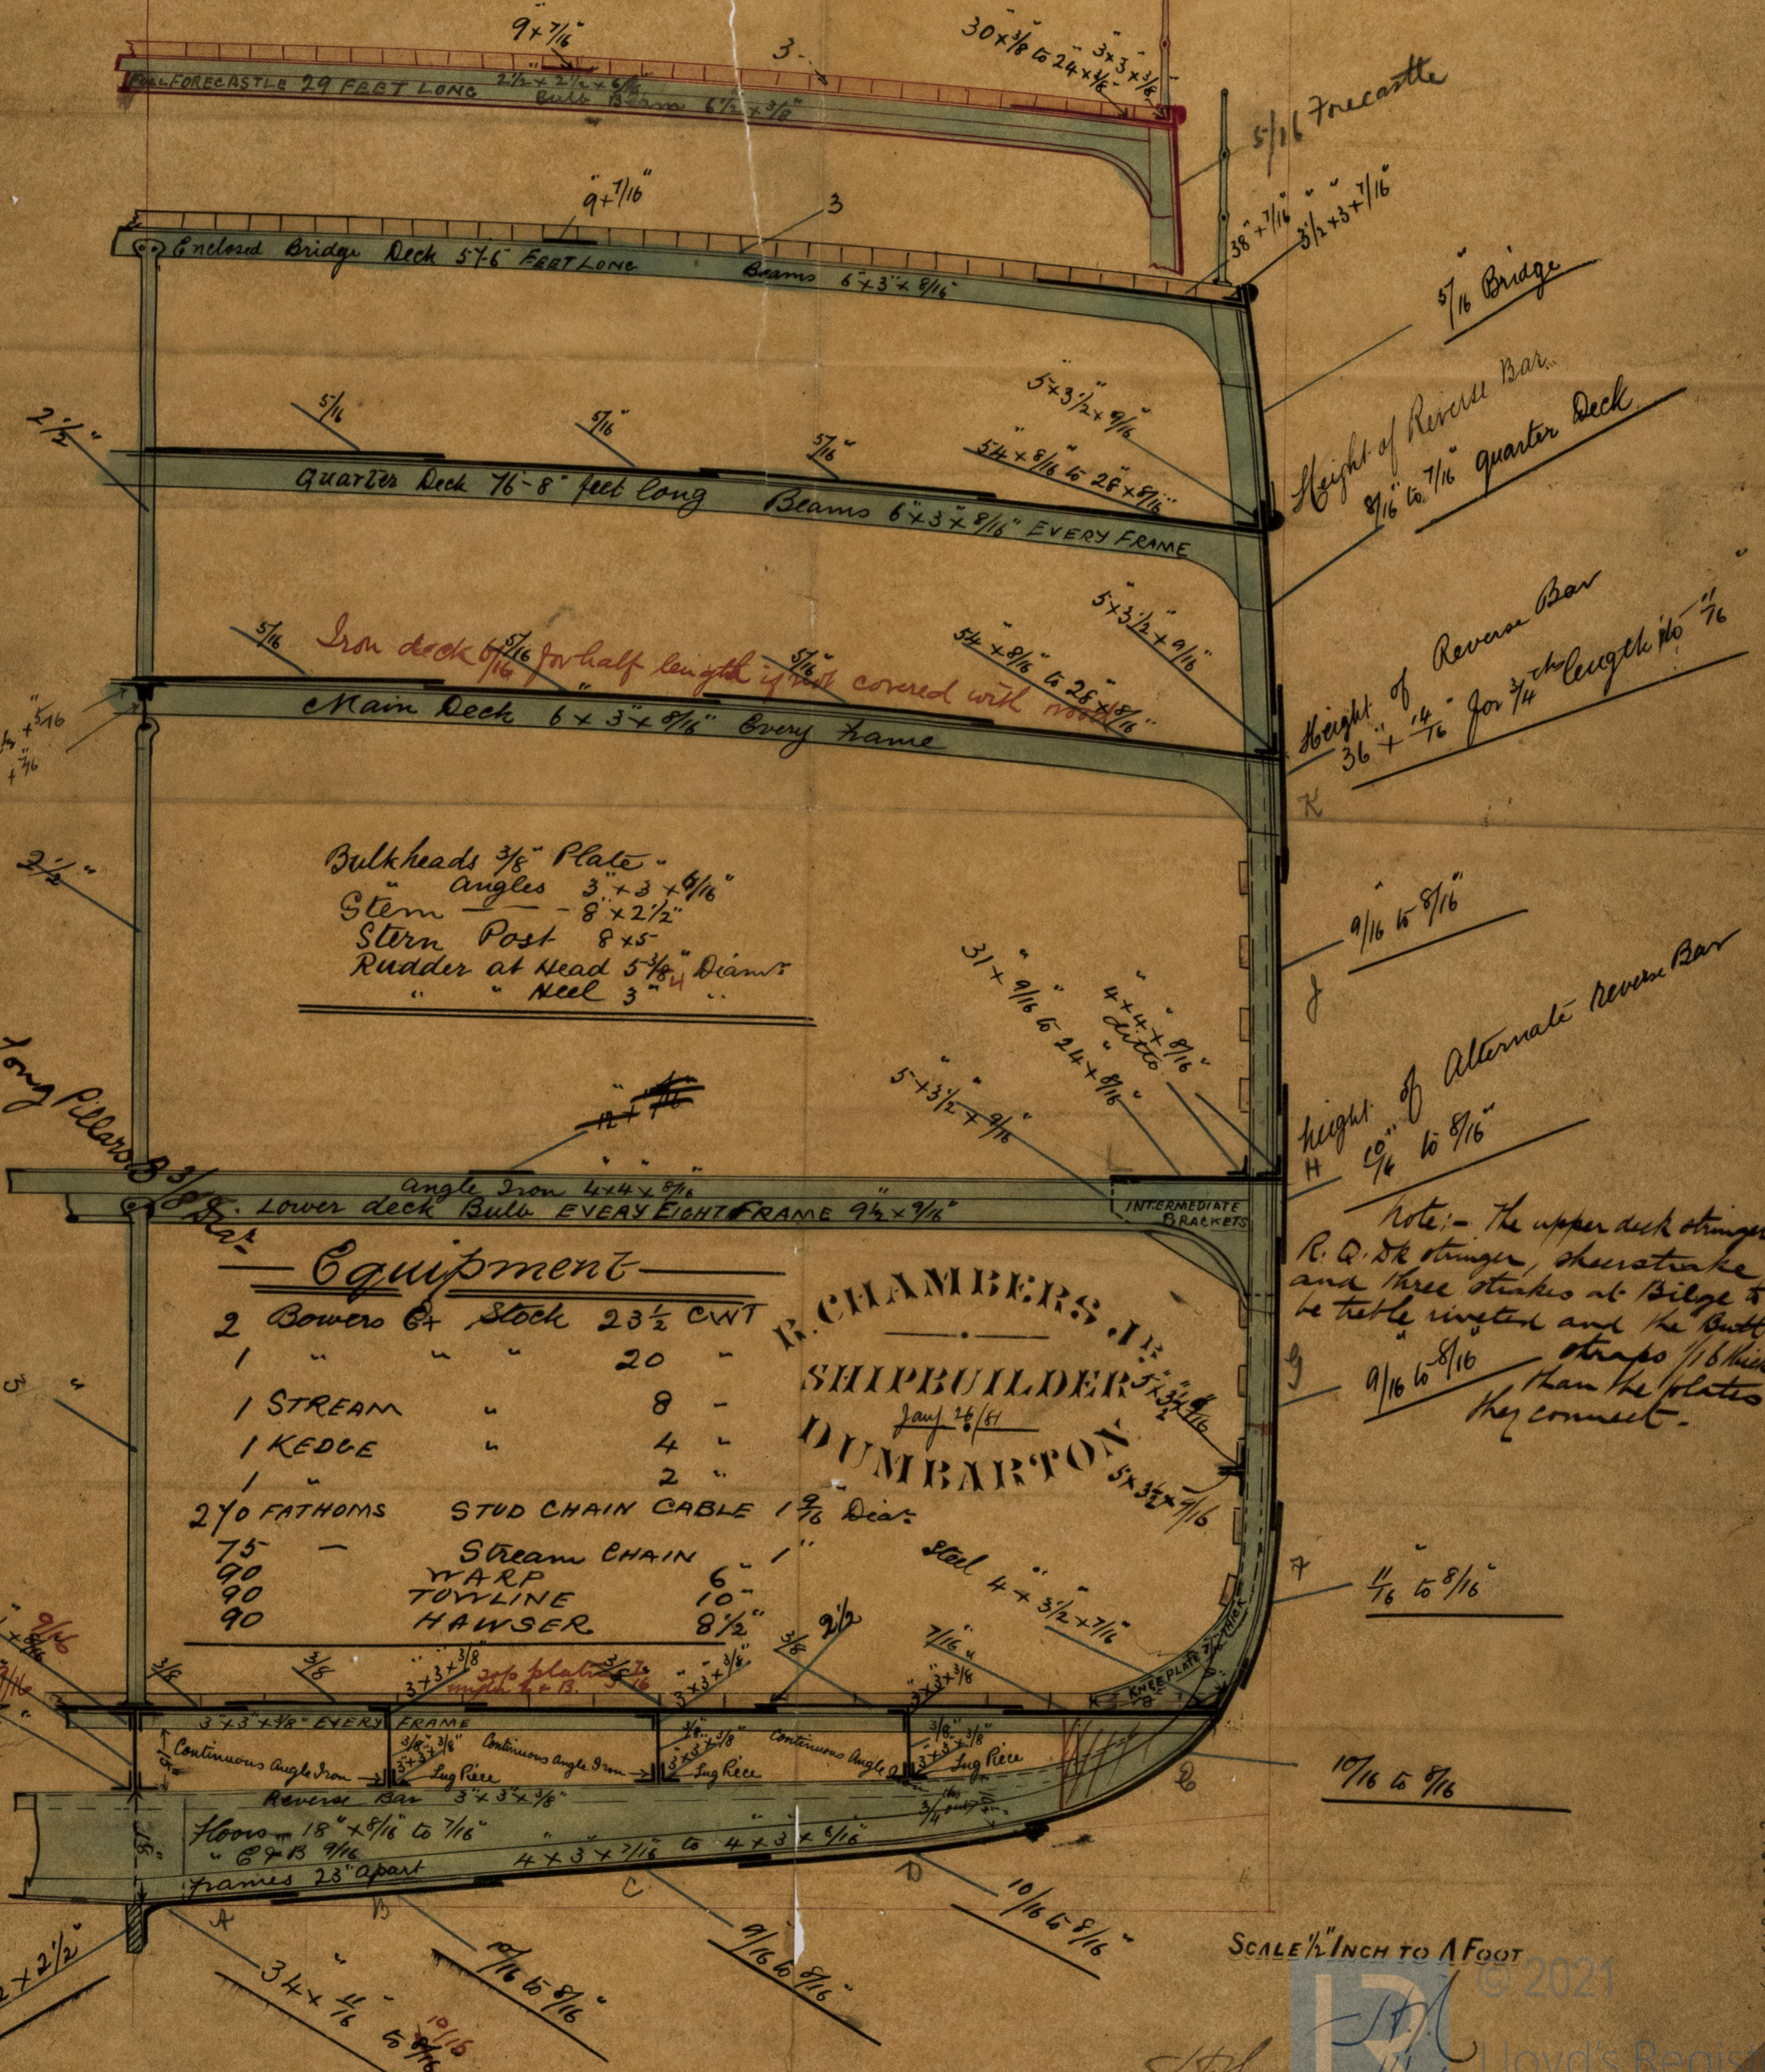

