

S. S. "Wairarapa" Glasgow Report No 5765


5.7.81

Sketch showing Upper deck beams & plating

No 259

Scale $\frac{1}{2}'' = 1 \text{ foot}$

Steel scantlings in Blue

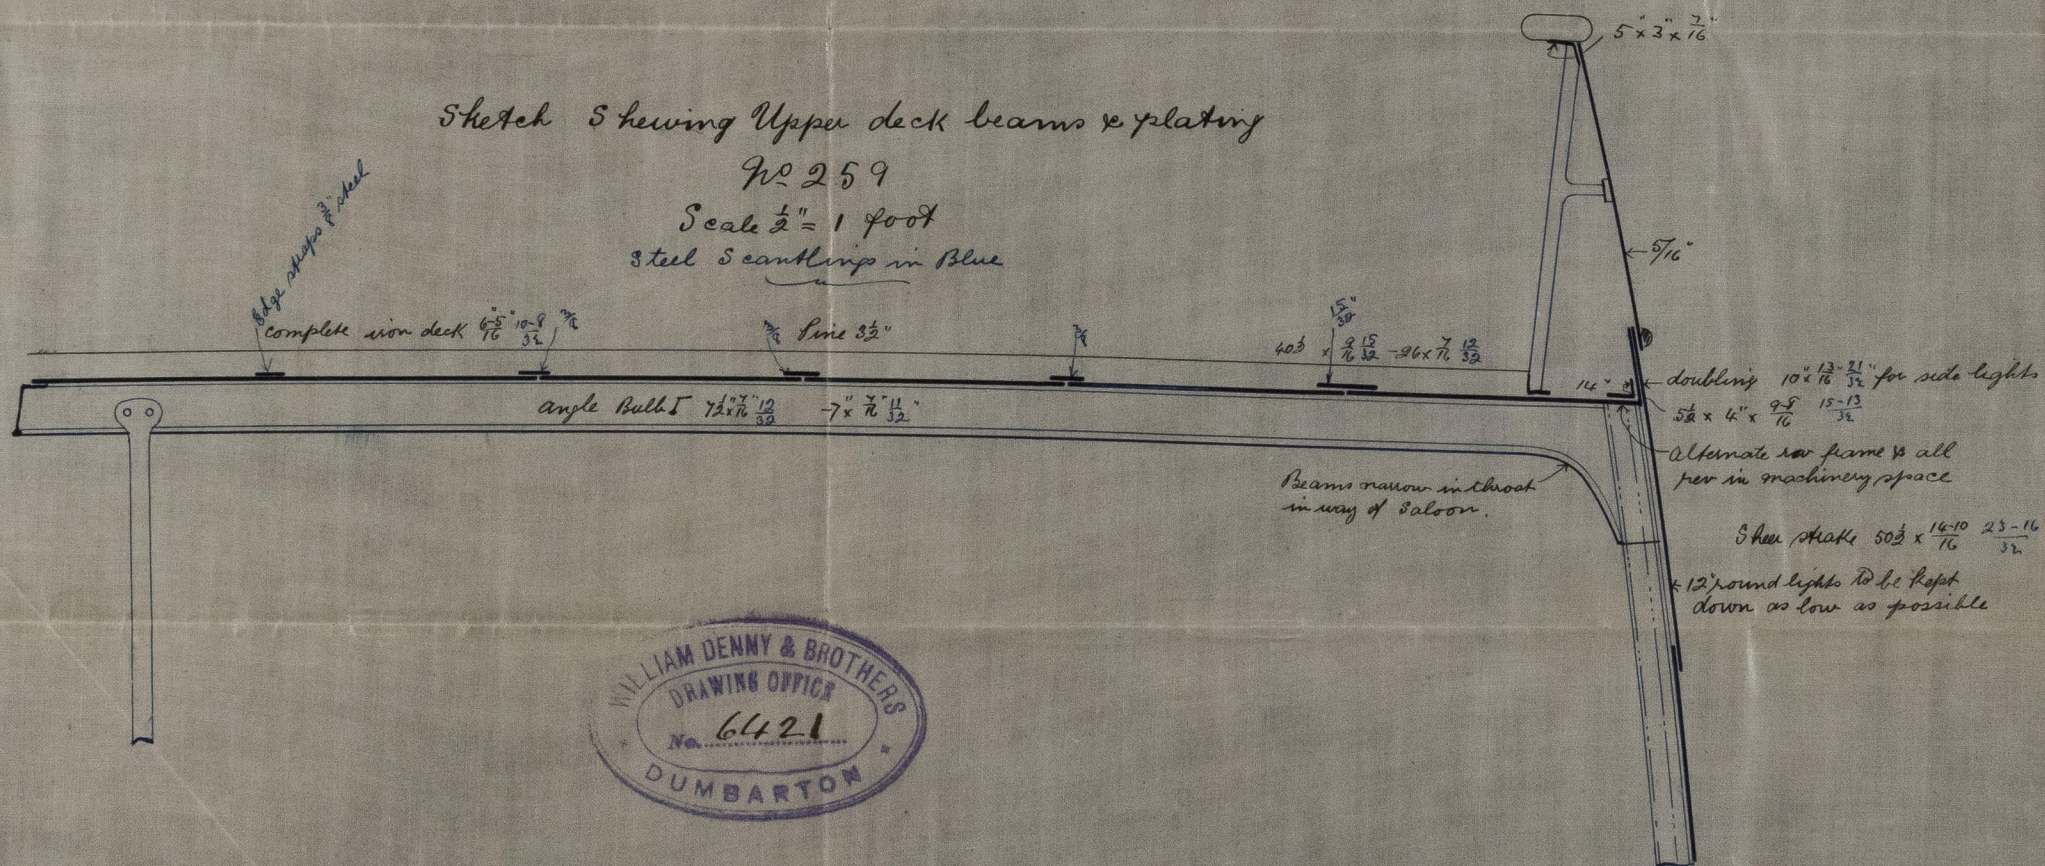

© 2021

Lloyd's Register
Foundation

GLS190-0064