


2/2/80

S.S. Manapouri Glasgow Report No 5652.  
S.S. "Wairarapa" Do Do No 5765

CENTRE KEELSONS


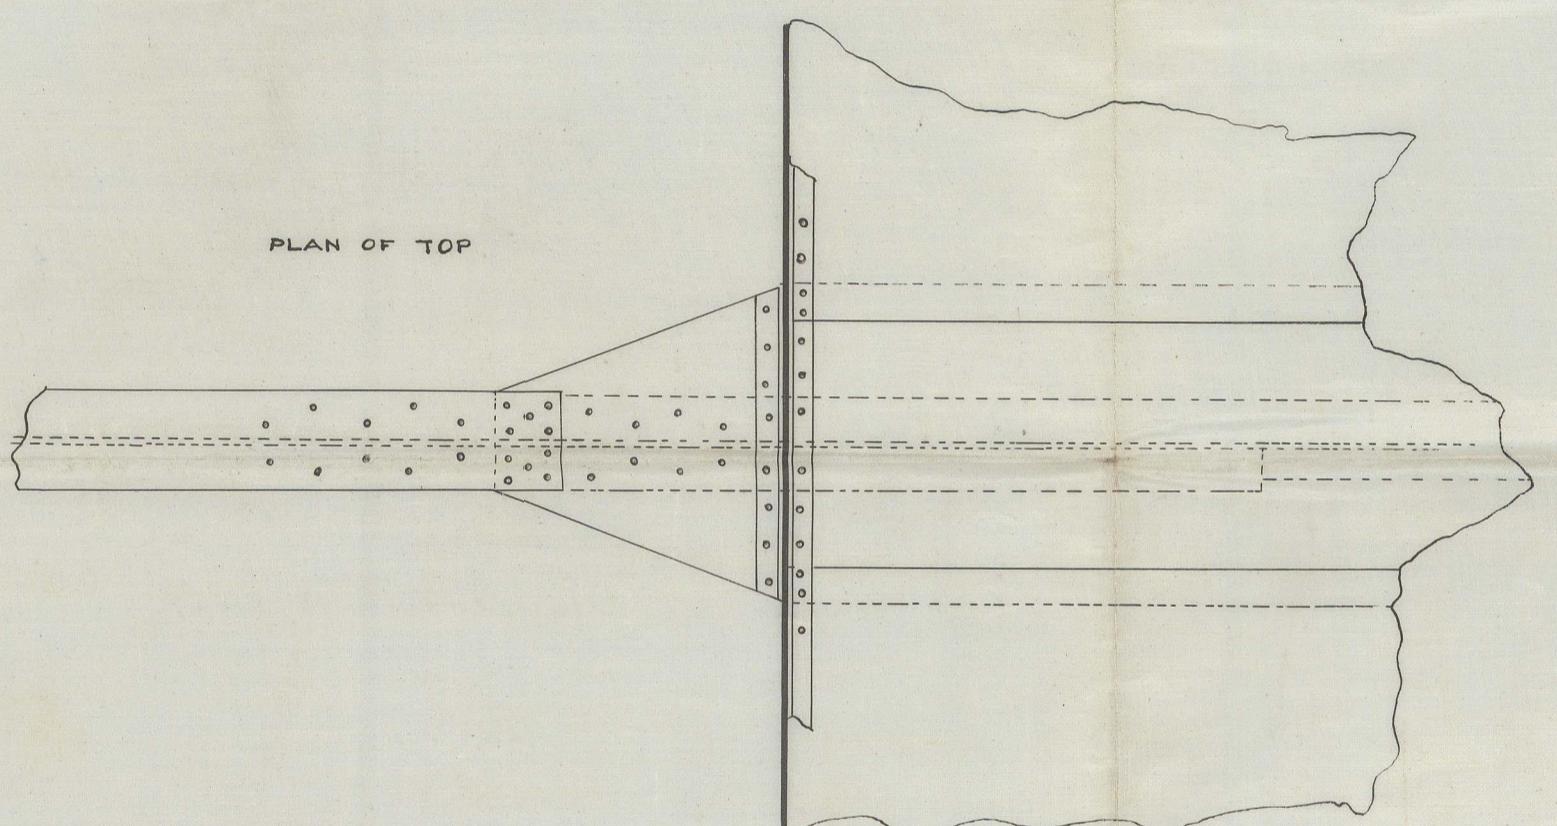


PLAN OF TOP

SKETCH SHOWING SCARPH OF  
ORDINARY FLOOR IN-TO DOUBLE BOTTOM

N° 252

SCALE  $\frac{1}{2}$ =1FOOT

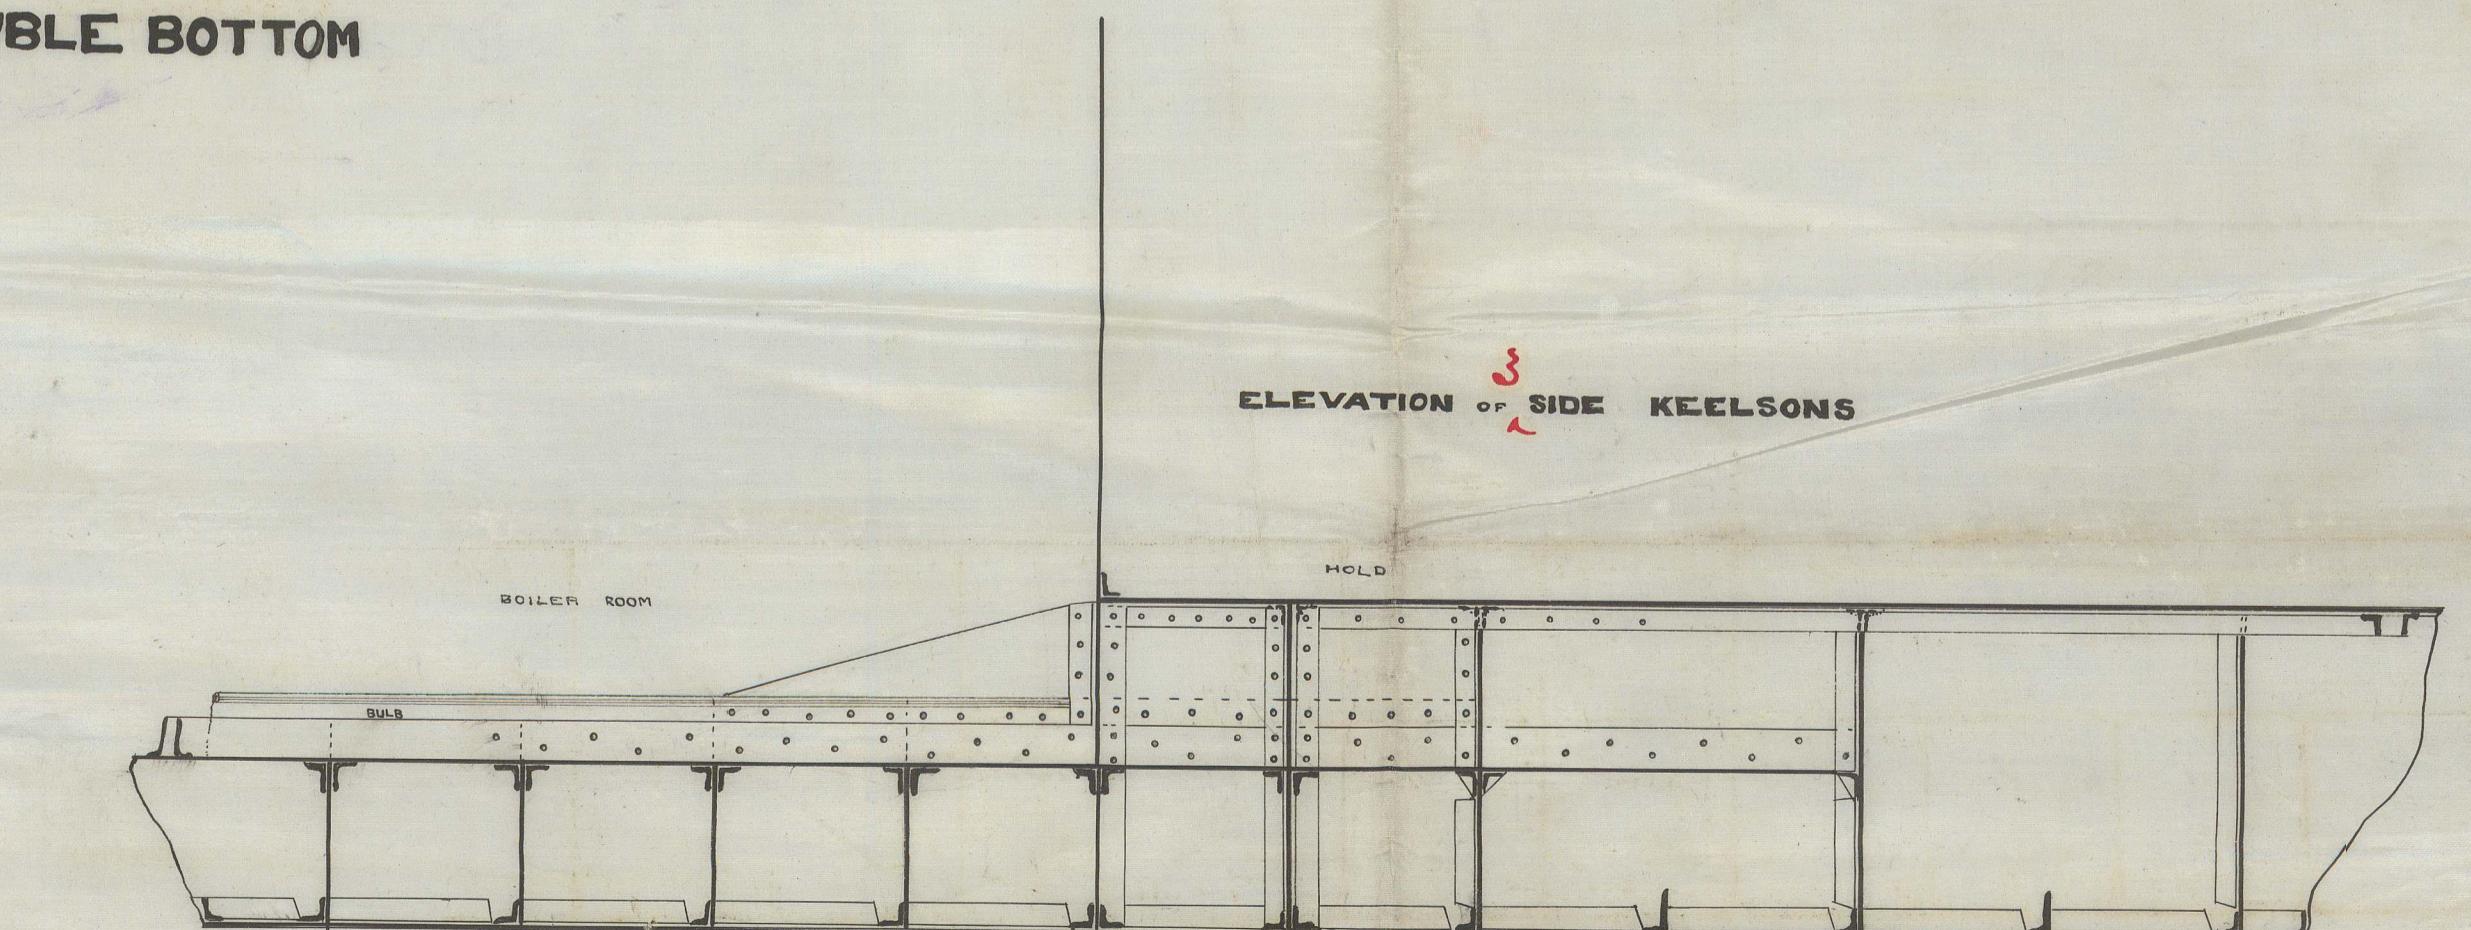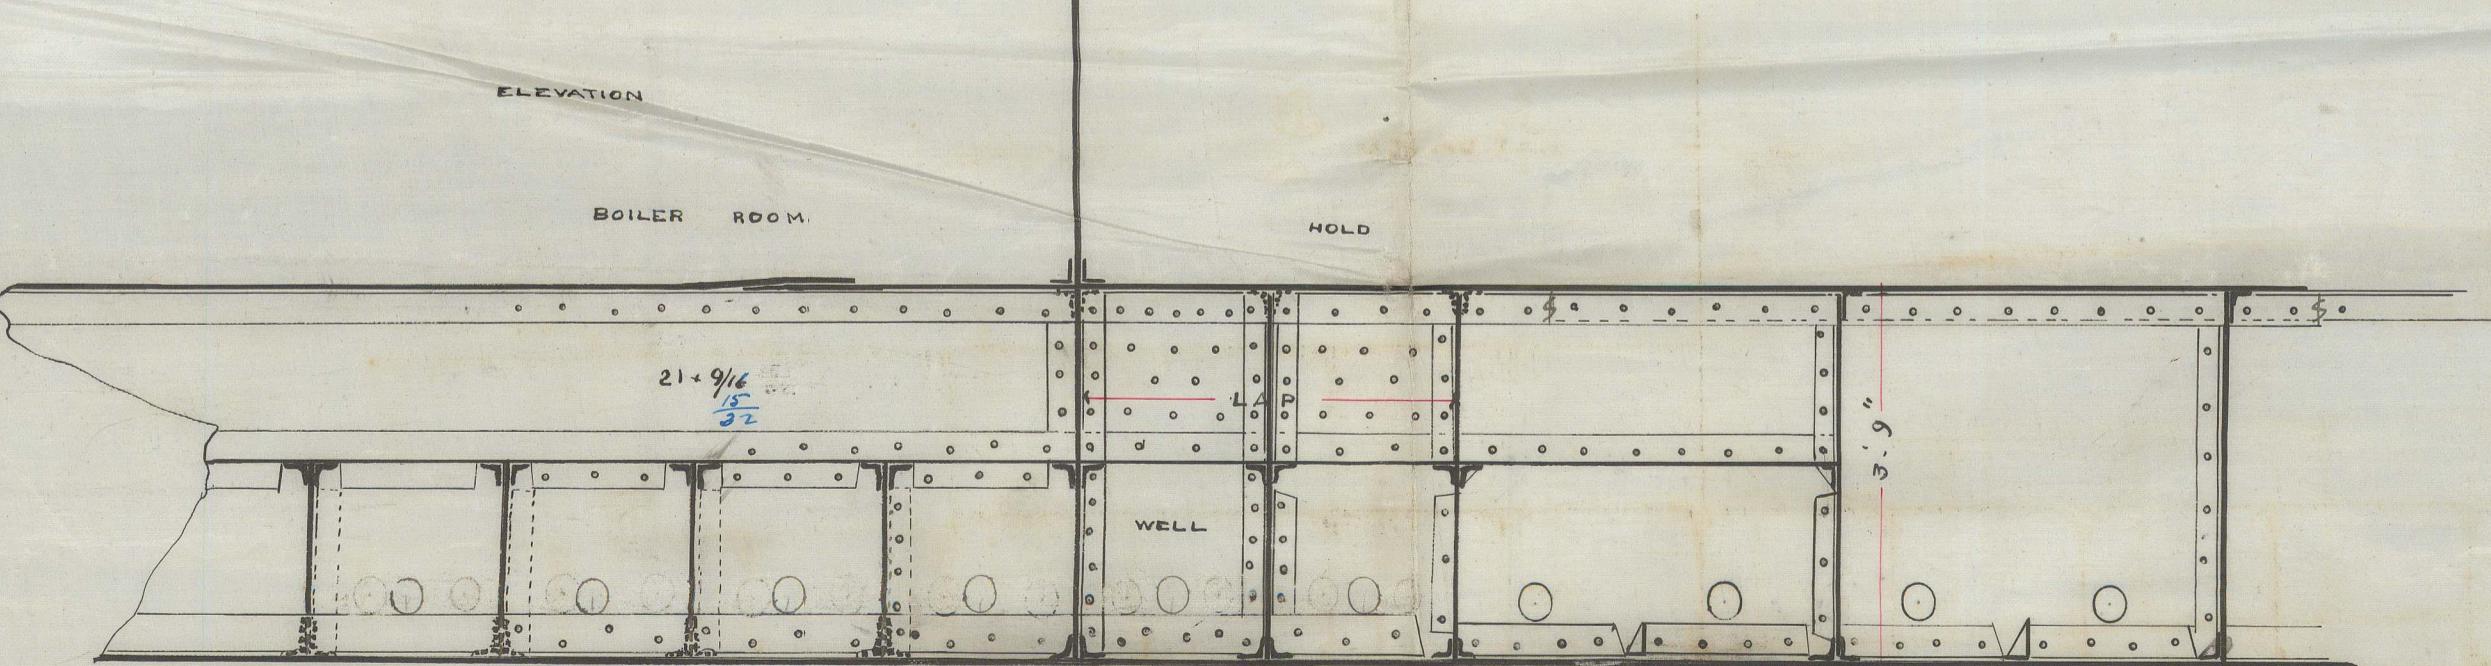

2/2/80



© 2021

Lloyd's Register  
Foundation

2200-091213

GLS190-0066