


2.12.80



S. S. No 252

Scale $\frac{1}{4}$ inch = 1 foot

S. S. "Manapouri" Glasgow Report No 5654
S. S. "Wairarapa" Do. No 5765

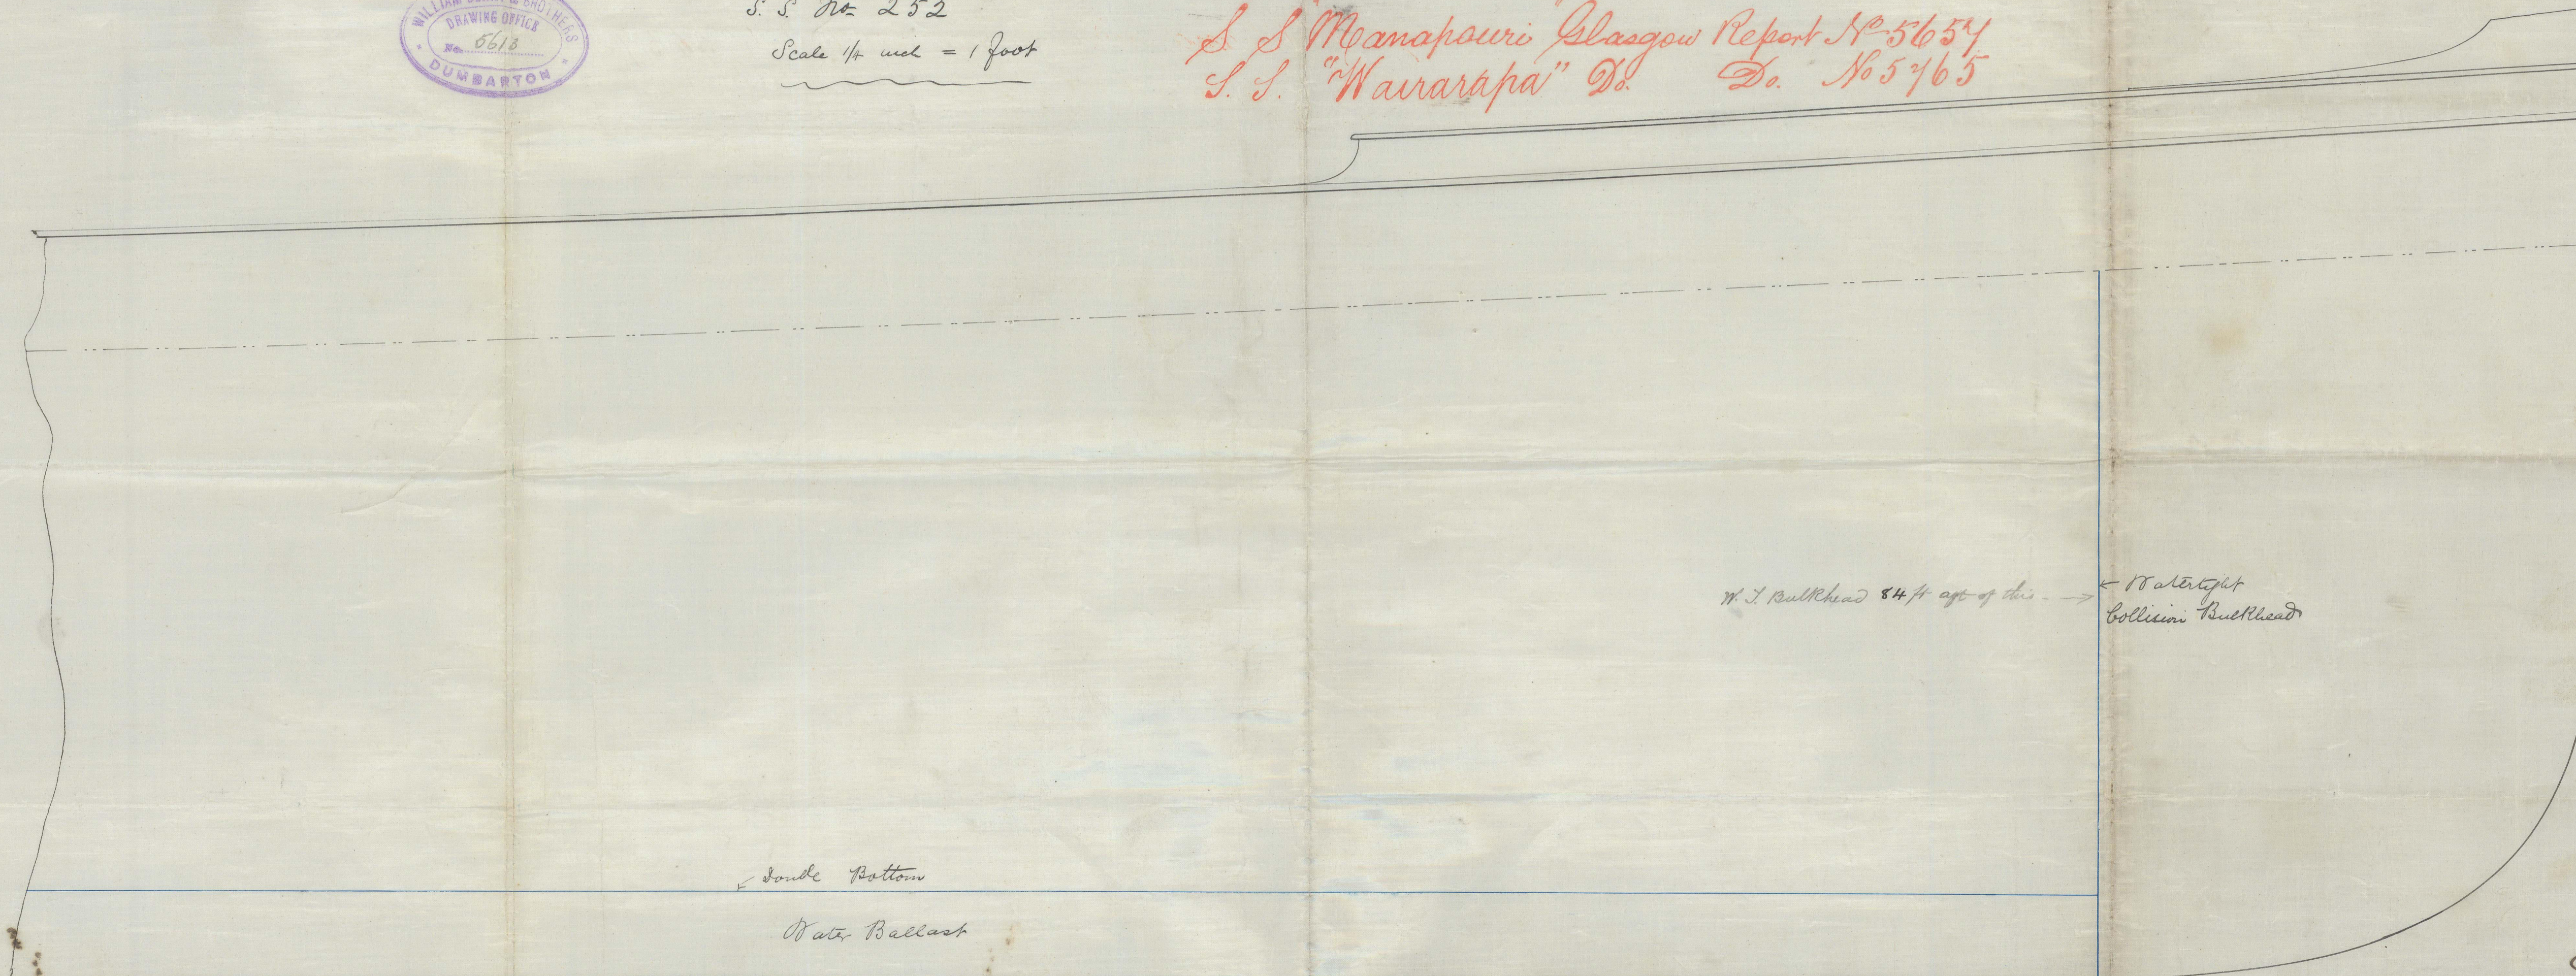

W. T. Bulkhead 84 ft aft of this → 10 vertical Collision Bulkhead

Double Bottom

Water Ballast

W.D.
2/12/80
R