
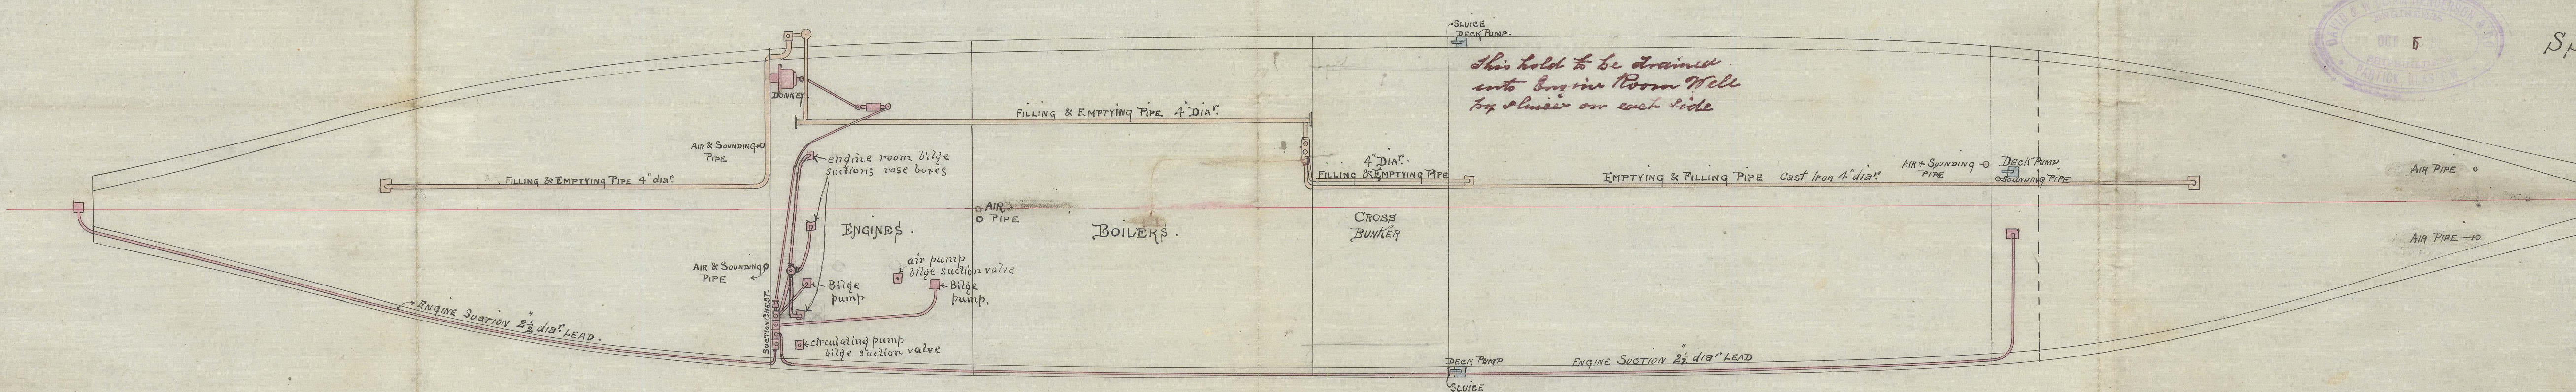


L & Gls:  
 11/10/81  
 See sketch dated 26.10.81

S. S. "Birksgate" Glasgow Report No 5663

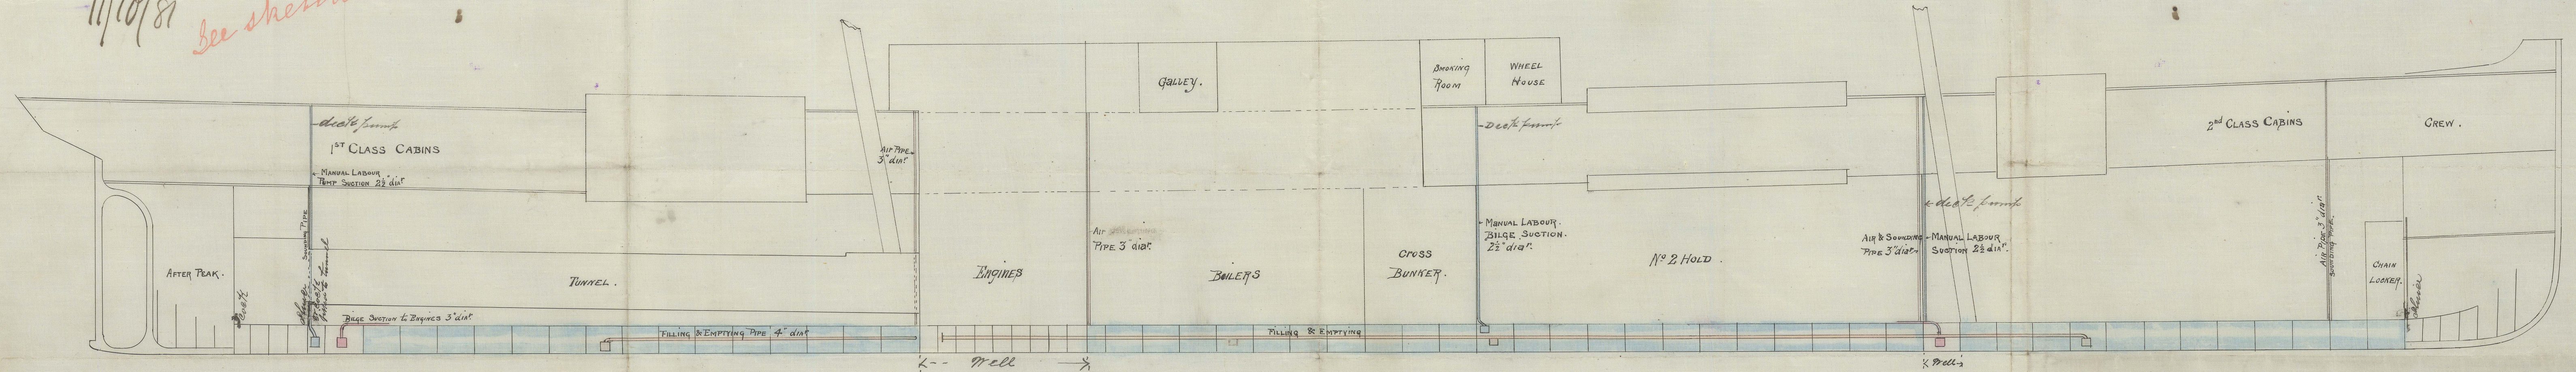

DAVID & WILLIAM HENDERSON & CO.  
 ENGINEERS  
 OCT 6 81  
 SHIPBUILDERS  
 PARTICK, GLASGOW

DAVID & WILLIAM HENDERSON & CO.  
 ENGINEERS  
 OCT 5 81  
 SHIPBUILDERS  
 PARTICK, GLASGOW

Raising Plan  
 S. S. BIRKSGATE No 222  
 Scale 1/2" = 1 foot

11/10/81