



S.S. "Birksgate" Glasgow Report No. 5663.

P500-0F12JN

Spar Deck.

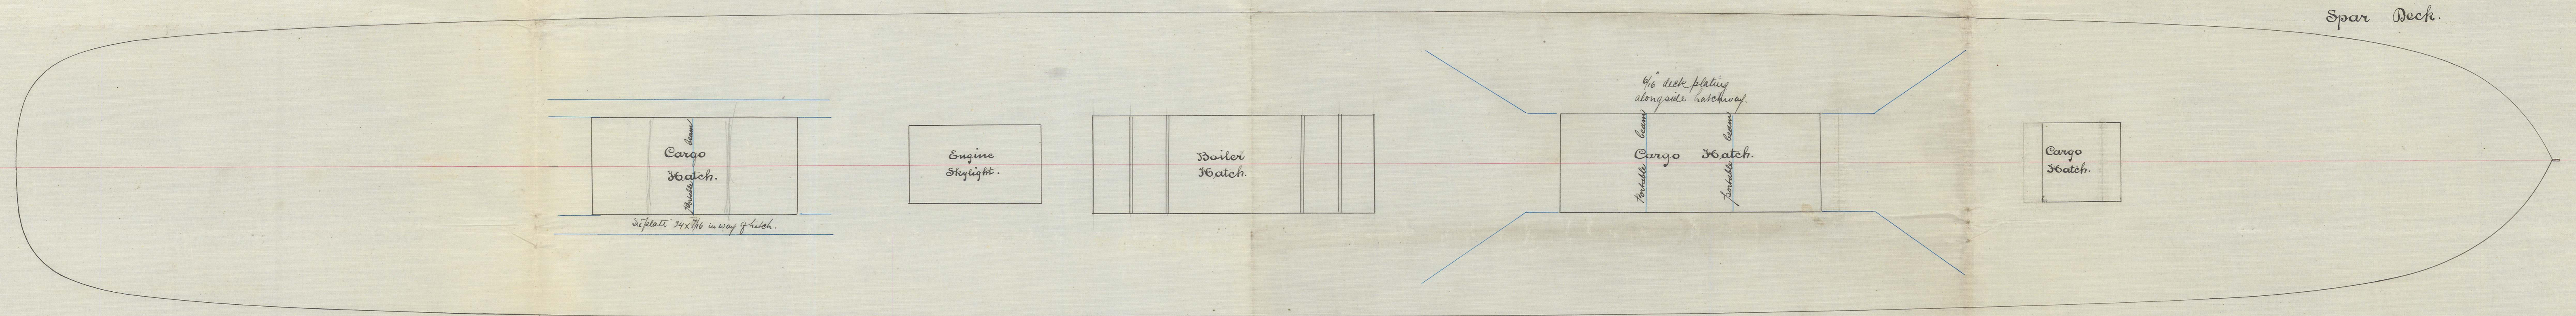


Main Deck.

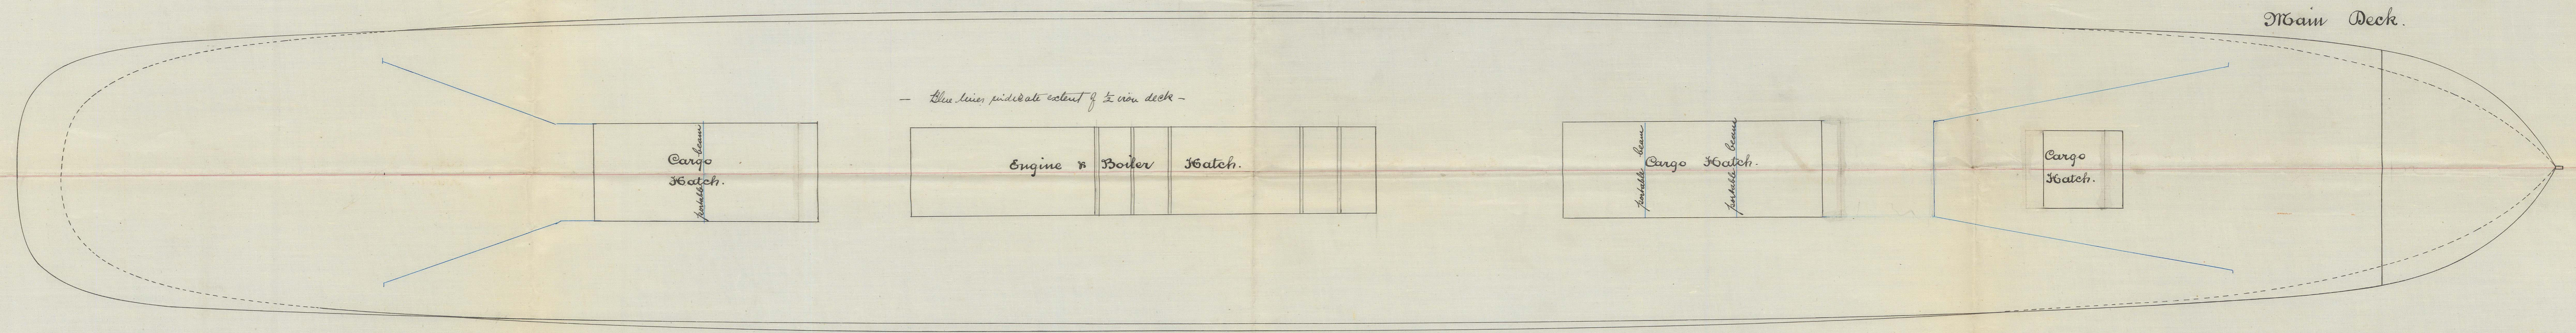

- S.S. No 222. -
- 255'-0" x 33'-0" x 15'-0" hold. -
- Scale 1/8" = One foot. -



Longitudinal Section.

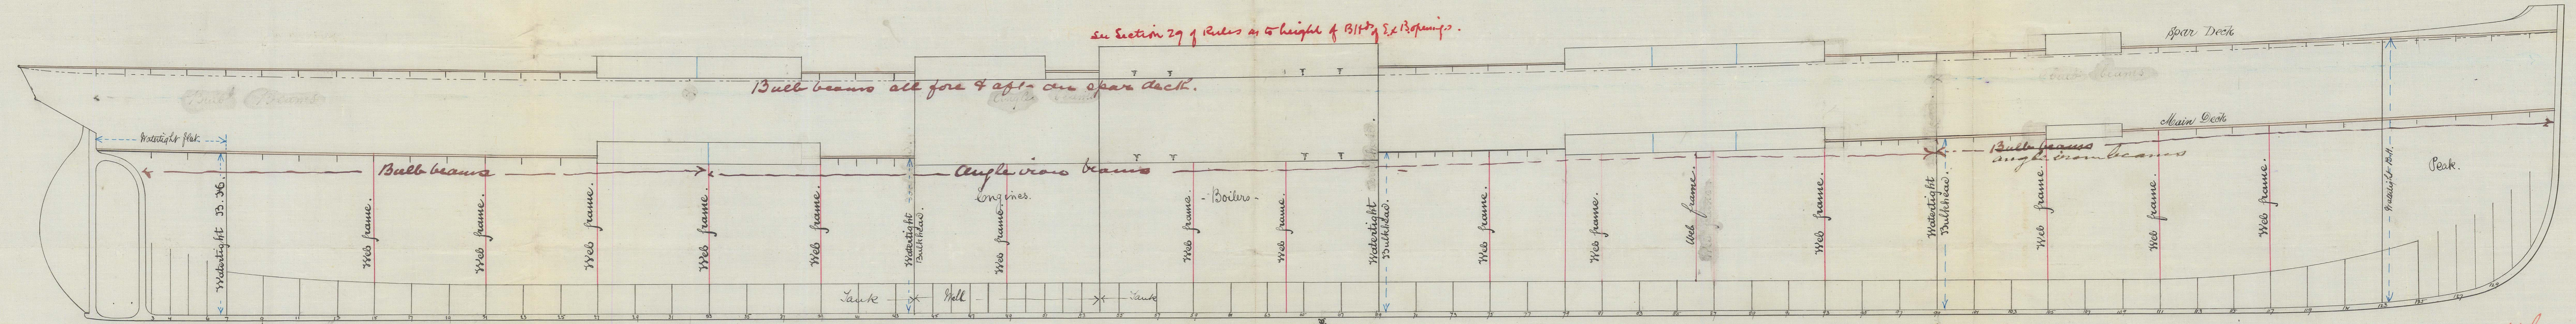

B.M.

GLS 190-0089