




Let to Gls.
47/10/81

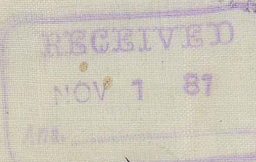

0900-01234

S. S. "Birksgate" Glasgow Report
No. 5663

M
26.10.81

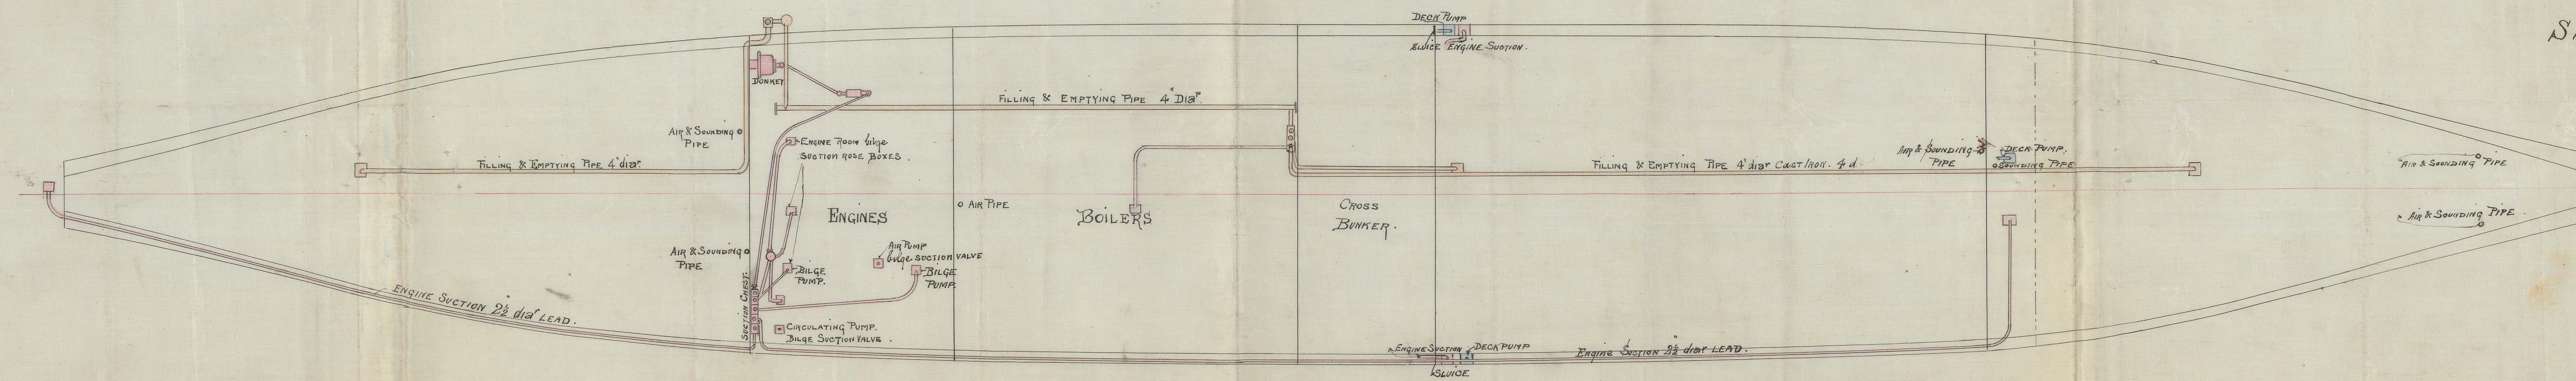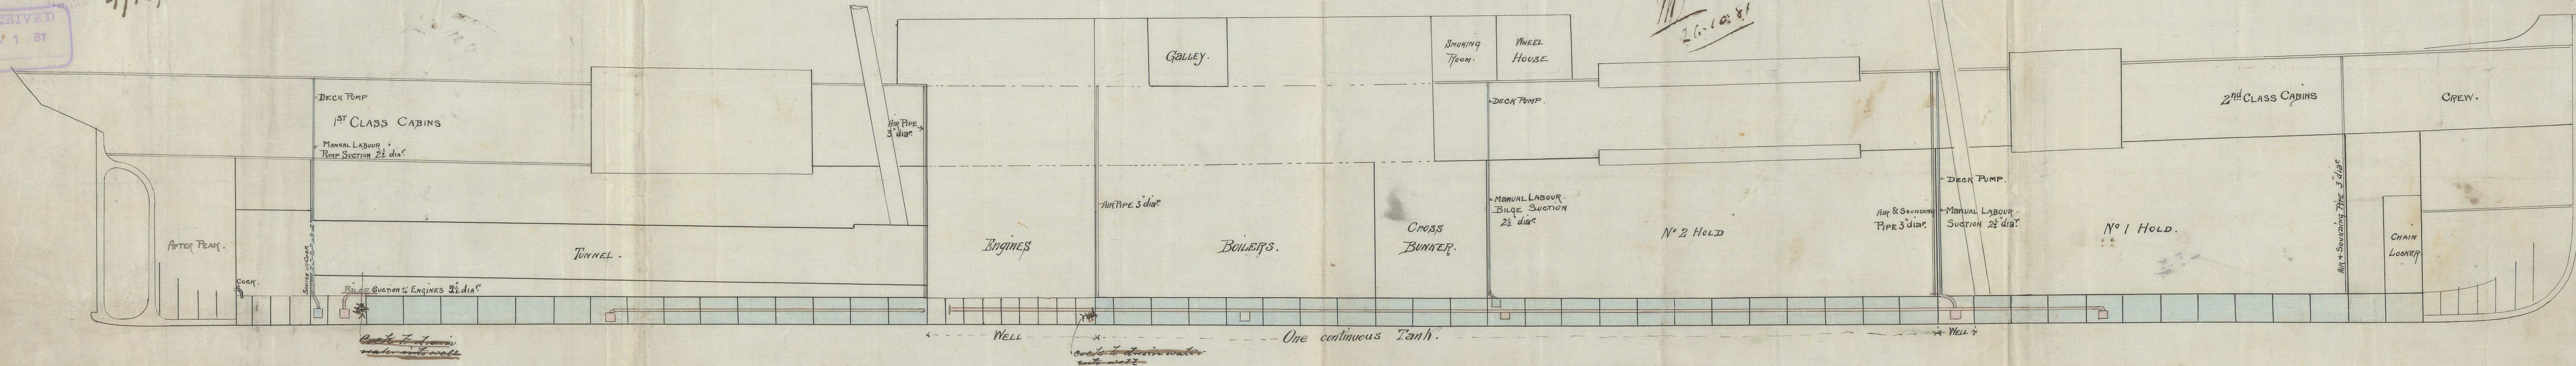

PIPING PLAN.
S. S. BIRKSGATE No. 222
Scale ½" = 1 Foot.



© 2021
Lloyd's Register
Foundation