



DECK PLATING AMIDSHIPS

T.S. N° 253

SCALE 1/4" = 1 FOOT.

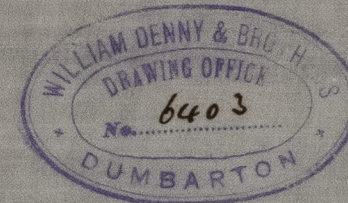

S.S. "Mahinapua"
Glasgow Report
No. 5648

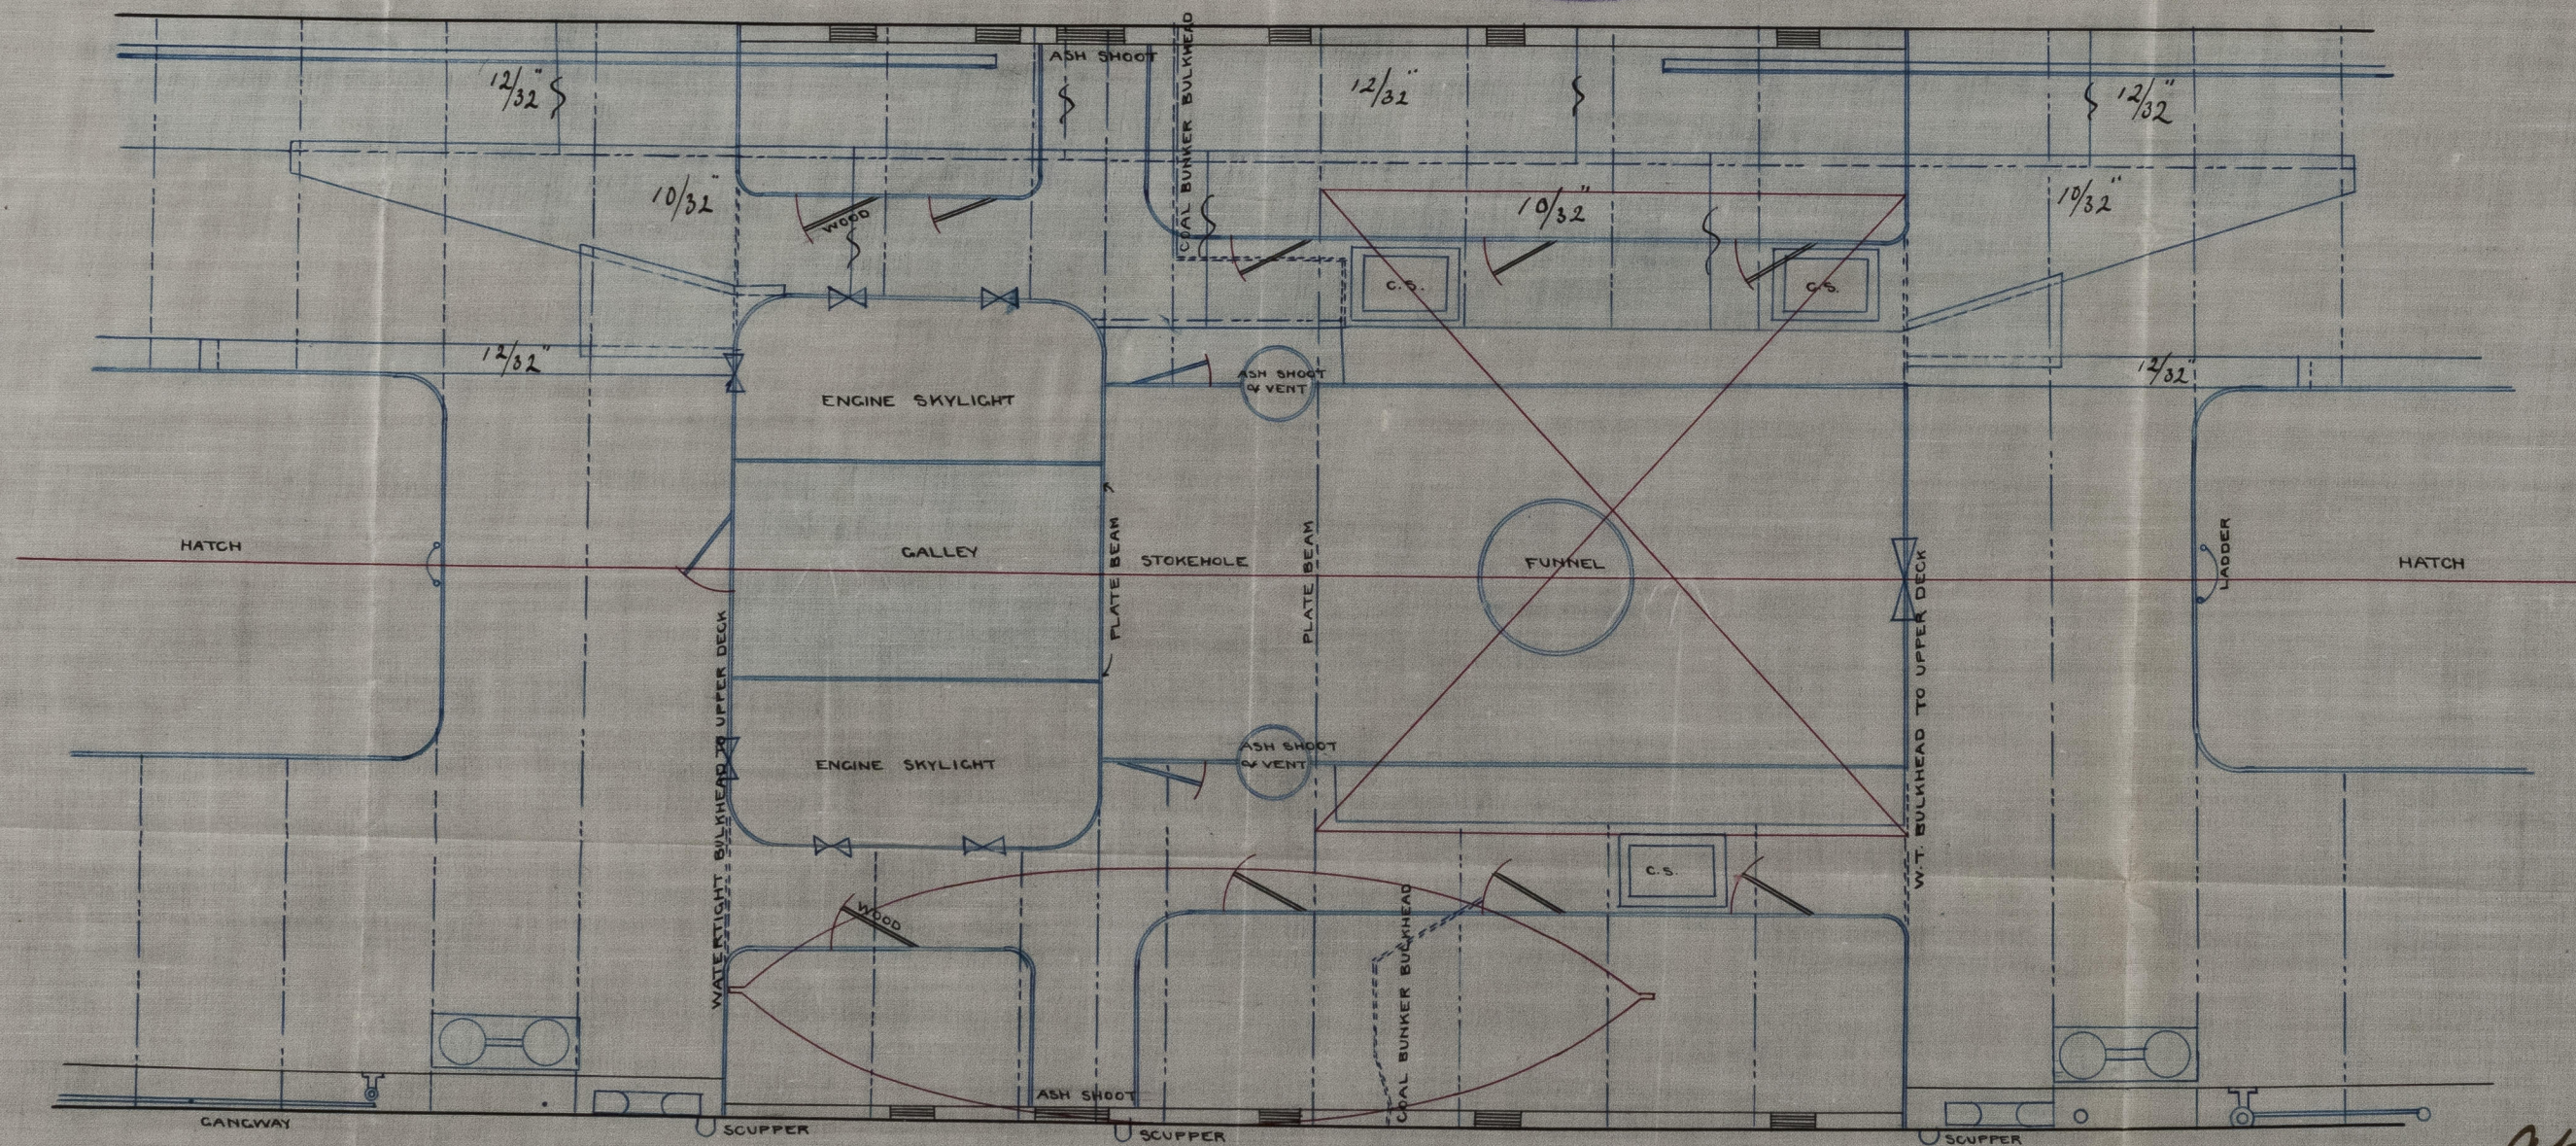

Approved

30/6/07.
Lloyd's Register
Foundation

GLS190-0097