
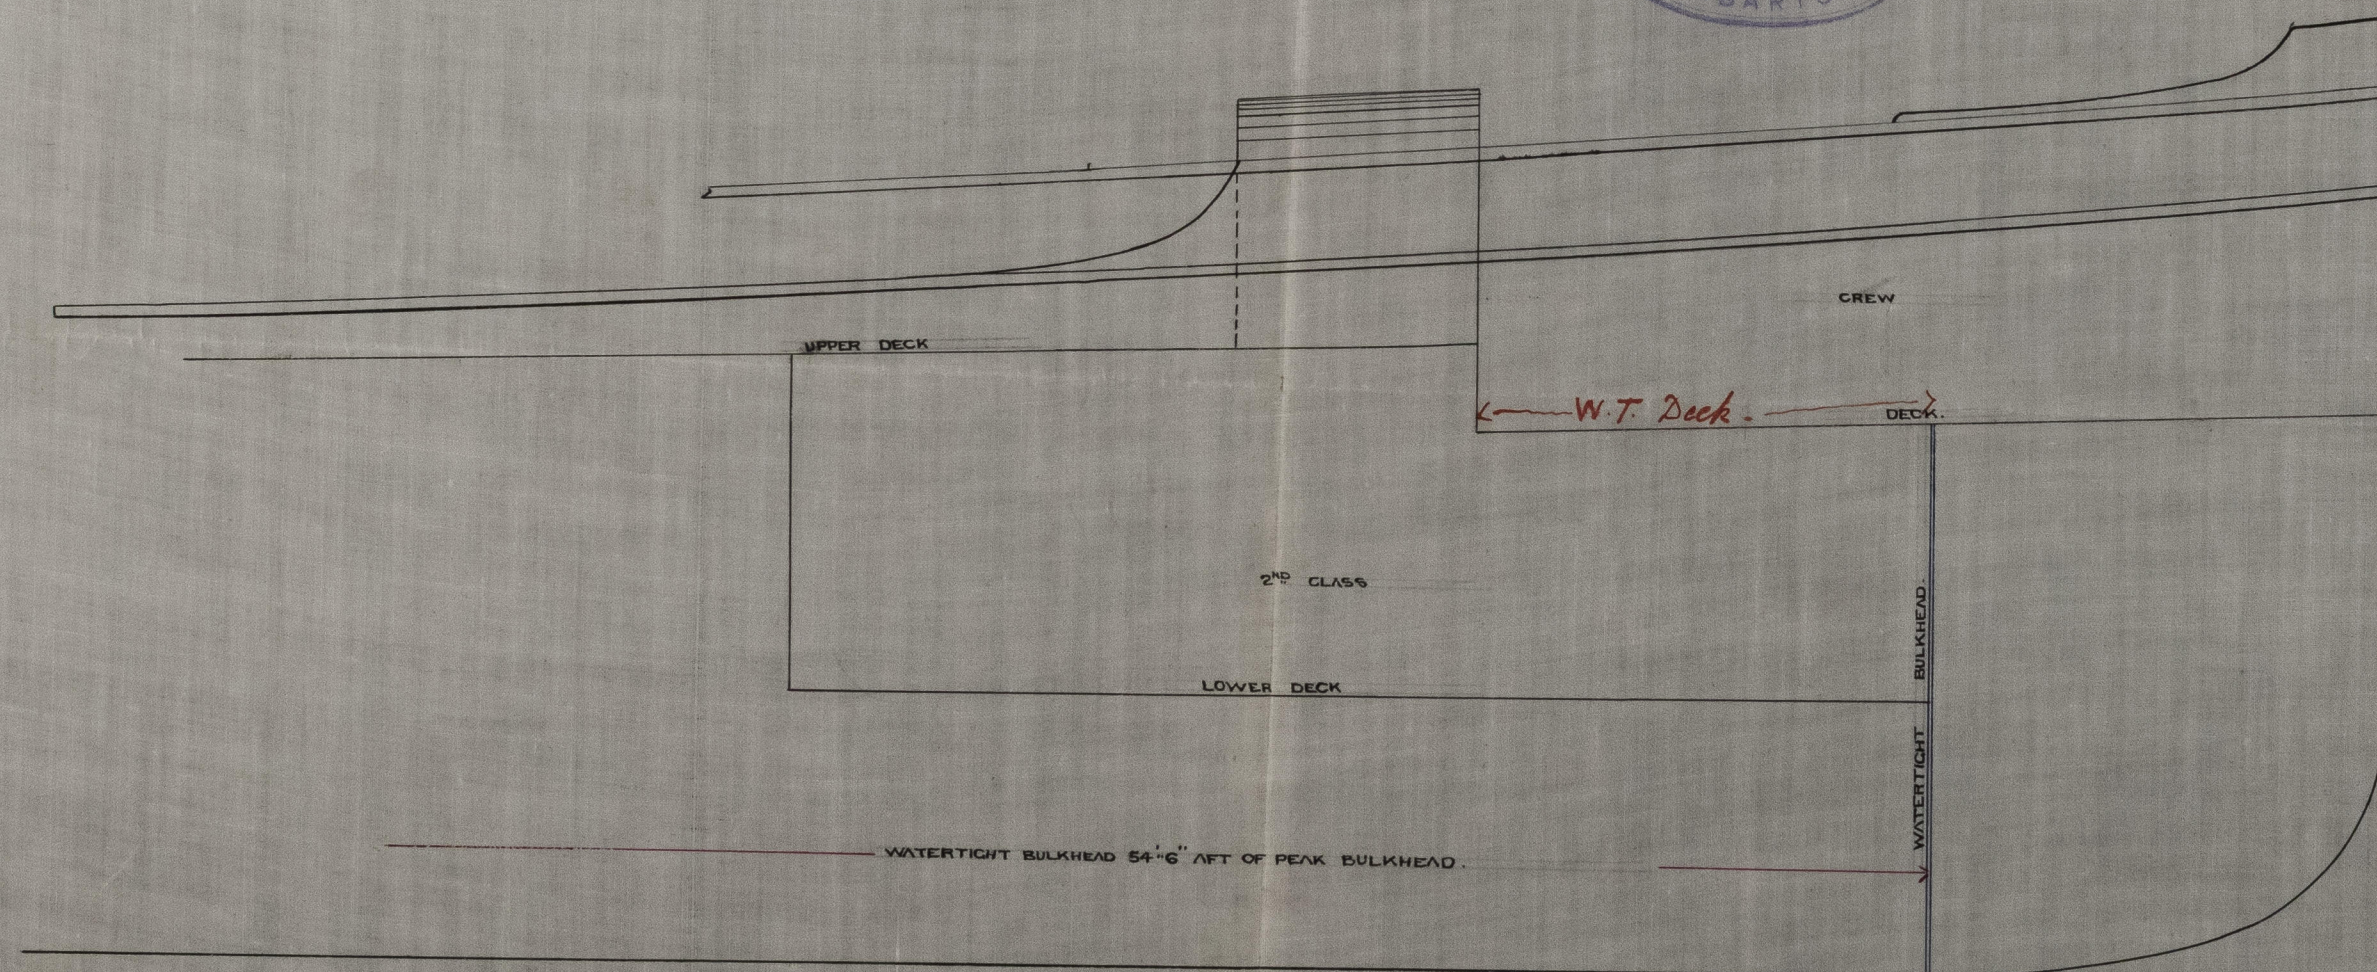


S.S. "Mahinapua"
Glasgow Report
No. 5648

SKETCH SHEWING POSITION OF PEAK BULKHEAD

TWIN SCREW 160'x26'10"x13'4"

SCALE $\frac{1}{4}$ " = 1 FOOT.

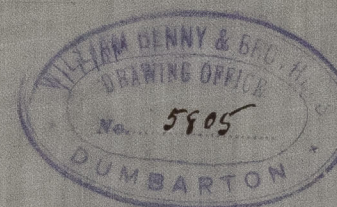

© 2021

Lloyd's Register
Foundation

GLS190-0100