
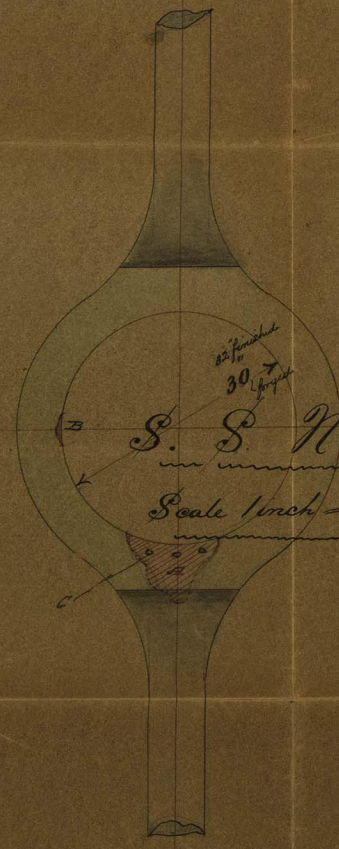


16. 6. 87



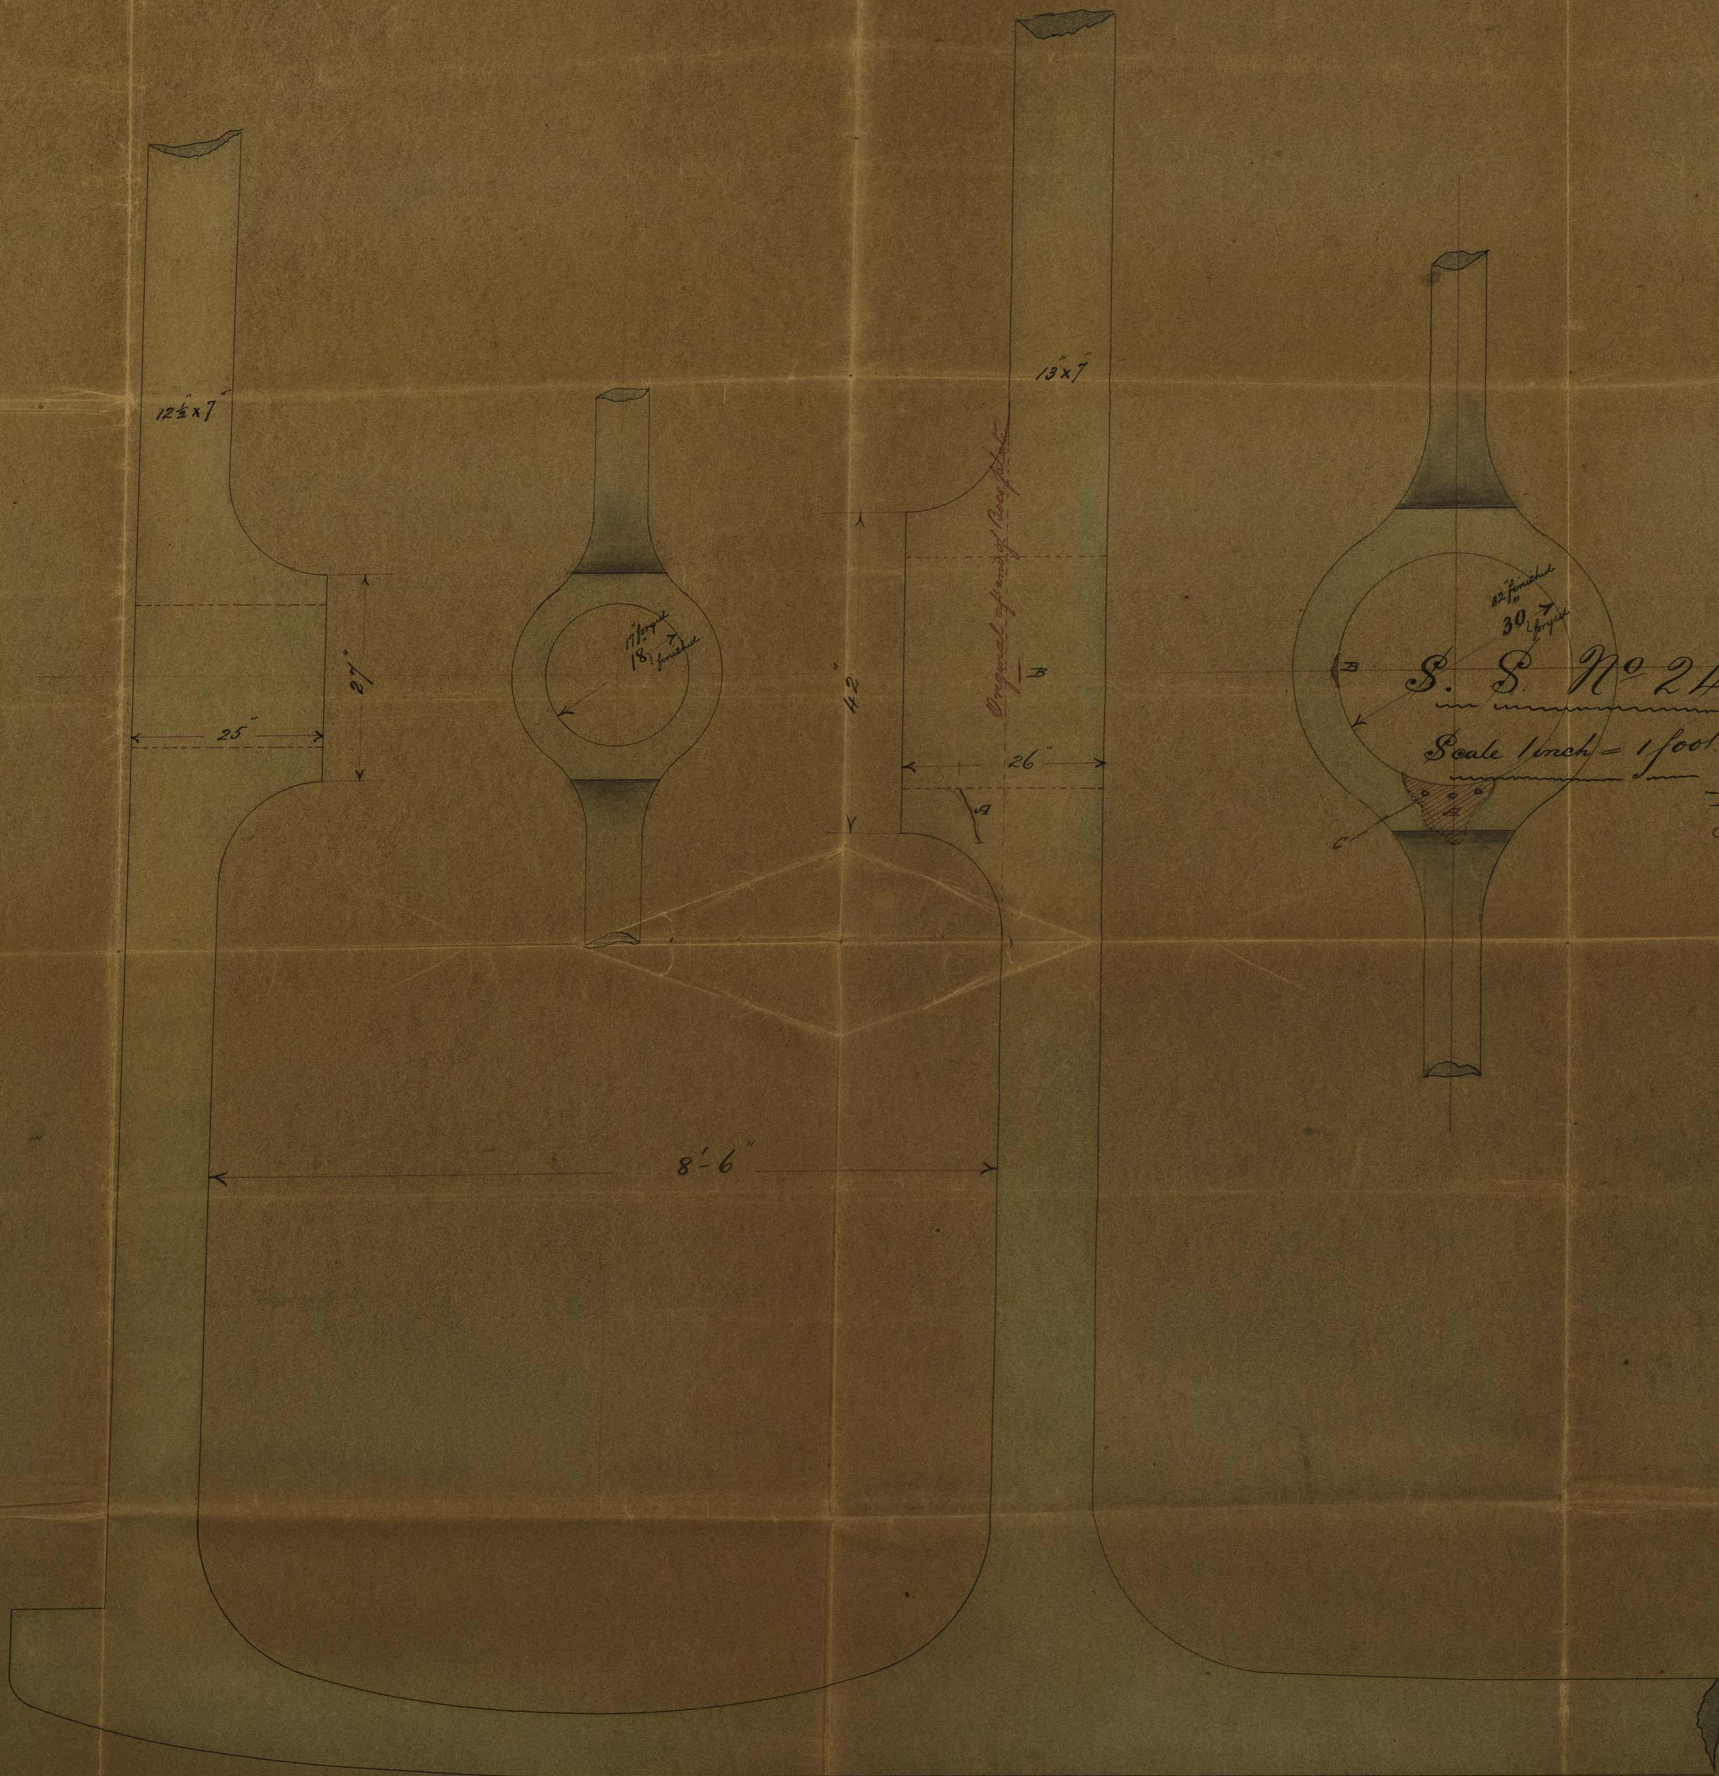

© 2021  
JOHN ELDER & CO.,  
Engineers and Shipbuilders  
Lloyd's Register  
Foundation  
14/6/87  
45190-0112