

RECEIVED 14 DEC. 82

21/12/82


*D.P.
11/12/82*

PLAN OF PLUMBER WORK

OF SS N^o 317 - IS

Scale 1/2" = one foot.

*S.S. "Dunbar Castle" - Glasgow Report N^o 6248.
S.S. "Northmen Castle" - do - " 6314.*

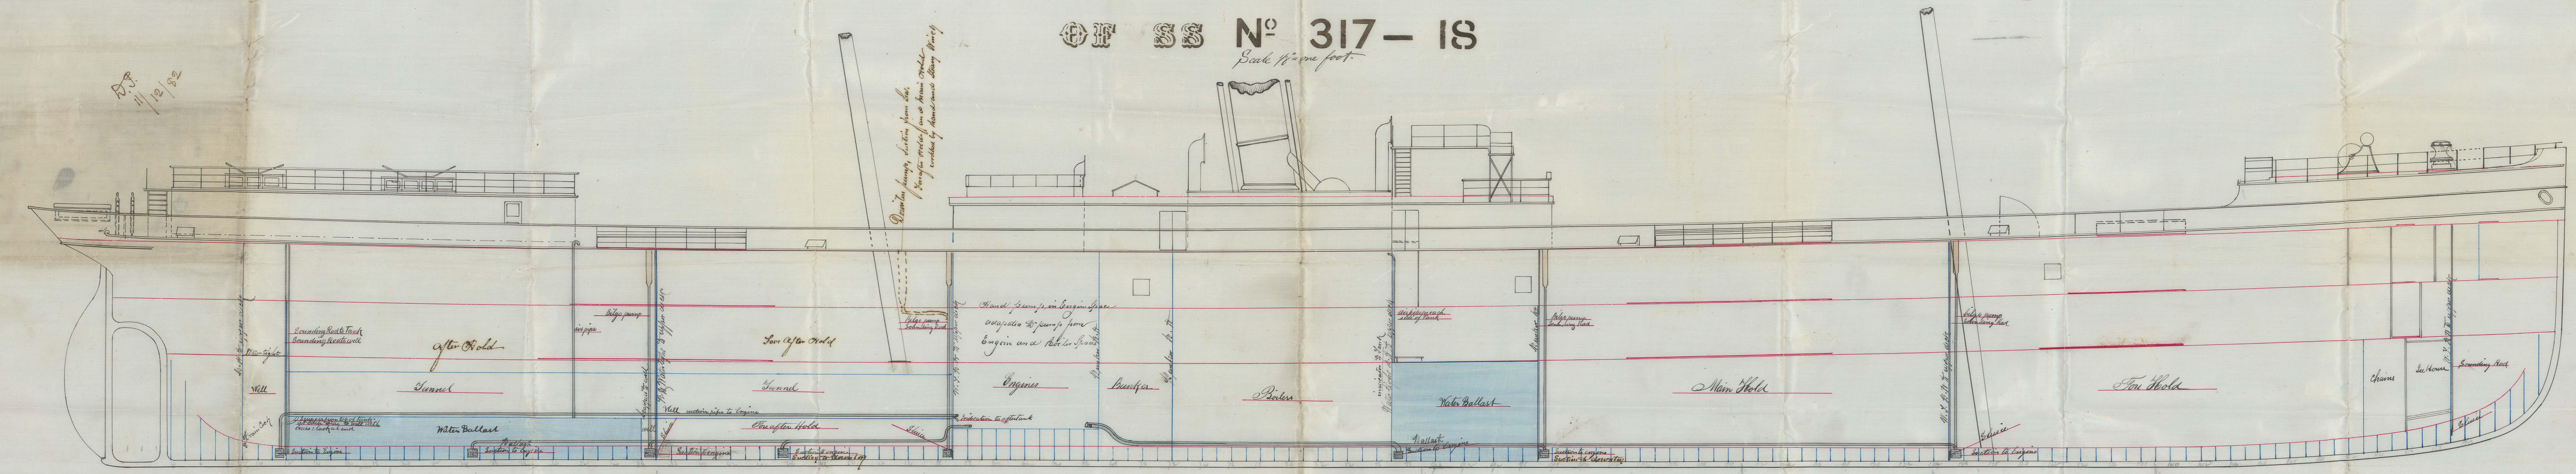

BAILY, CURLE & CO
SHIPBUILDERS
15, 16, 17, 18
AND ENGINEERS
Whitehall, GLASGOW

GLS191-0001



© 2021
Lloyd's Register
Foundation