



S.S. "Posang"

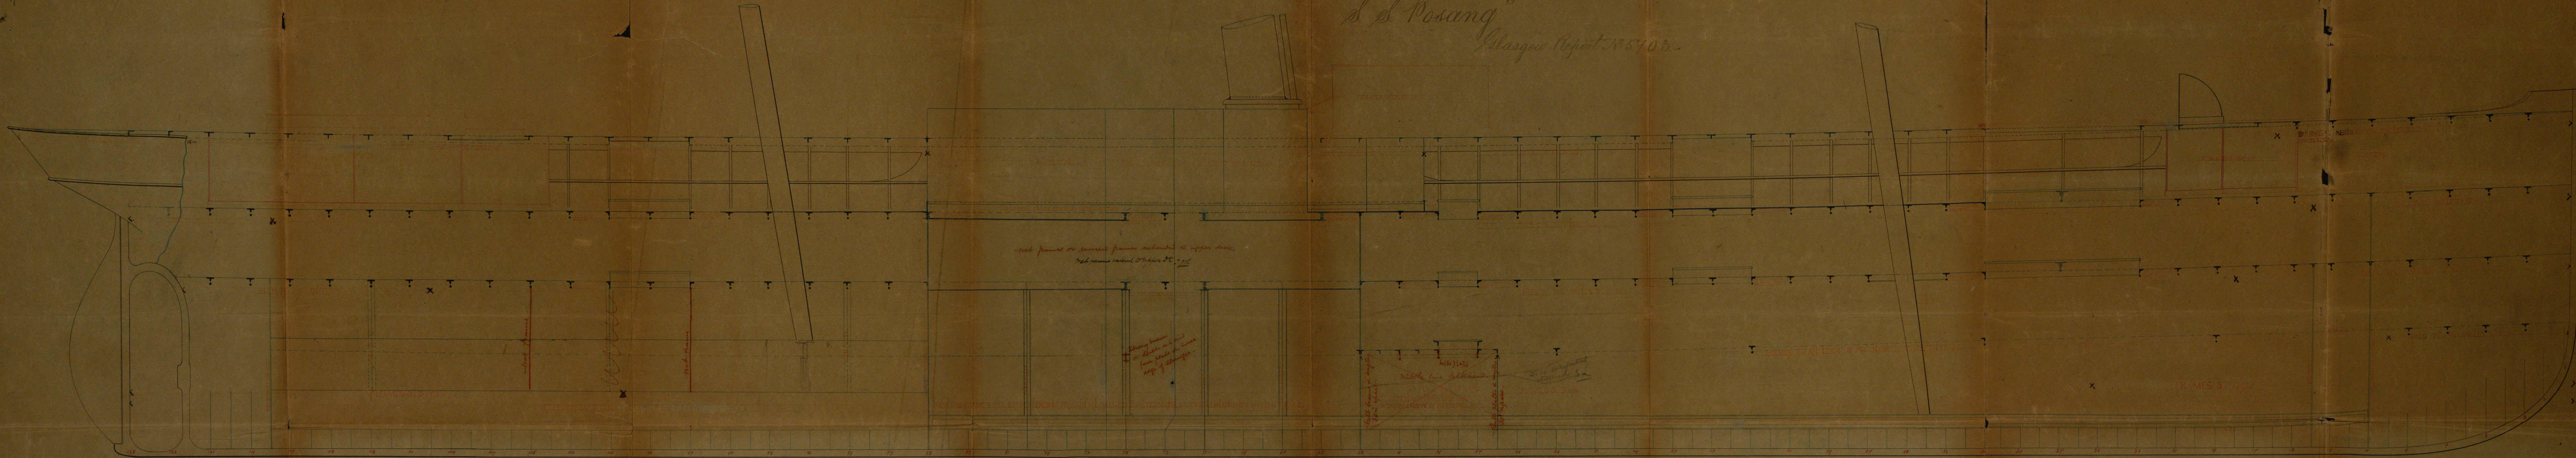

PLAN OF HULL

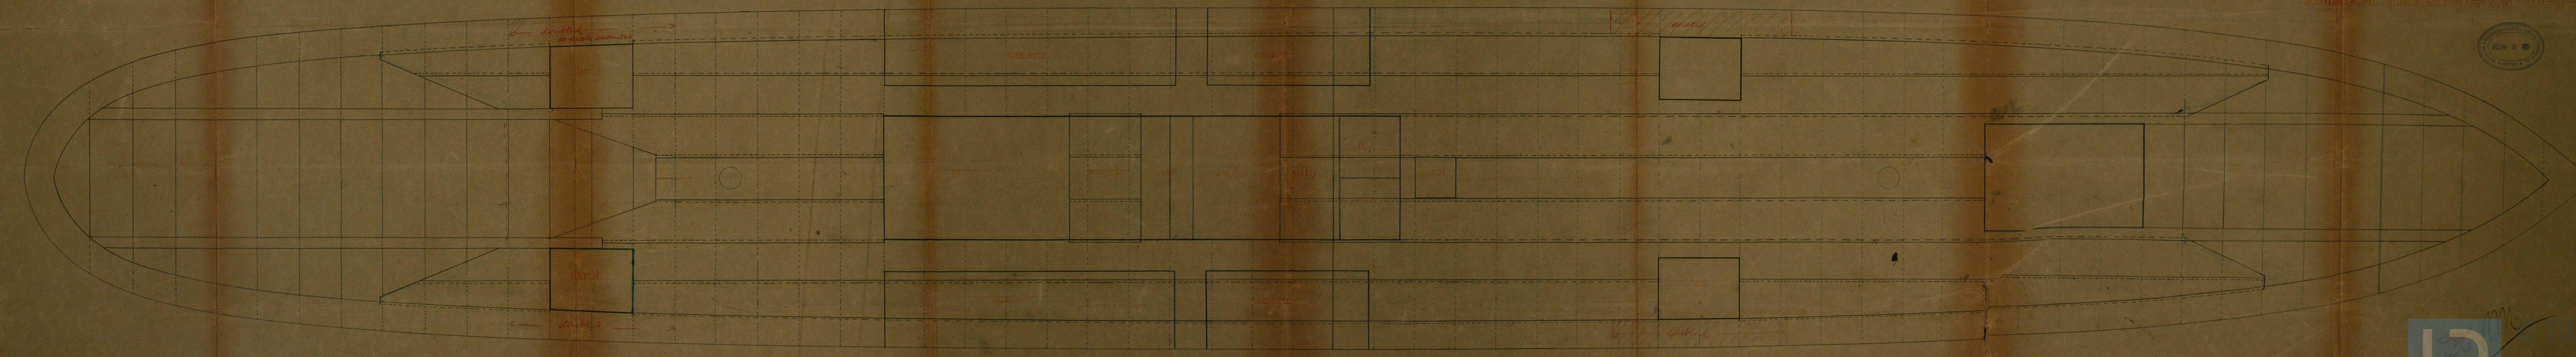

S.S. No 225

SCALE 1/8" = 1' TO THE FOOT

