


S S N<sup>o</sup> 111 "Engineer" Glasgow Report N<sup>o</sup> 5409.-  
 Proposed plan of main deck in way of bunkers modified from approved plan.  
 Scale  $\frac{1}{4}$ " = 1 foot

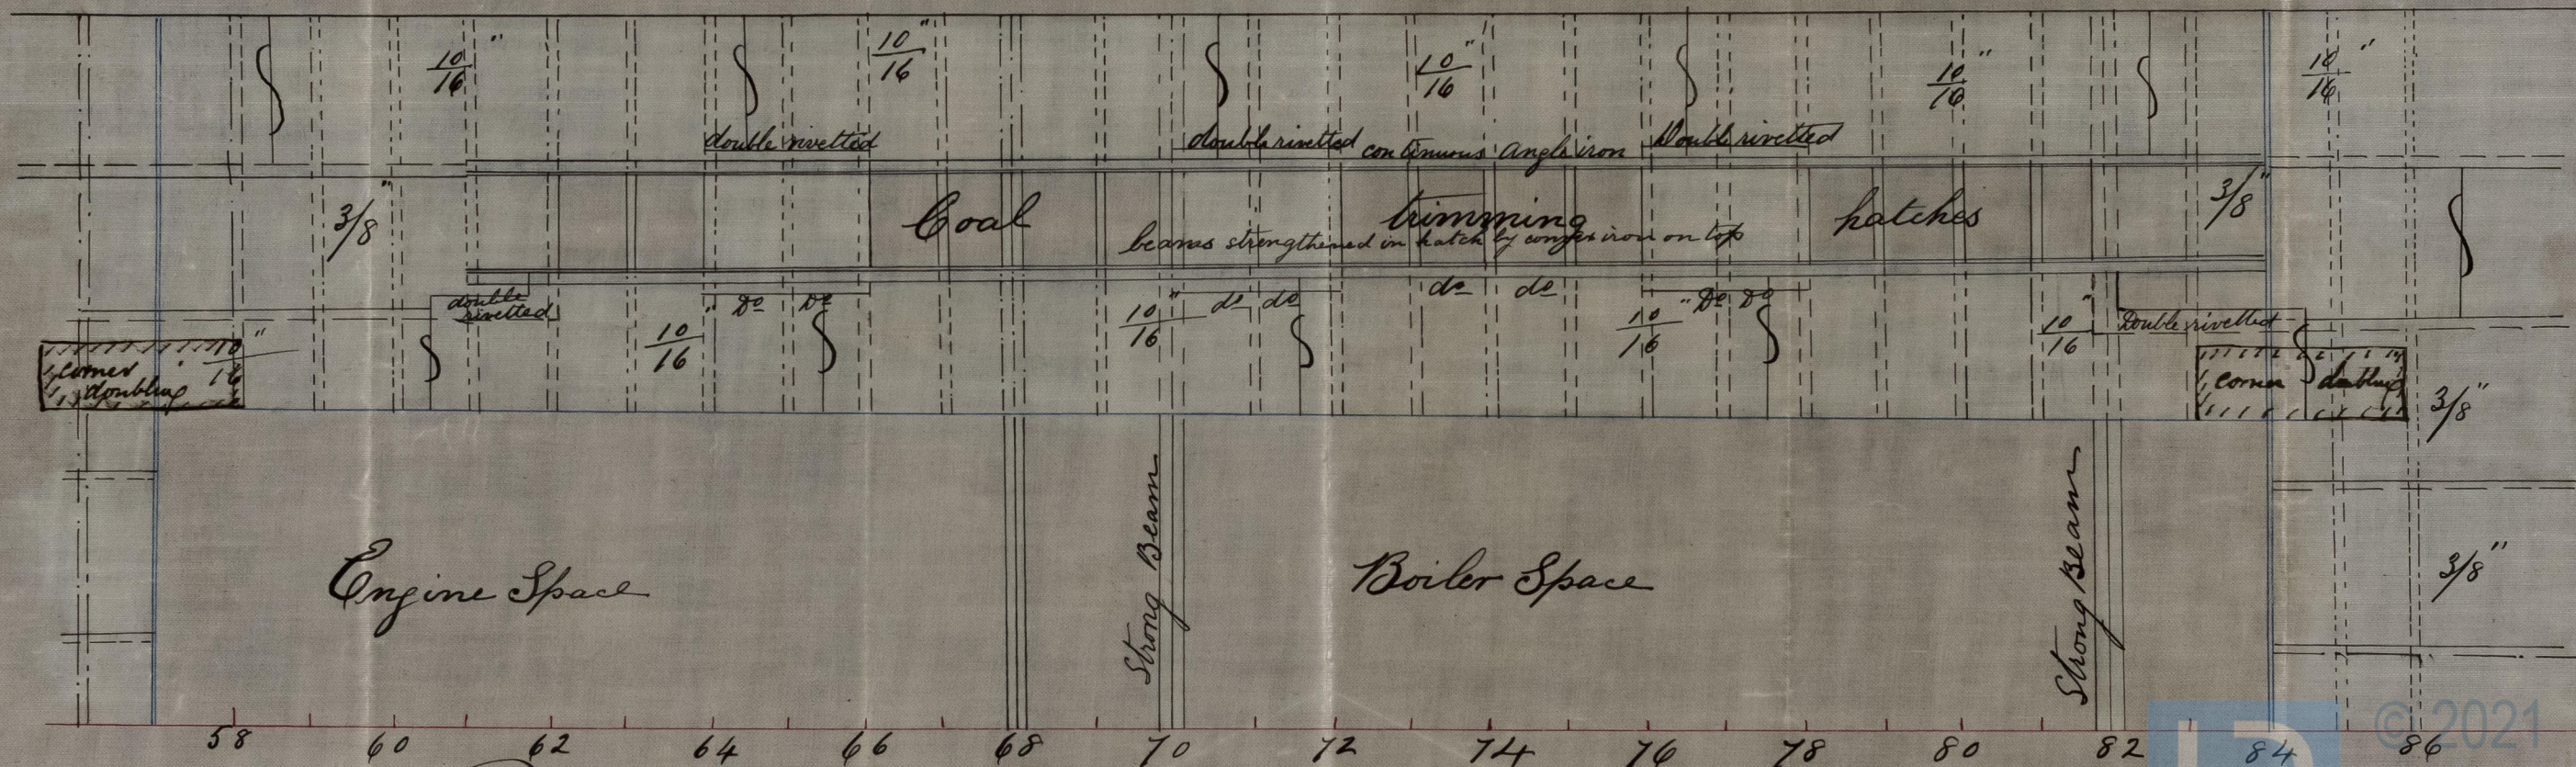

22/June/81  
 C.B.

GLS191-0010

© 2021  
 R  
 Register  
 Whitehead  
 21<sup>st</sup> June '81