

7/9/80



Sketch showing proposed alterations  
in Centre Keelson

"S. S. India" & "Goorkha"  
Glasgow Report No. 5377  
5421


N<sup>o</sup> 248

SCALE  $\frac{1}{2}$

— Steel —

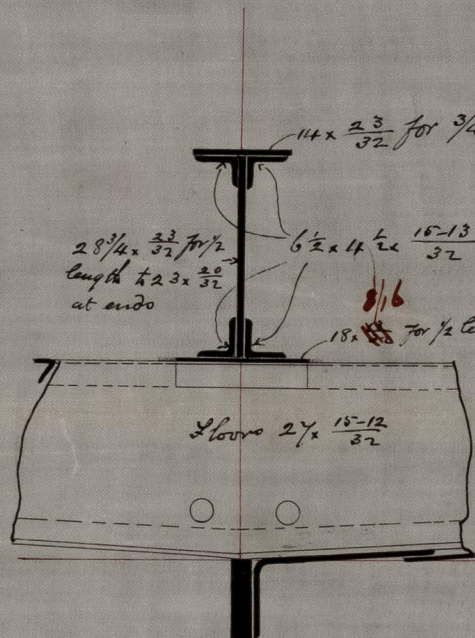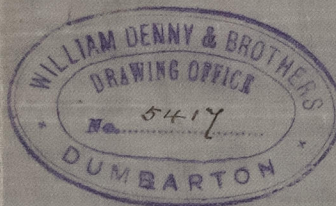

as Submitted

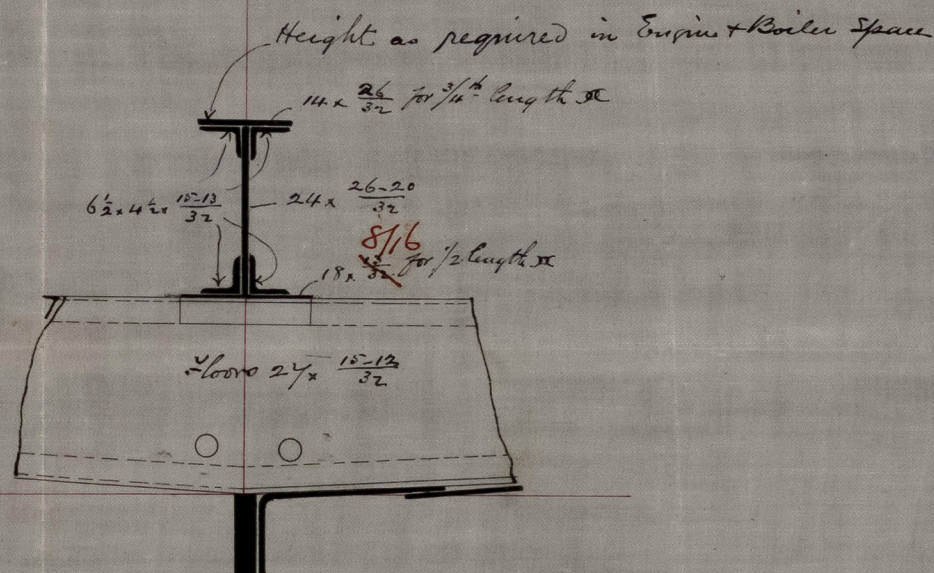

as proposed

J.H.



© 2021

Lloyd's Register  
Foundation

GLS191-0019