



COPY ID RC  
N<sup>o</sup> 767

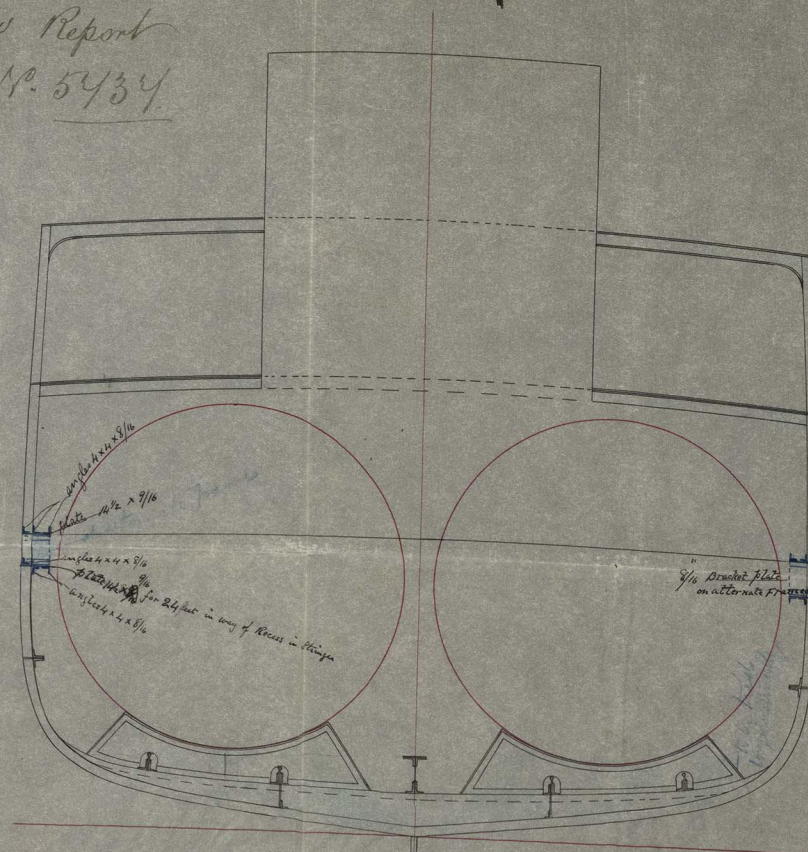




UPPER DECK PLAN

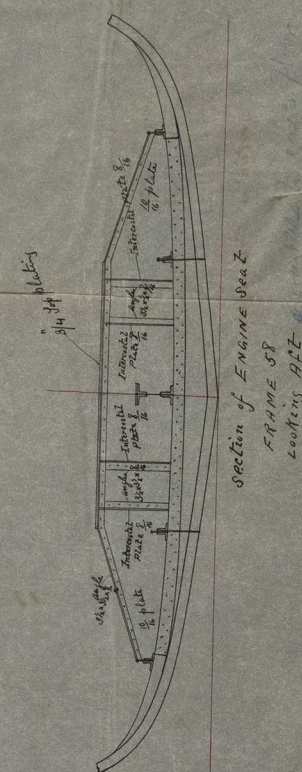


tion of ENGINE SEAT  
FRAME 58  
LOOKING ATZ

MAIN DECK PLAN

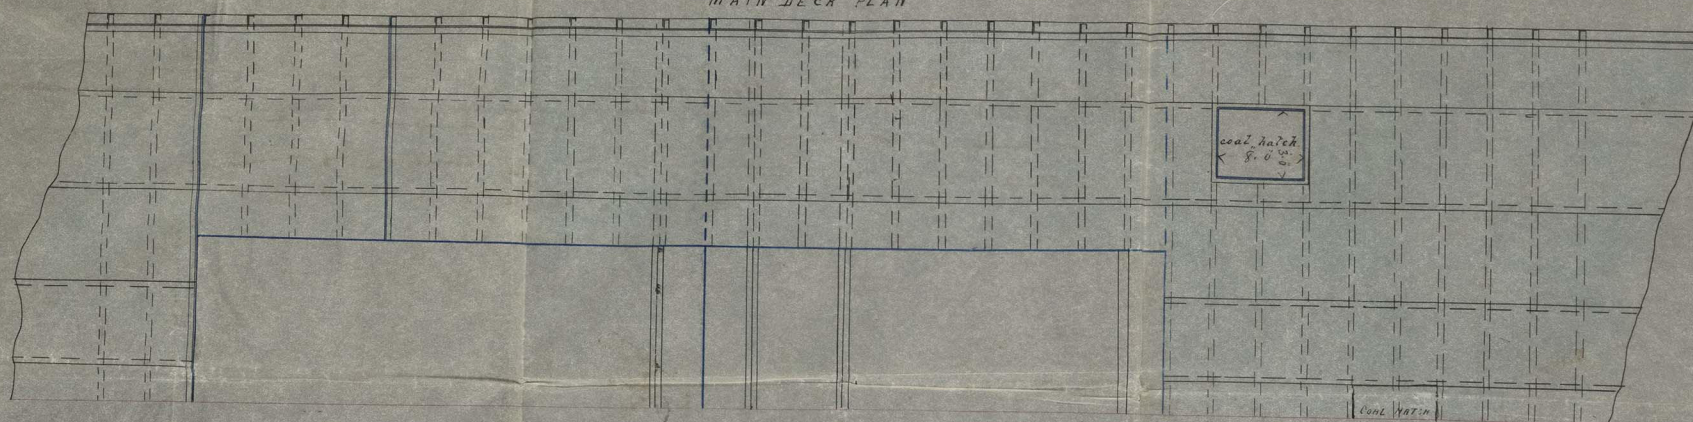

LOWER DECK PLAN

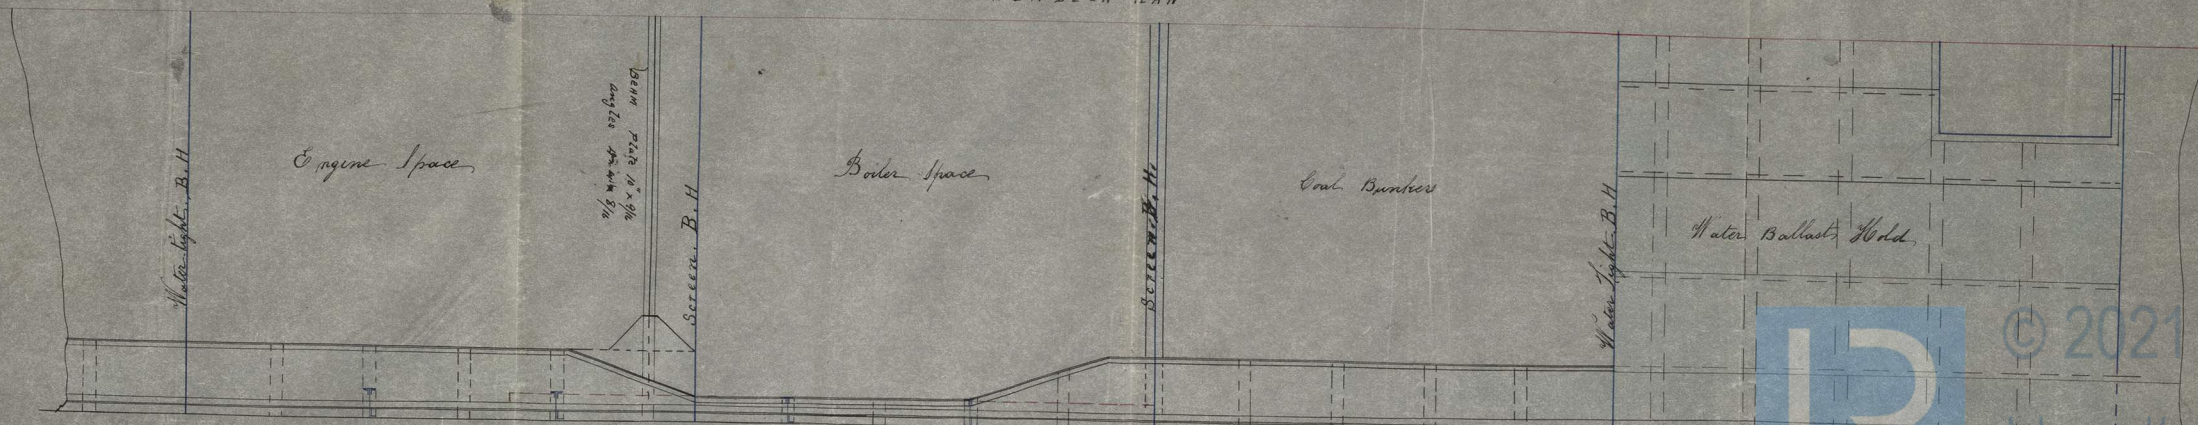

Sketch of Engine and boiler spaces.

SCALE  $\frac{1}{4}$  INCH = 1 FT

№117

GL3191-0039

© 2021

DOBIE & CO.,  
SHIPBUILDERS,  
GOVAN.

GLASGOW  
27/10/81