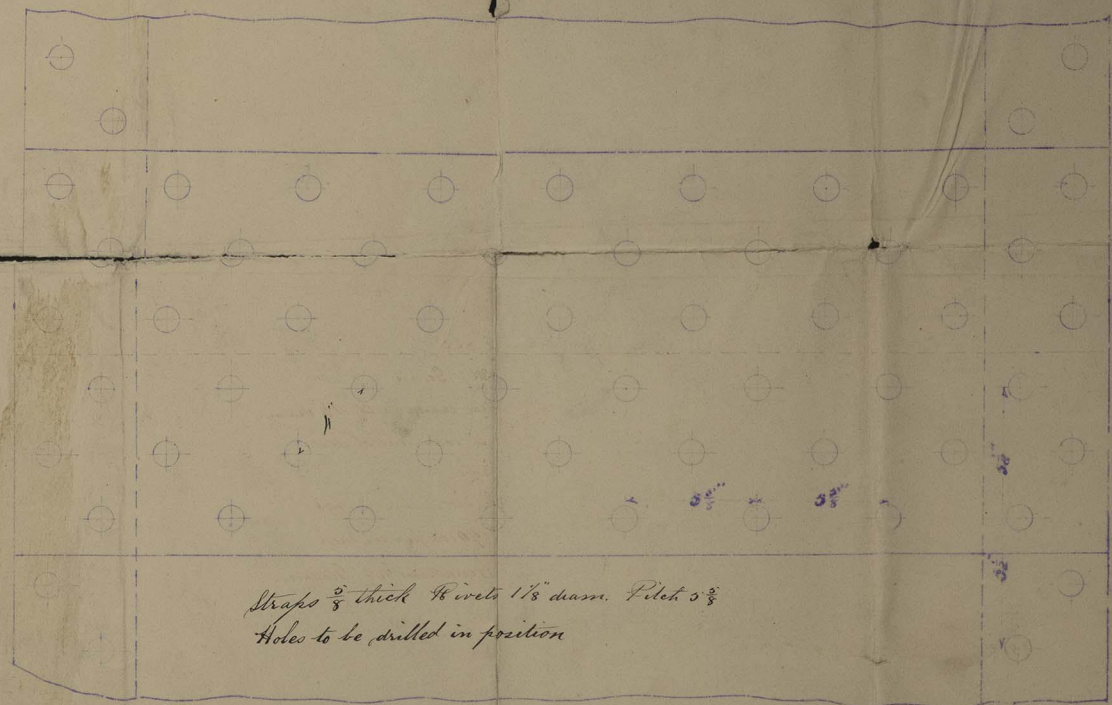

 Let to Cls: 6/9/81  
 6/9/81

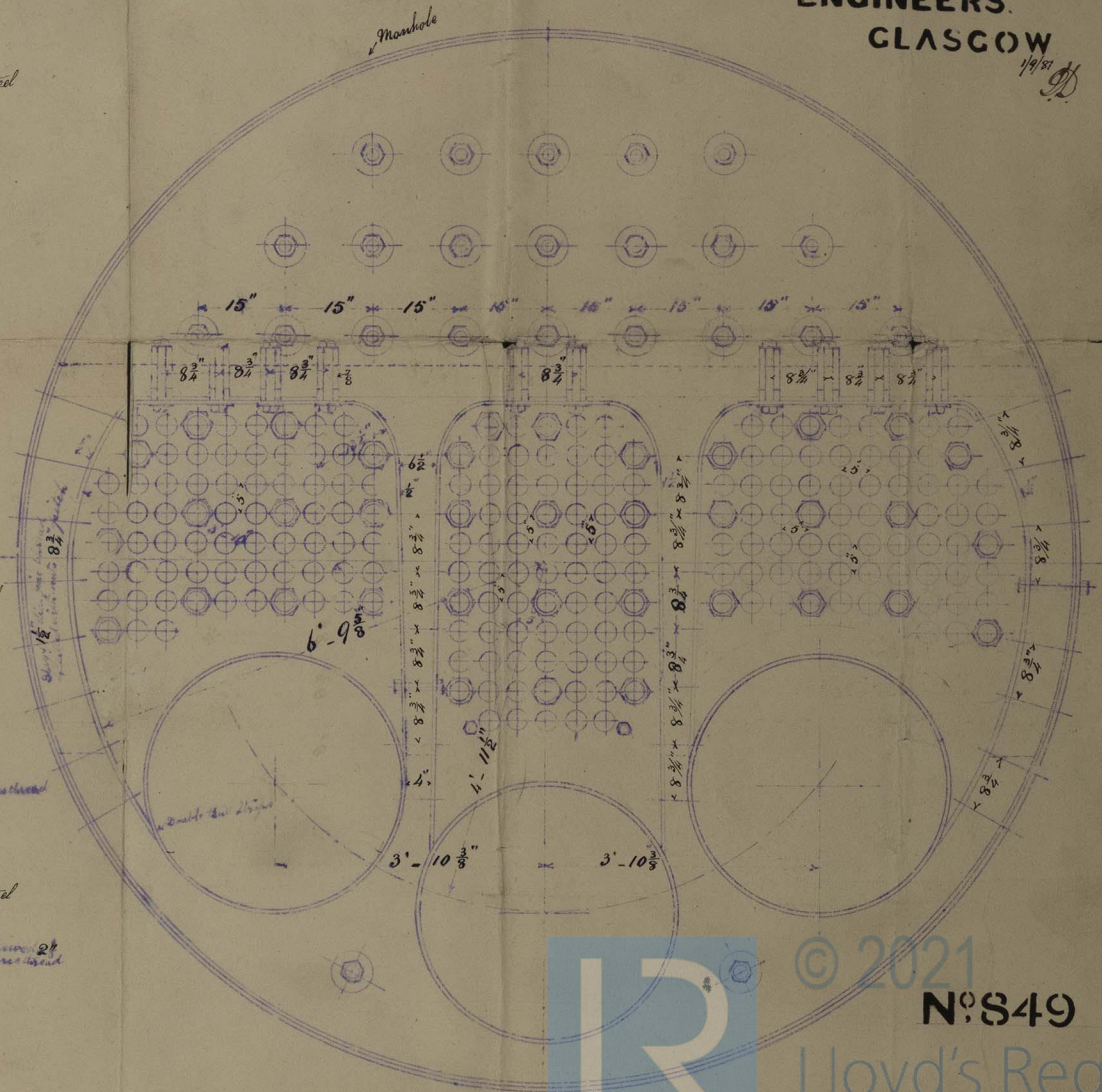
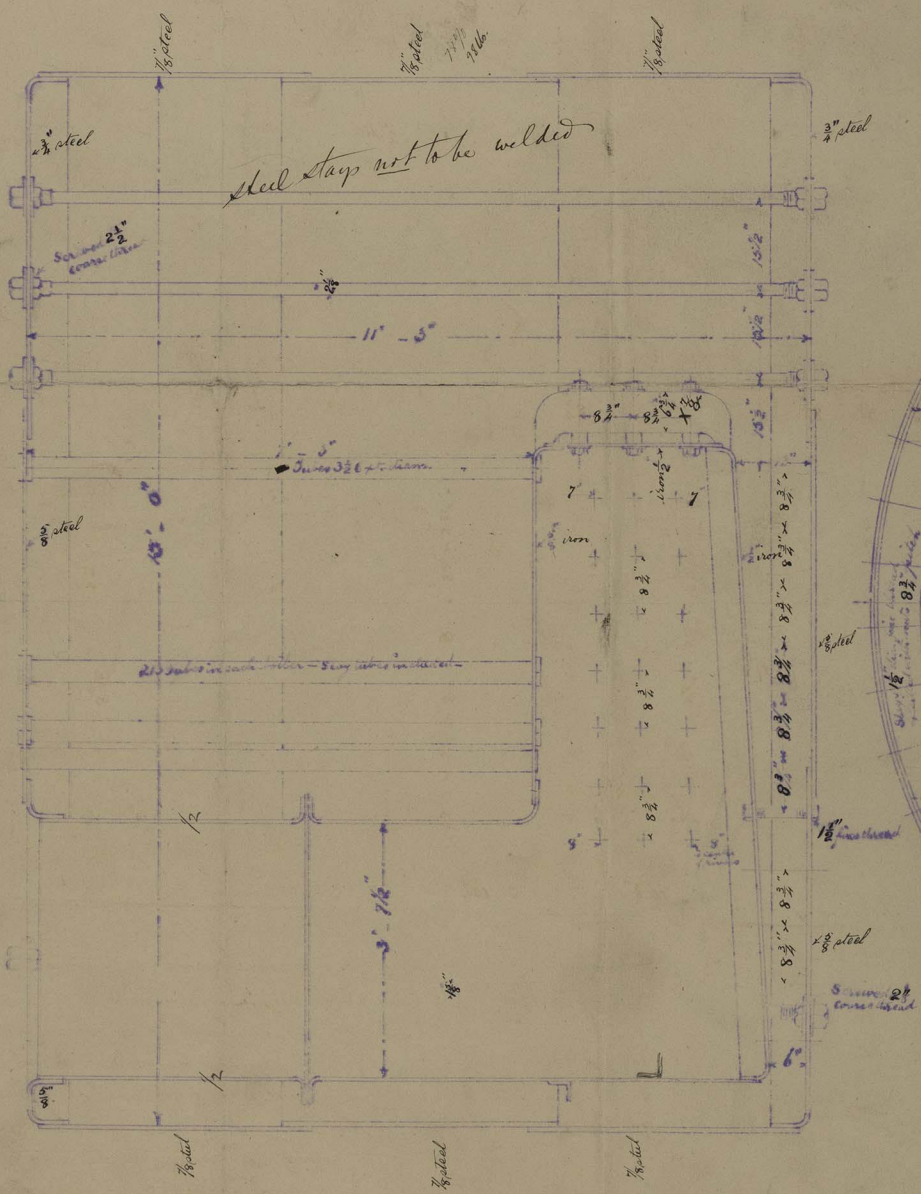
Machinery for  $\frac{3}{8}$  284 x 35 x 25  
 Building by Messrs Dobbin & Co Govan  
 Engines 35 x 48 x 42 stroke steel crank shaft 11 1/2 diam.  
 2 Boilers 15 ft diameter x 11-3 long shell of steel  
 furnaces & fireboxes of iron  
 Longitudinal stays of steel, fire box stays of iron  
 Steam pressure required 90 lbs per sq. inch  
 Machinery by Messrs Walker Henderson & Co Glasgow.



Straps  $\frac{3}{8}$  thick Wires 1 1/8 diam. Pitch 5 3/4  
 Holes to be drilled in position

S. S. "Heimdal"  
 Glasgow Report No 5234.

WALKER HENDERSON & CO  
 ENGINEERS.  
 GLASGOW



SCALE  $\frac{1}{4}$  INCH TO THE FOOT

© 2021  
 No 849  
 Lloyd's Register  
 DRAWING No 14613  
 Foundation  
 GLS191-0041