


SKETCH OF PEAK BULKHEADS

S.S. 180 x 29 x 15.3

SCALE 1/4" = 1 FOOT

*S.S. "Omapere" Glasgow Report
No. 53/45.*

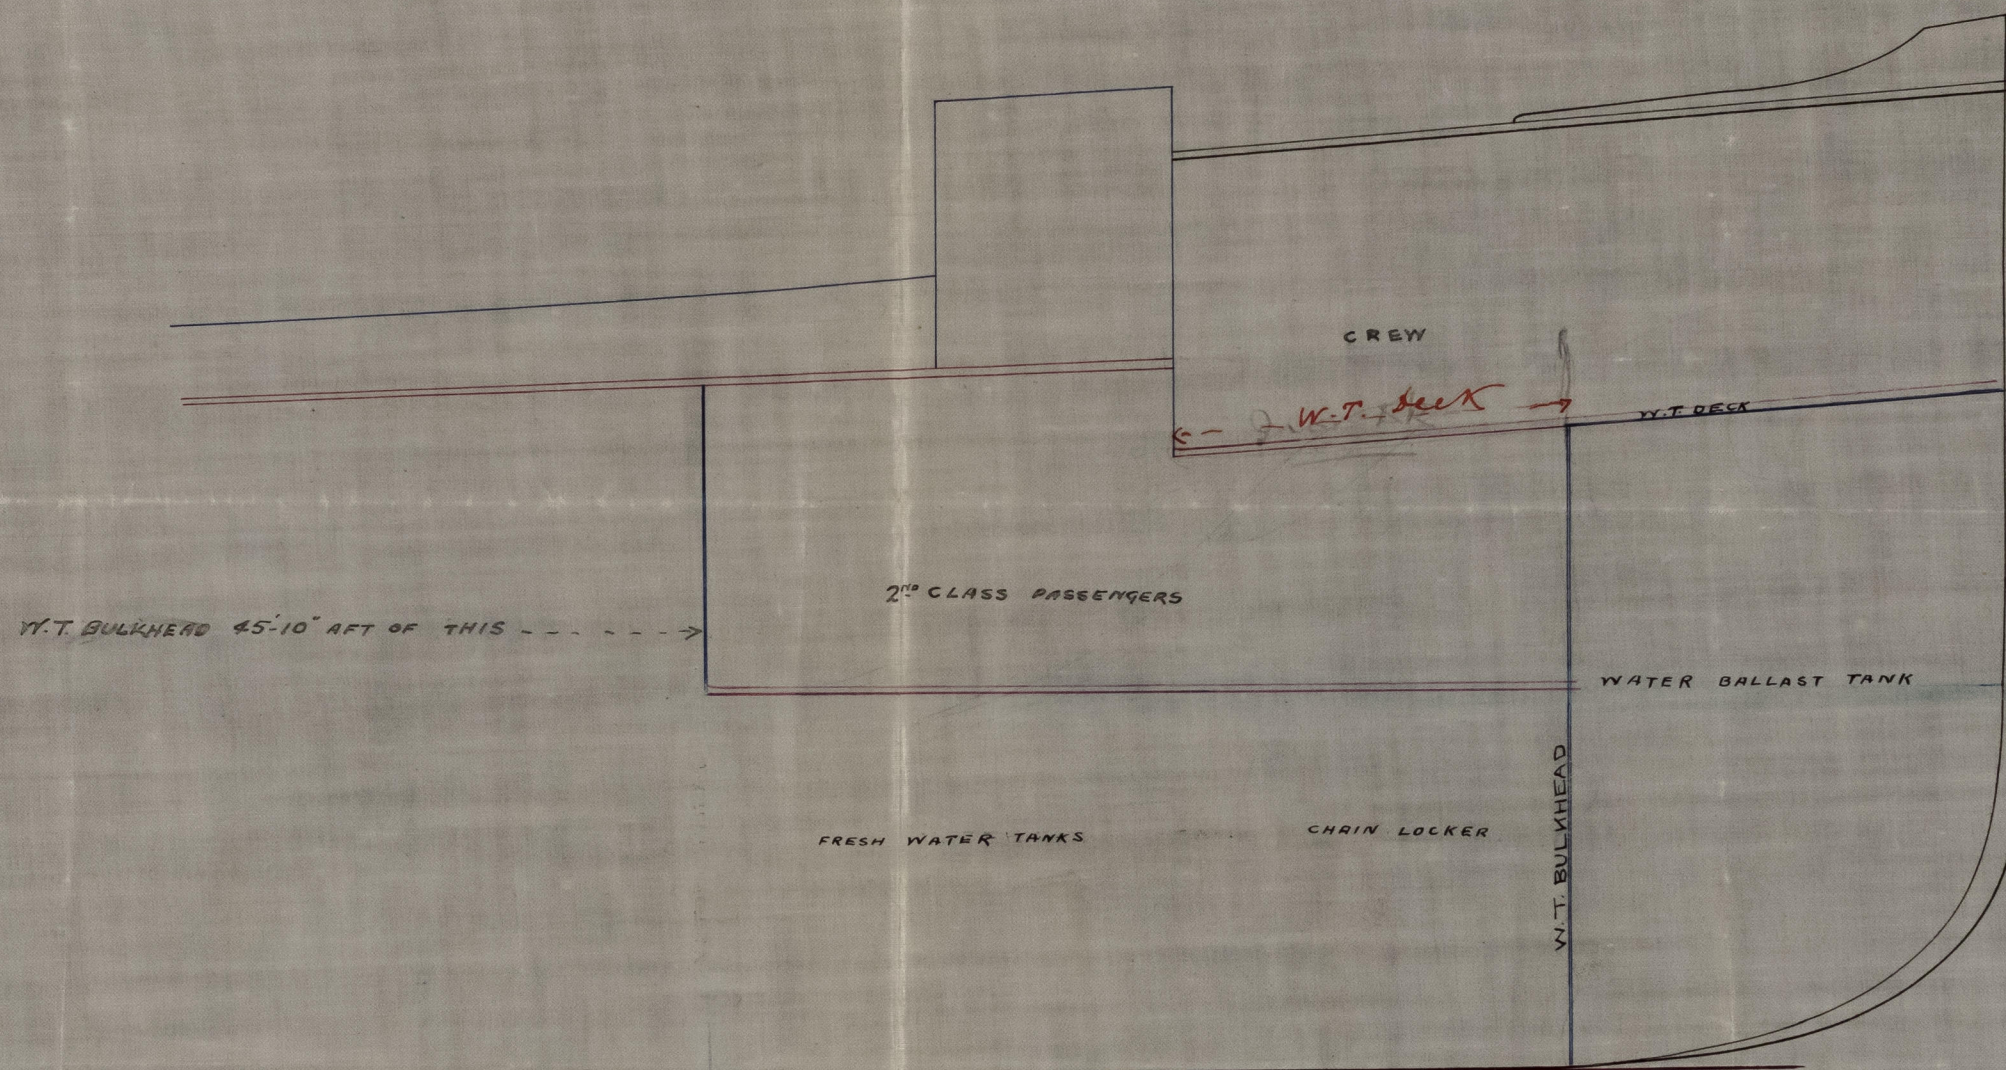

© 2021

Lloyd's Register
Foundation

GLS191-0050