

Bk. Aberdeenshire
Glasgow Report. No 5. 1/68

Dimensions.


Length as per Rule.....	230.0
Half moulded Breadth.....	17.9
Depth from top of Keel.....	23.2
Half moulded Girth.....	36.55

Minerals.

$17.9 + 23.2 + 36.55 = 77.65$ Stewardship
 $" + " + " \times 230 = 17859.5$ Longitudinal
 $" + " + " \times " + \frac{1}{15} = 19050.13$ Outfit

Proportions.

230. \div 35.8 = 6.42 Moulded Breadth.
" \div 23.2 = 9.91 Depth from top of keel.

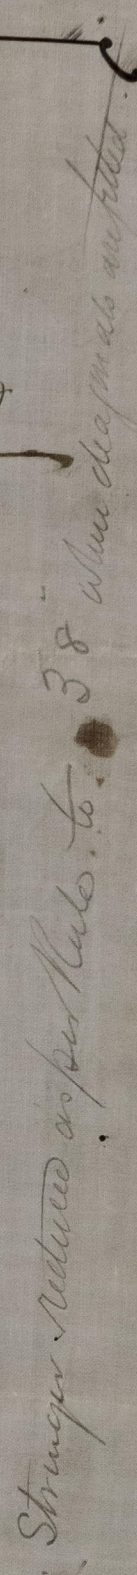

Alex^r Stephen & Sons
SHIPBUILDERS & ENGINEERS
GLASGOW

DRAWING N° 2239

Ex-27/18

GLS191-0068