

RECEIVED 4th SEP. 82.

10.2.82


5/9/82.

Scale  $-\frac{1}{2}$  Inch = 1 Foot.

6<sup>th</sup> Feb. 1892-

S. S. Parakhyba  
Glasgow Report

N<sup>o</sup> 5843.

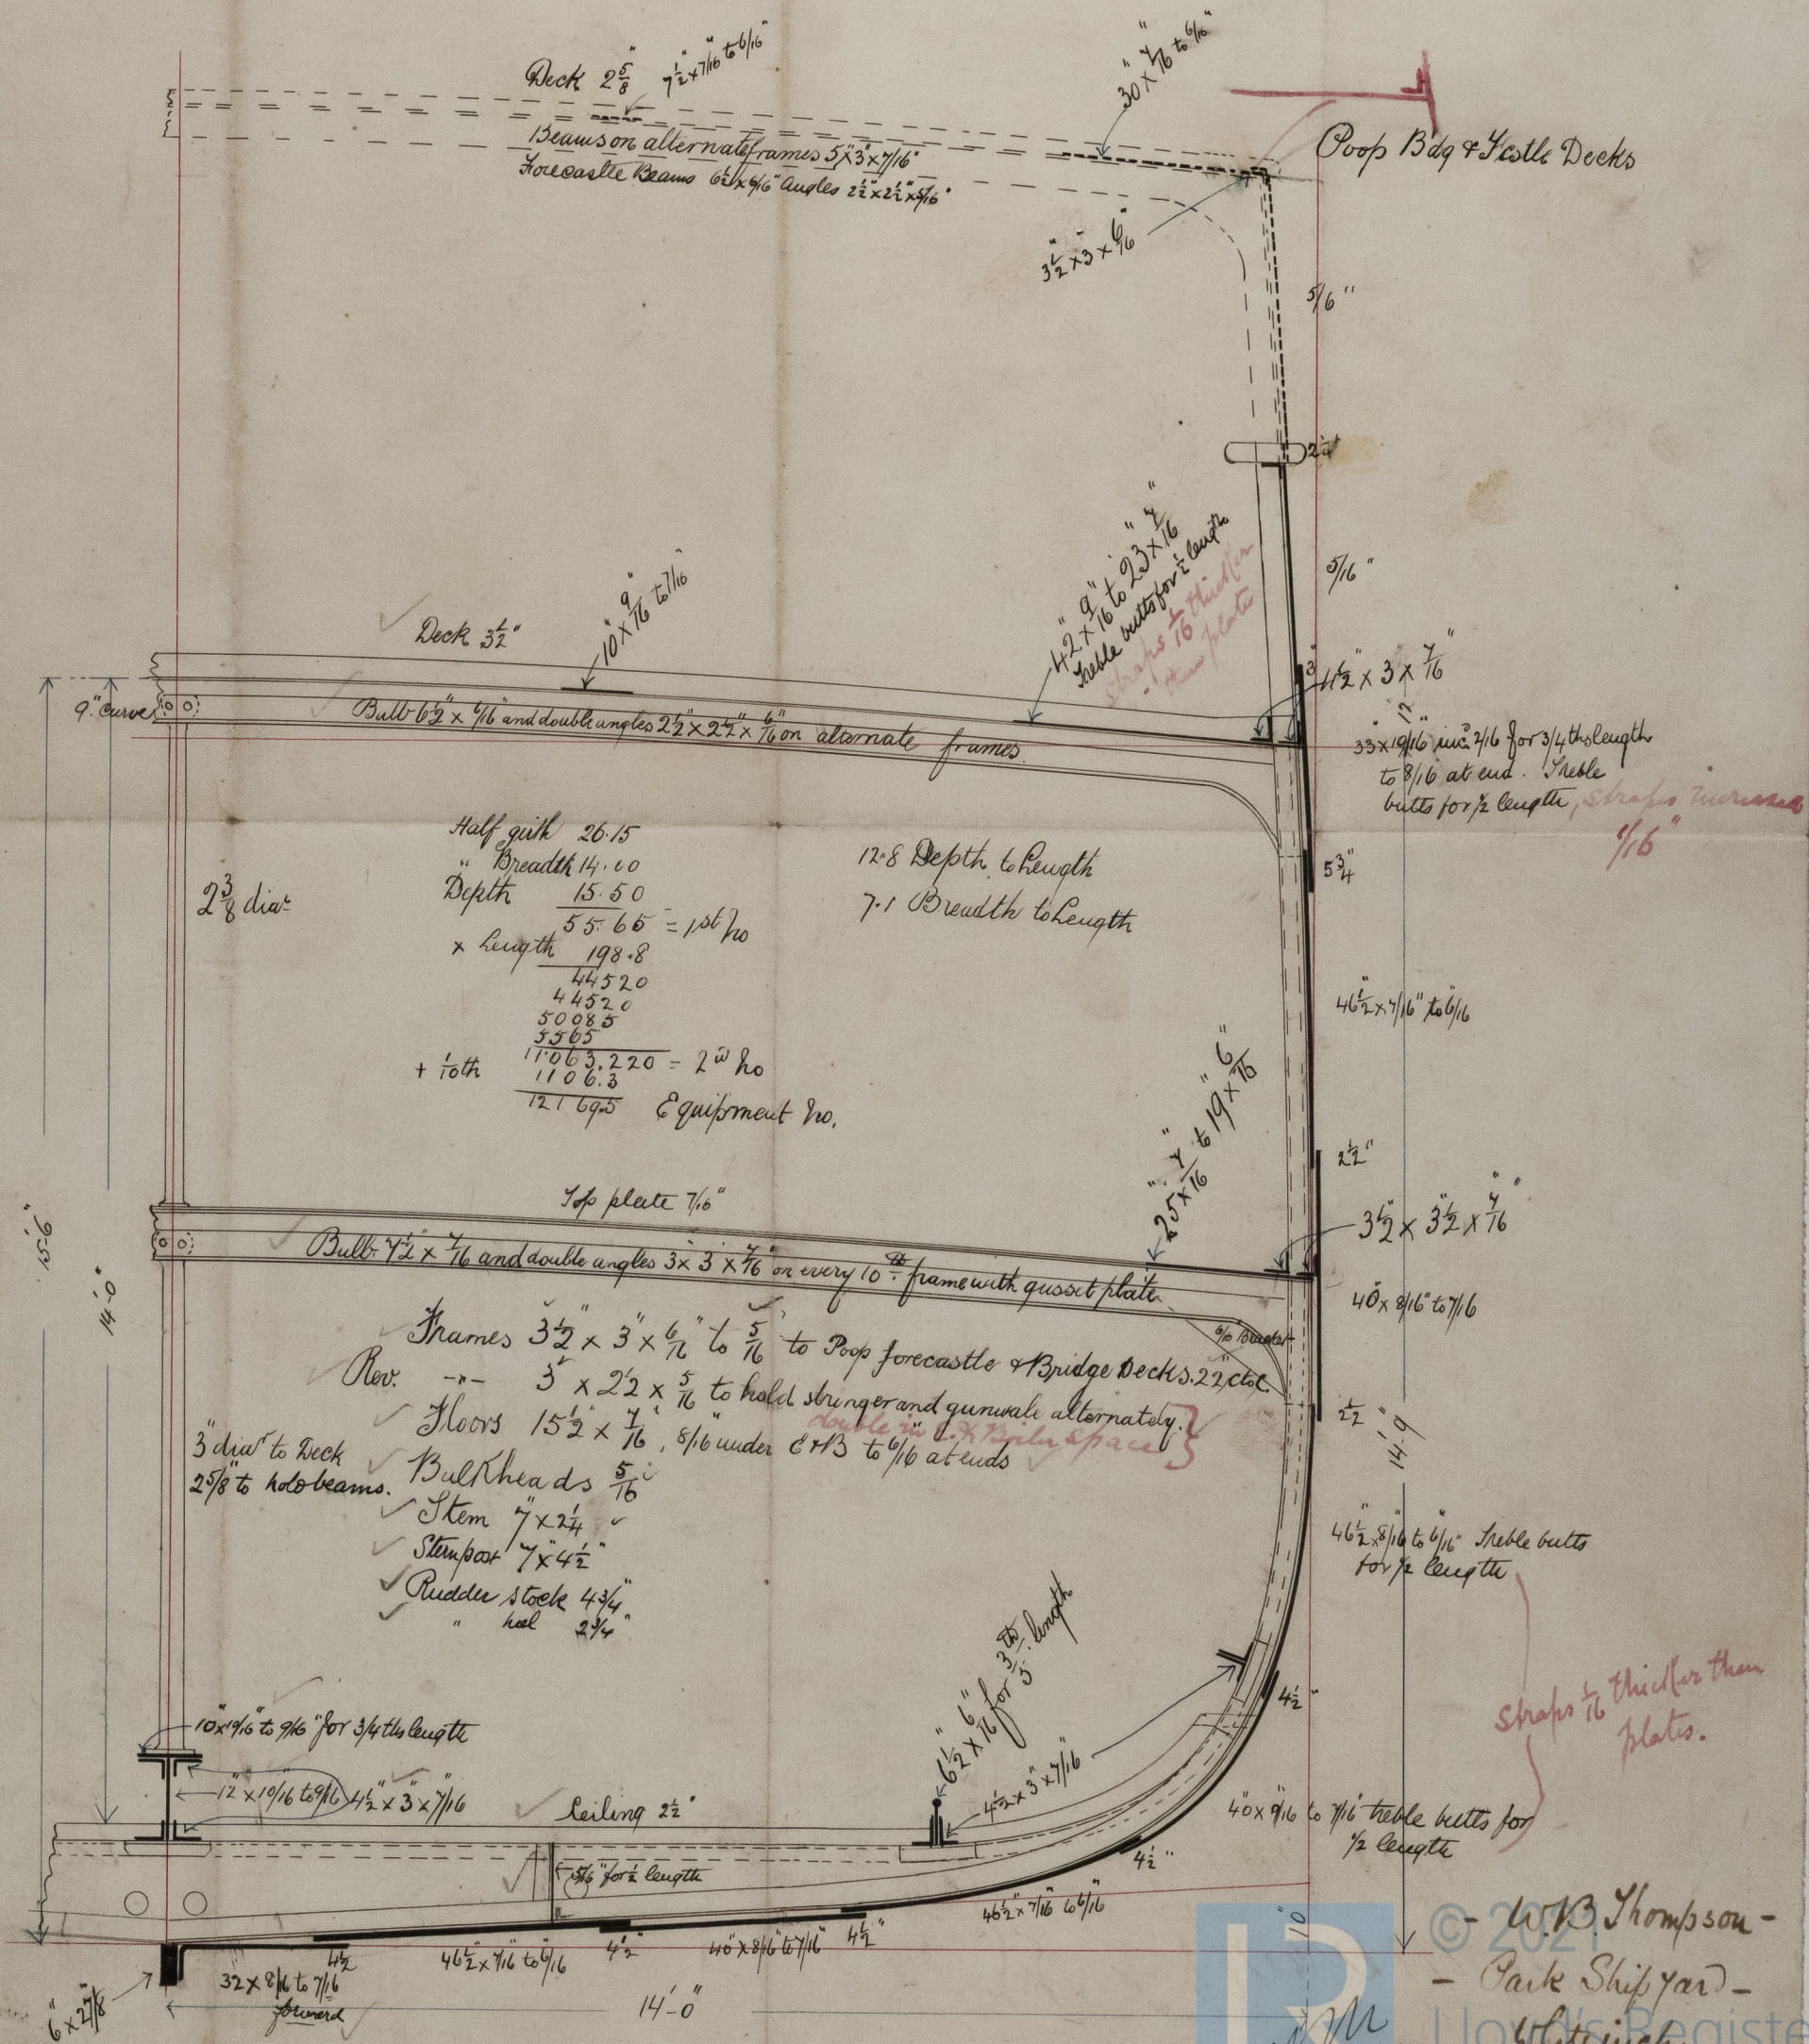

GLS192-0021

- W.B. Thompson -

- Park Shipyard -

White inch  
6/2/82