

RECEIVED 27th APR. 82.


Let: to Geo: 29/4/82.

M 29/4/82


PUMPING ARRANGEMENTS

N^o 262

SCALE 1" = ONE FOOT.
BALLAST SECTION —
ENGINE BILGE SECTION —
MANUAL LAGOON PUMPS —

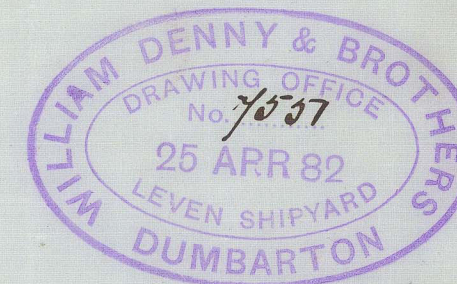

S.S. "Hauvoto"
Glasgow Report No 5871

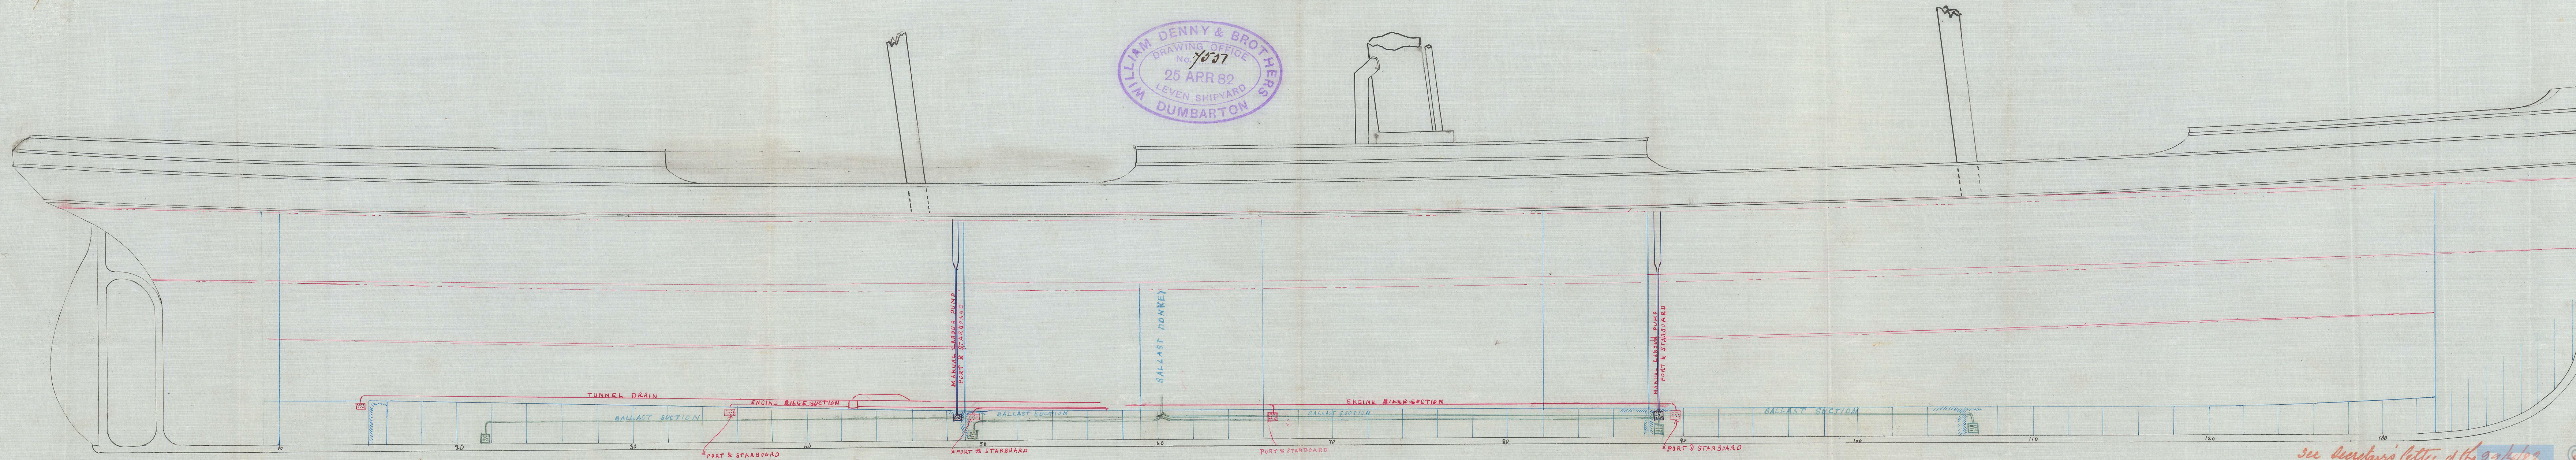

see drawing's letter of the 29/4/82