
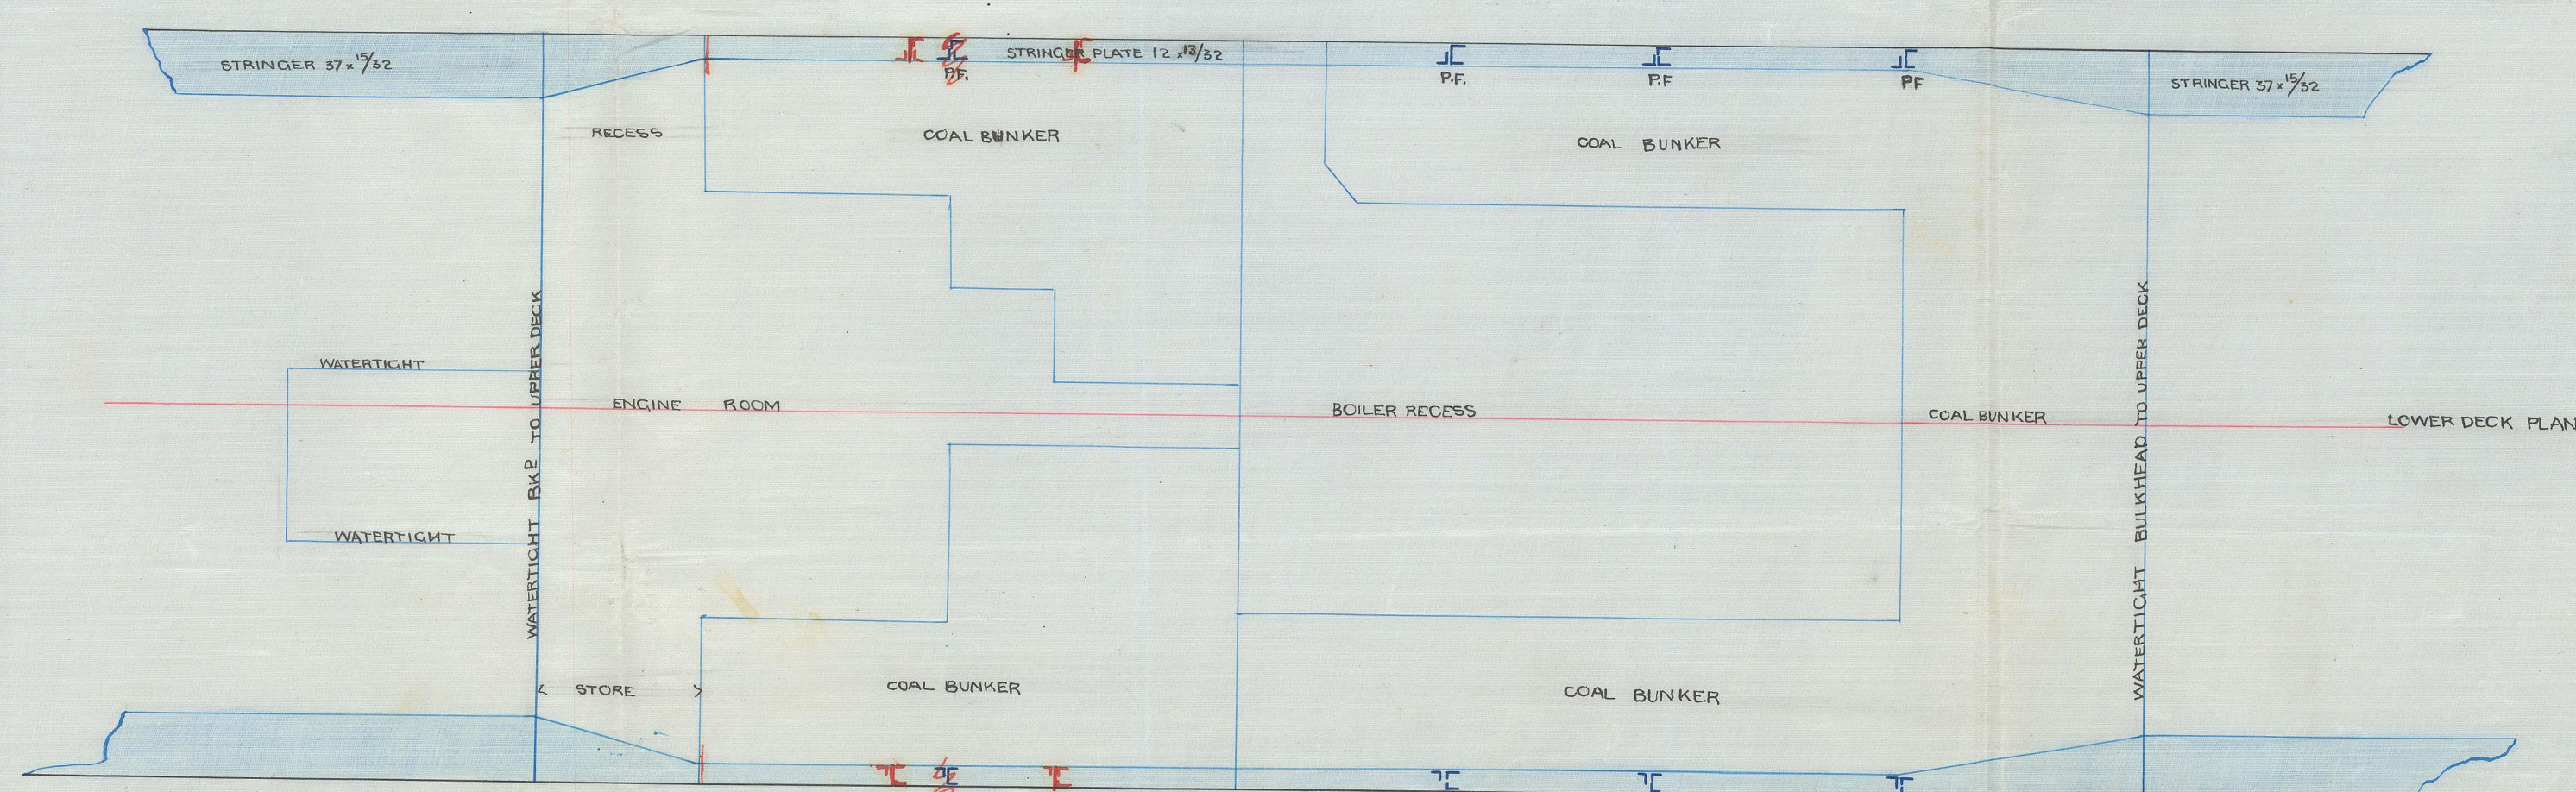
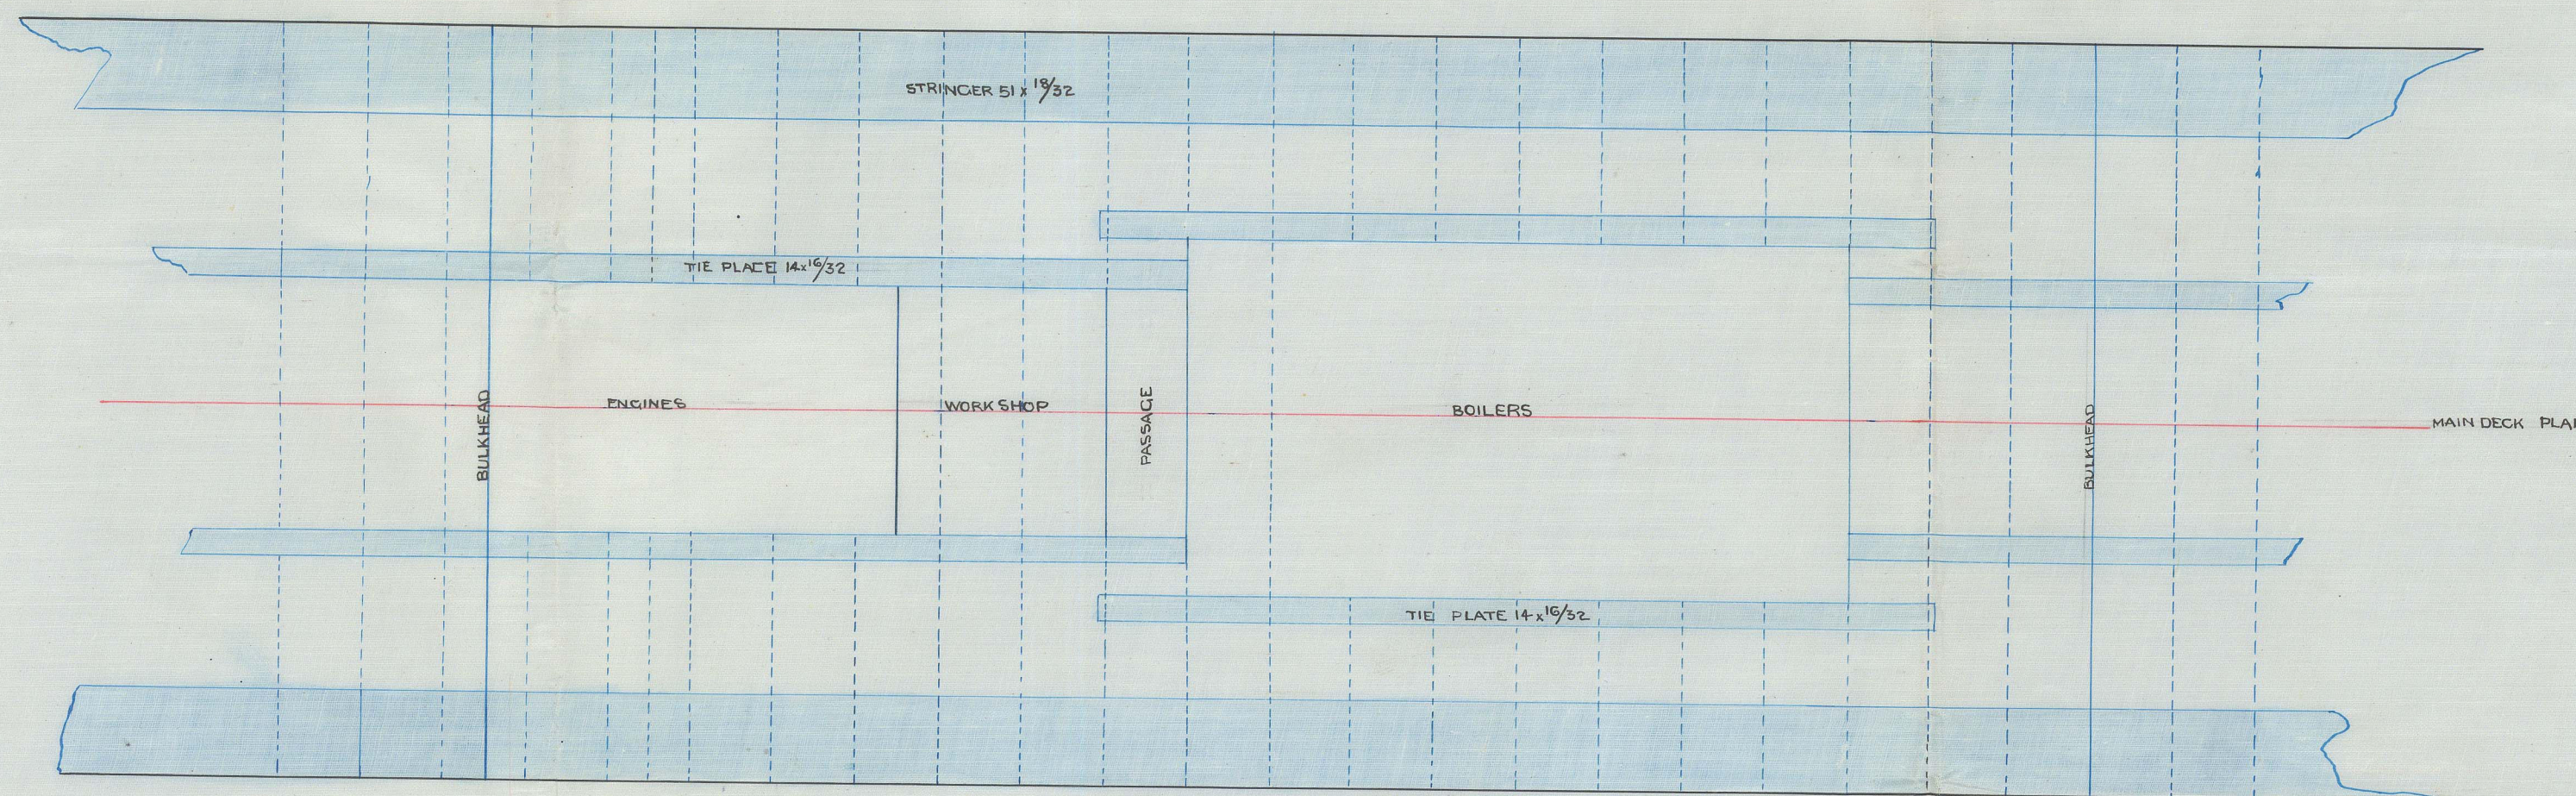
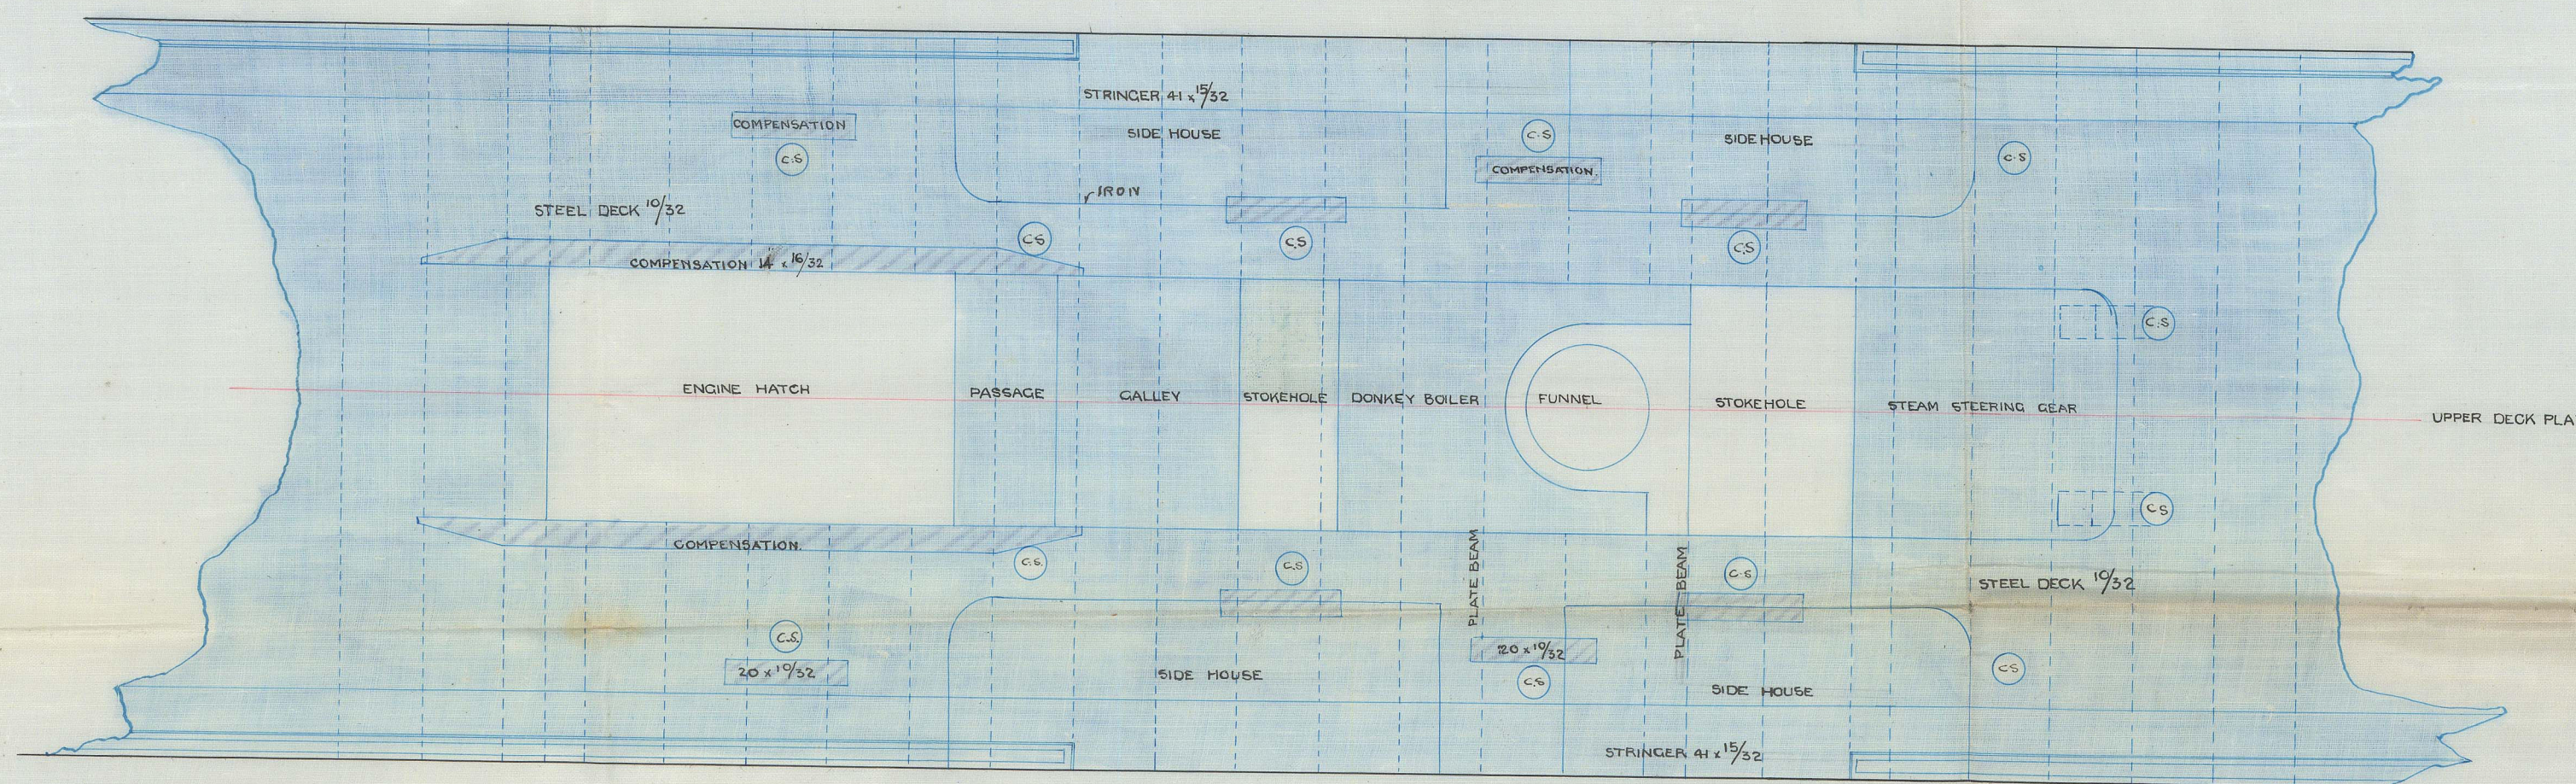
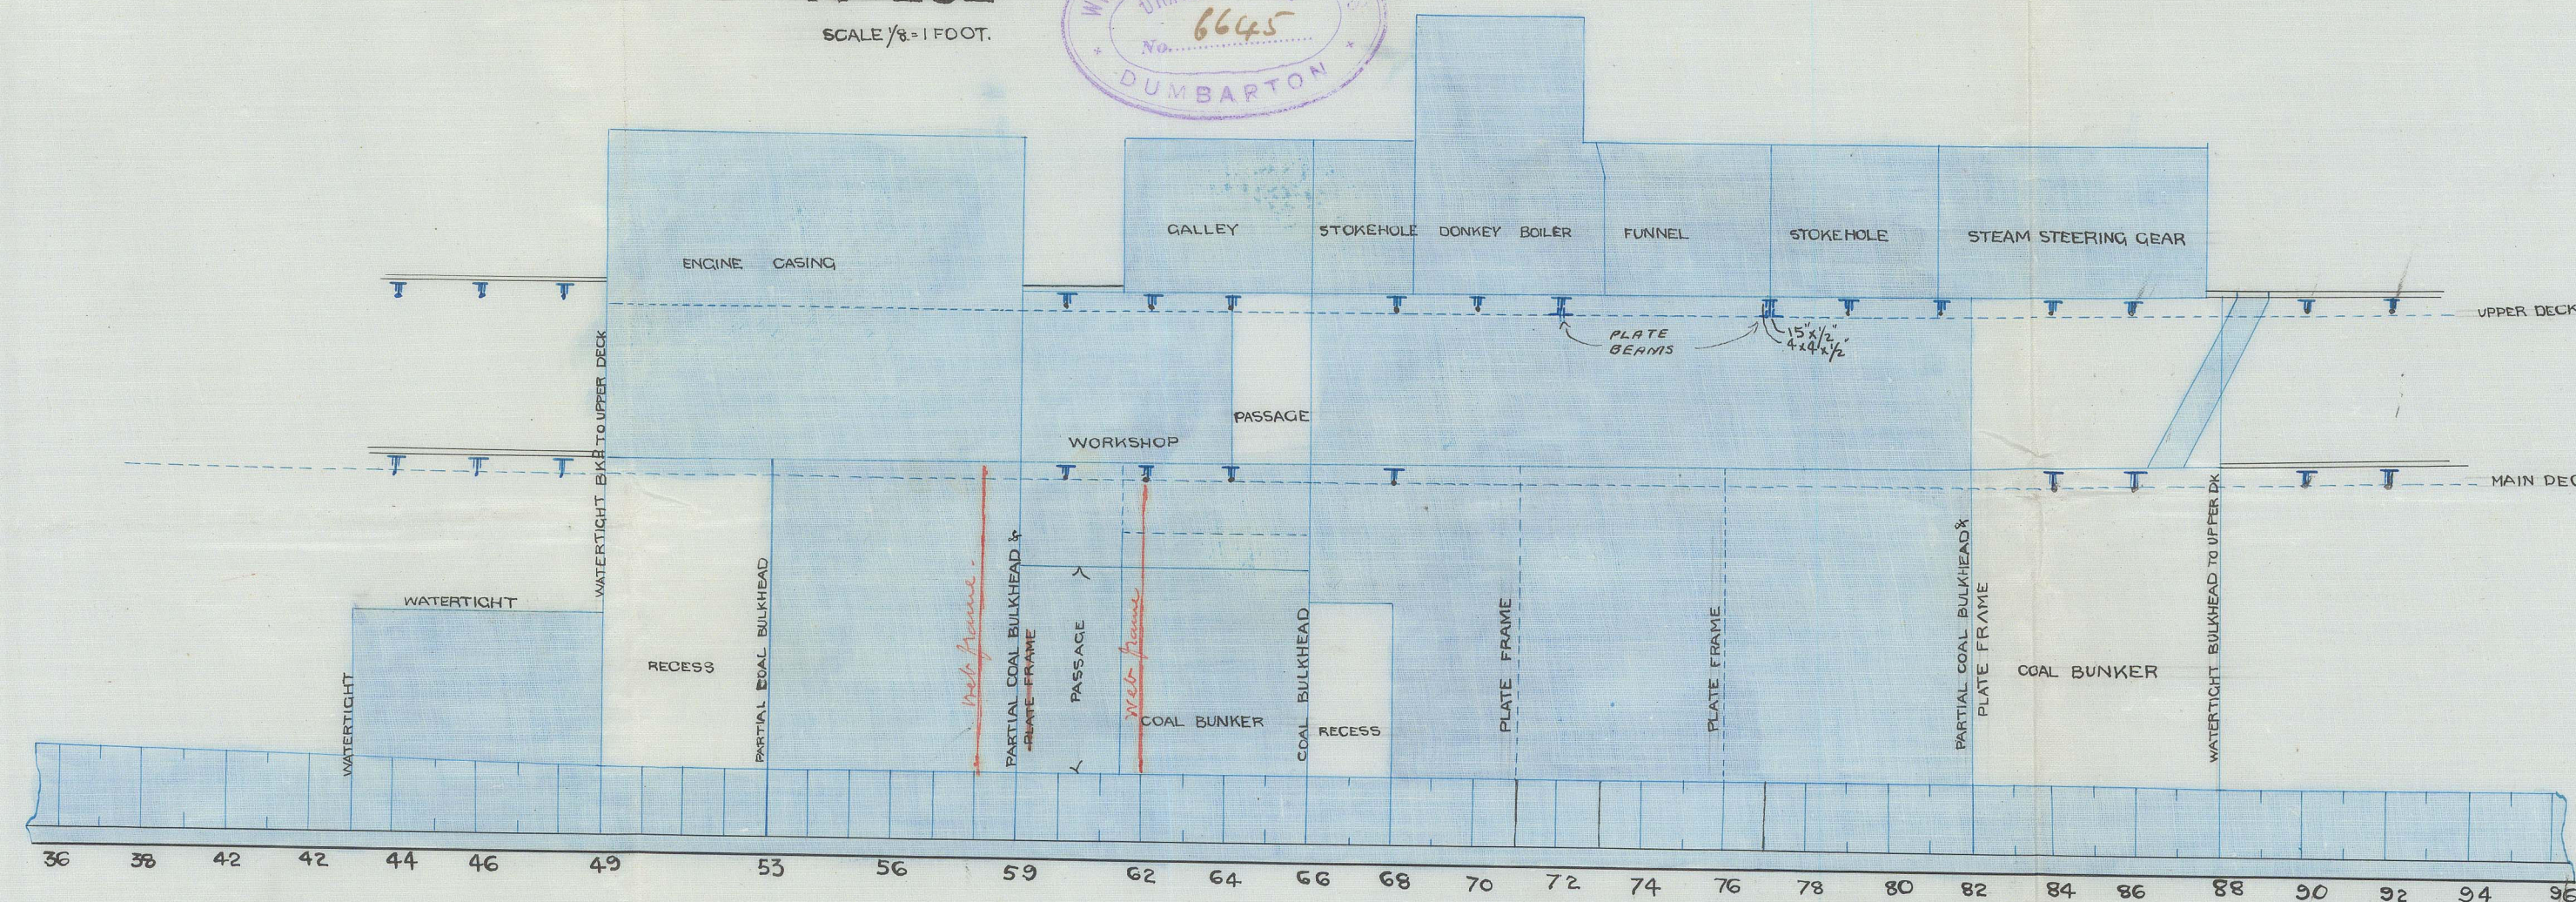


S. S. 'Hauoro'
Glasgow Report No 5871

SKETCH SHEWING MIDSHIP STRENGTHENING


No 262

SCALE 1/8" = 1 FOOT.

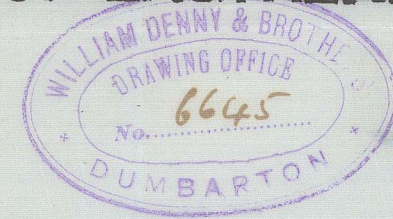

ENGINE & BOILER SPACES

SCALE 1/2" = 1 FOOT.

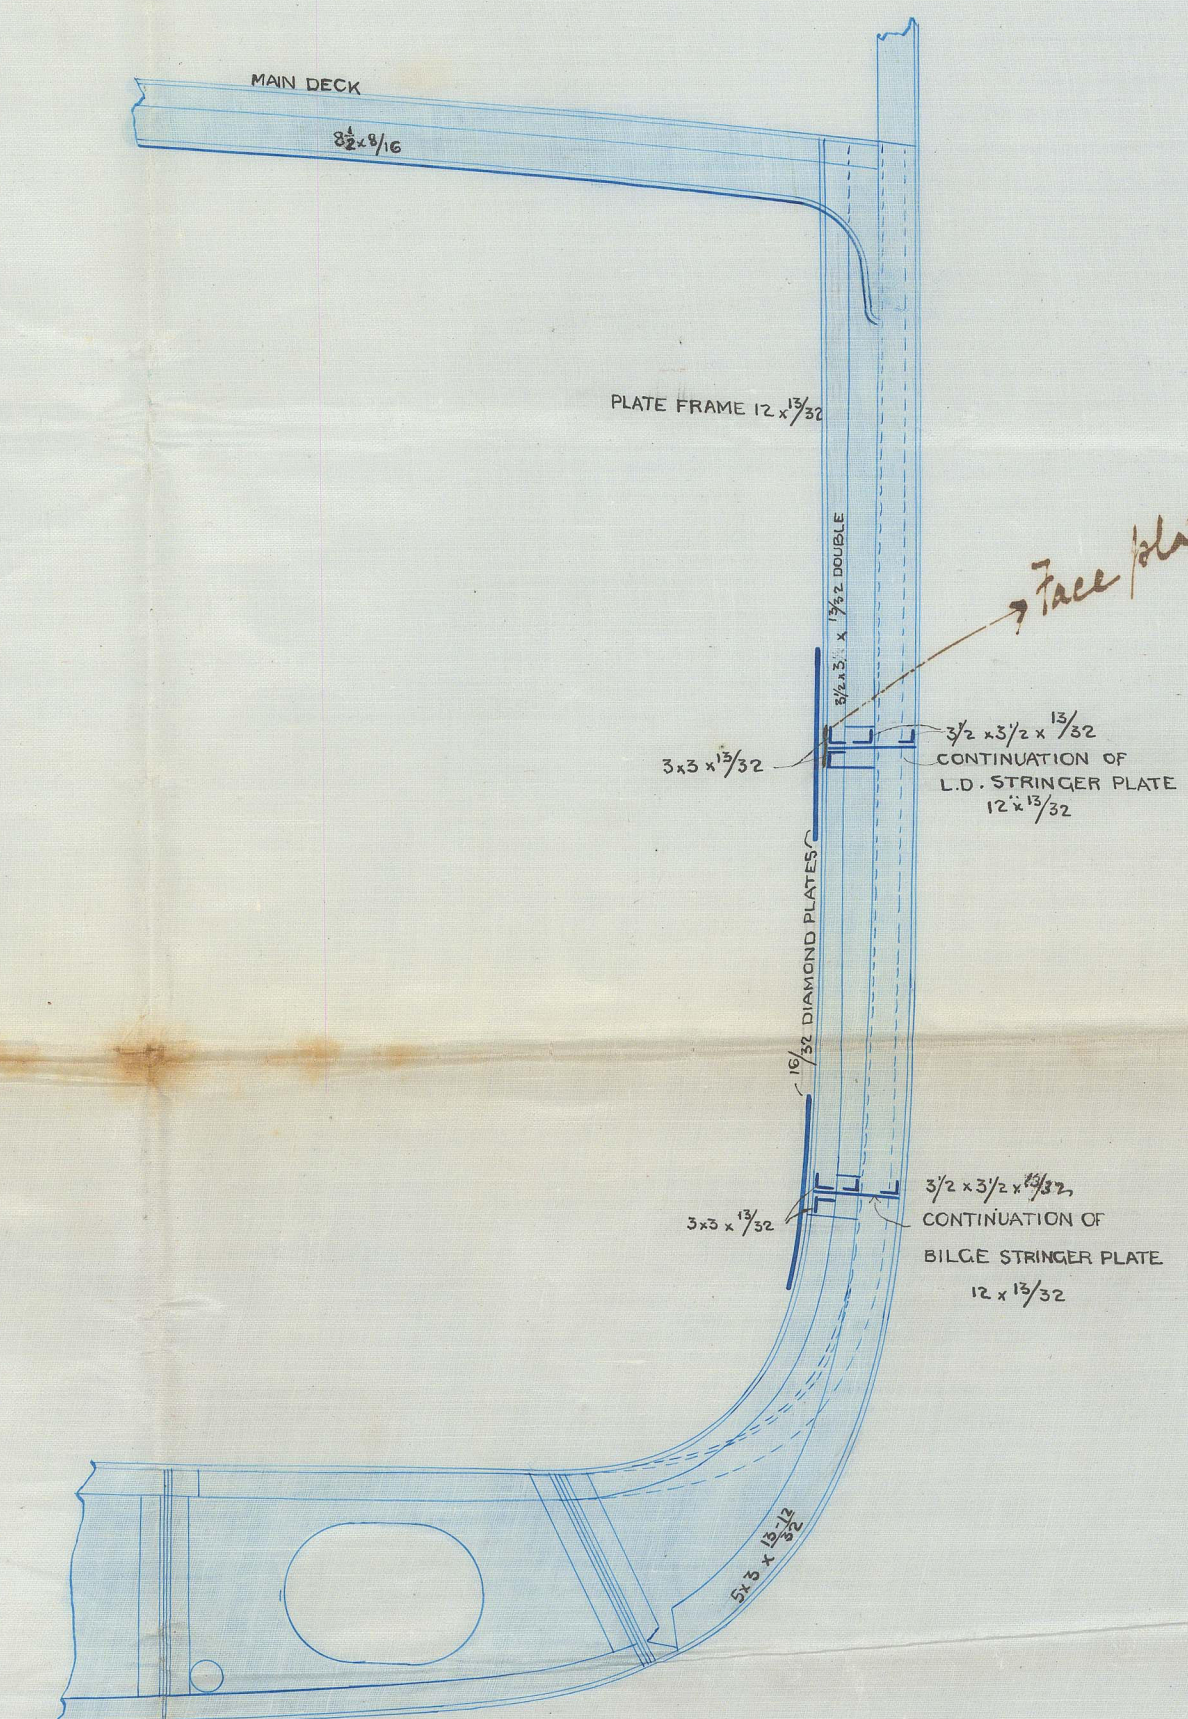

Handwritten signature and date: 22/9/07

GLS192-0063