

85 12/7/82
F.F.E.

— To Class 100 A Spar Decked at Lloyds —



S. S. Liban^o Glasgow Reports
No 5893.

Scale $\frac{1}{2}$ " = one Foot

Principal Dimensions

-300' x 36' x 28' (172)

R. Napier & Son
31d Dec 1887

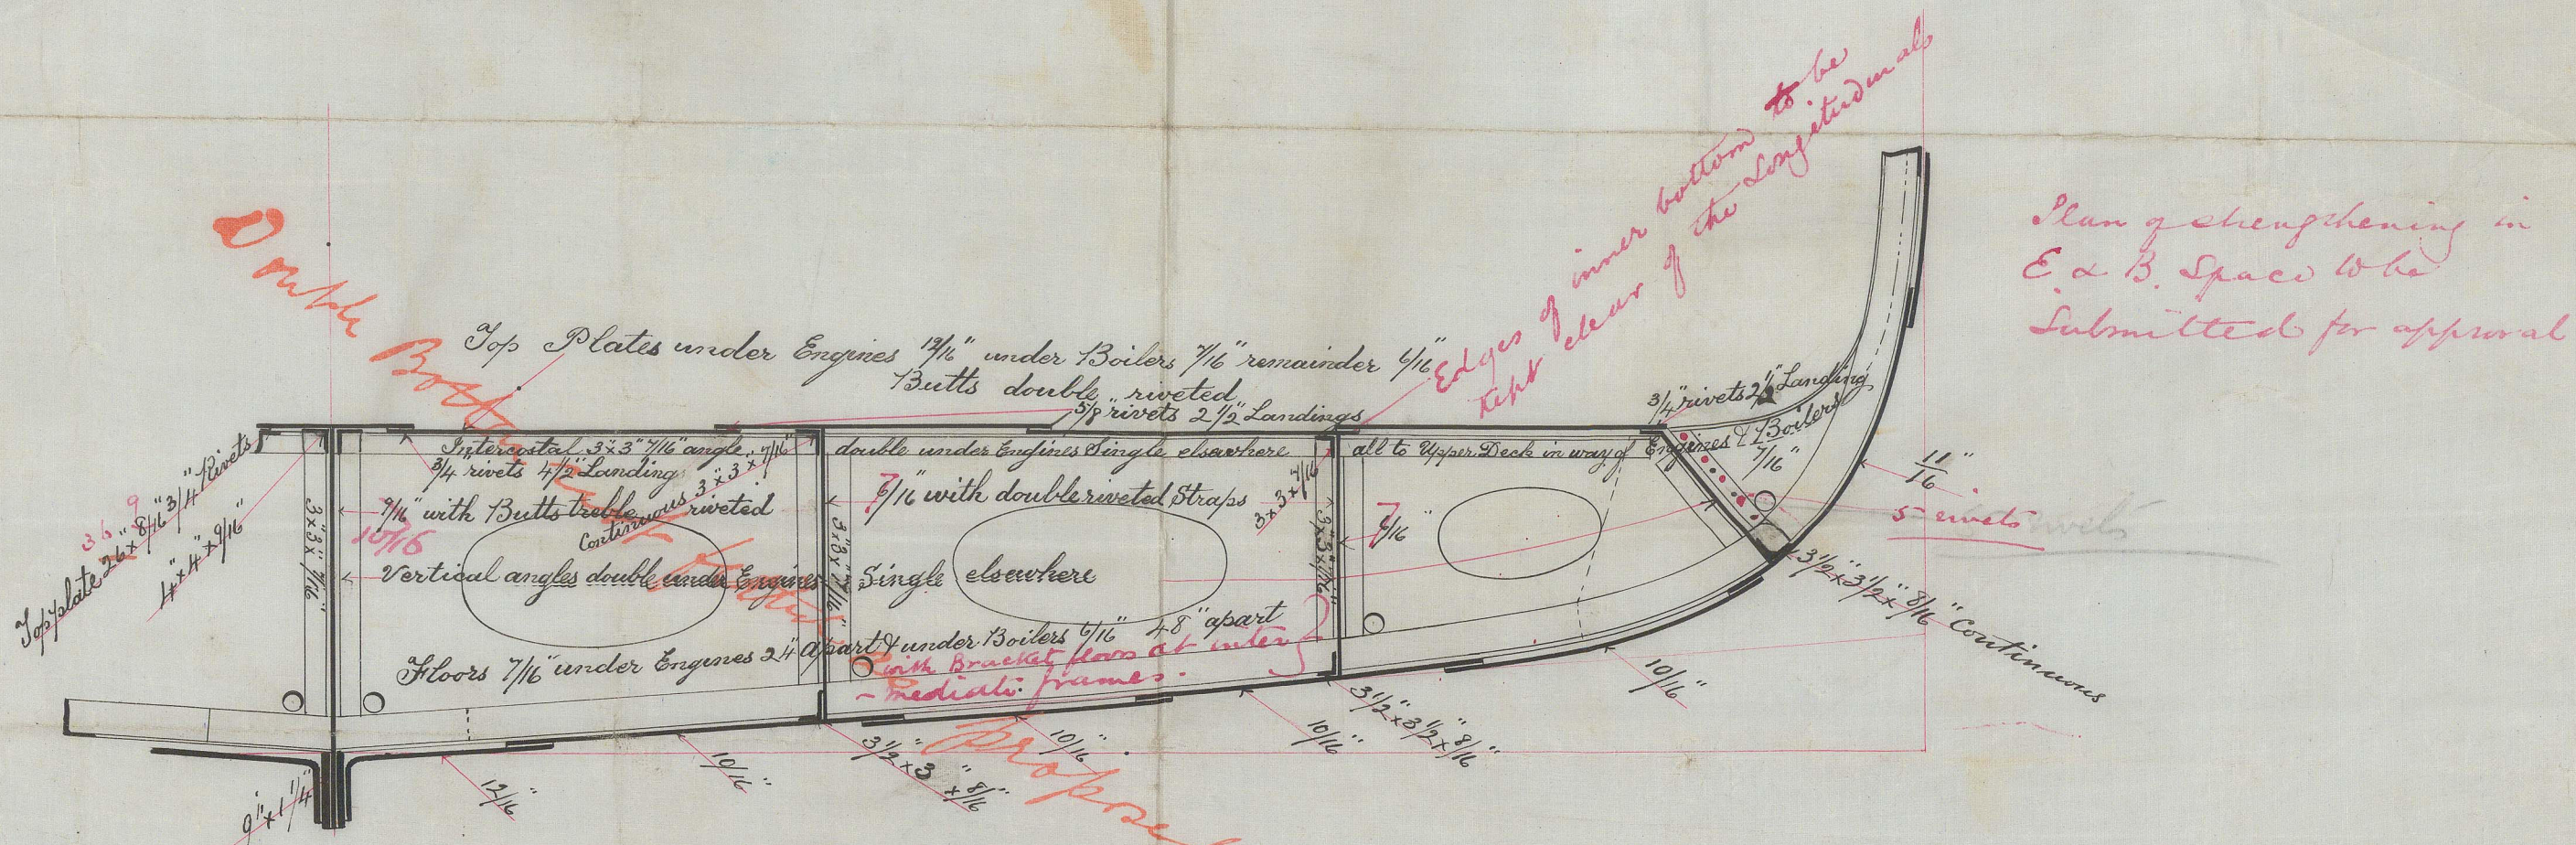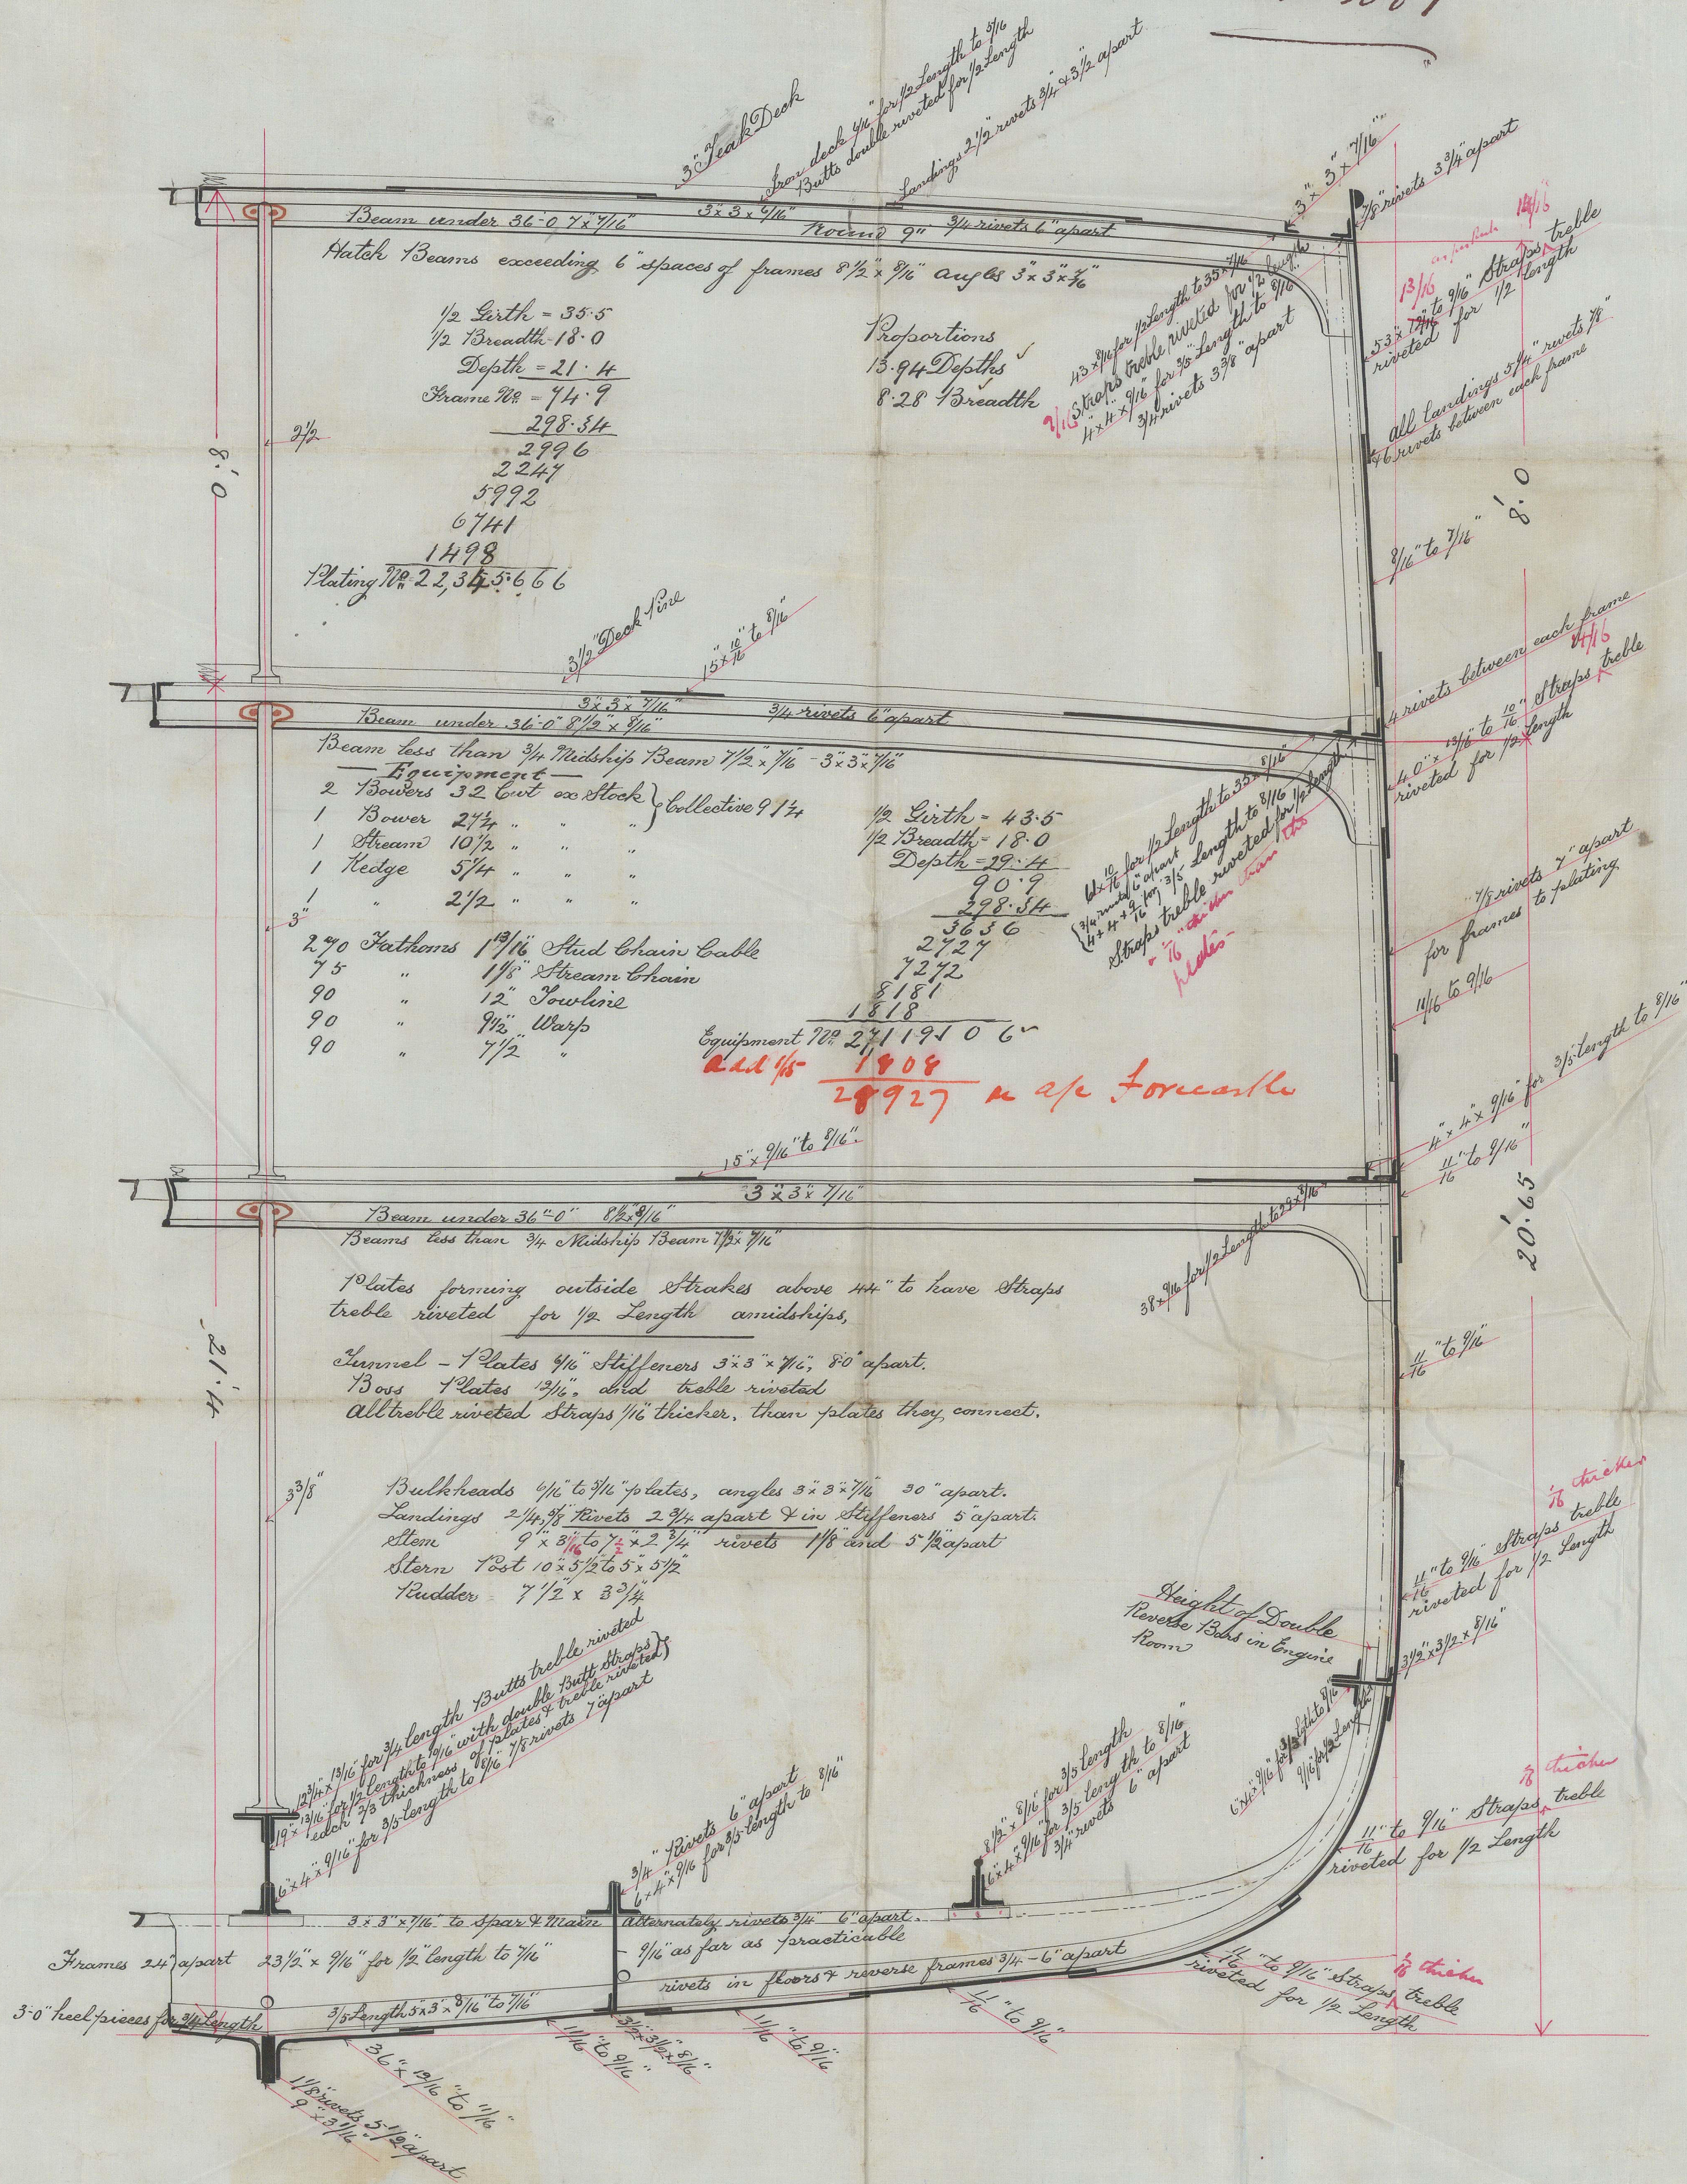

Section through Double Bottom for length of Engines & Boiler Rooms.

57/12/87