

21.4.82

Tracing No 2


S.S. No. 204

S. S. Manuel L. Villaverde
Glasgow Report
No. 5941

Sketch showing Arrangement of Deck Beams & Iron deck & Deck Openings with reference to plan submitted showing arrangement of web frames and strong beams in Engine Room.


Proposed compensation for cargo port.

The shearstrake doubling to be extended aft to 5 feet beyond the port, an angle iron frame 5" x 4" x 3/8" to be fitted round the port, and a bull plate say 12 feet long of 10" x 3/8" to be fitted at lower edge of port.

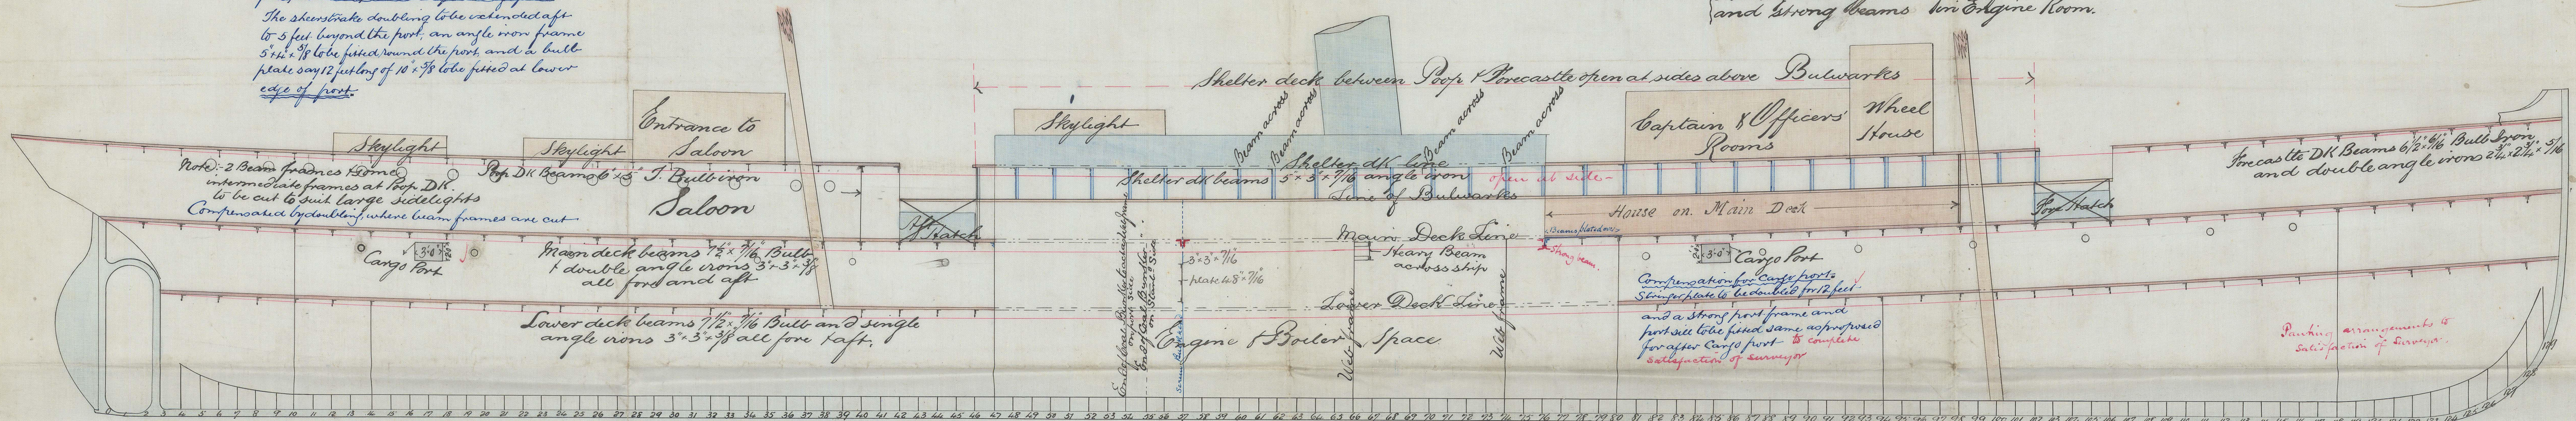

Plan of Main Deck

Scale 1/8" = 1 foot.

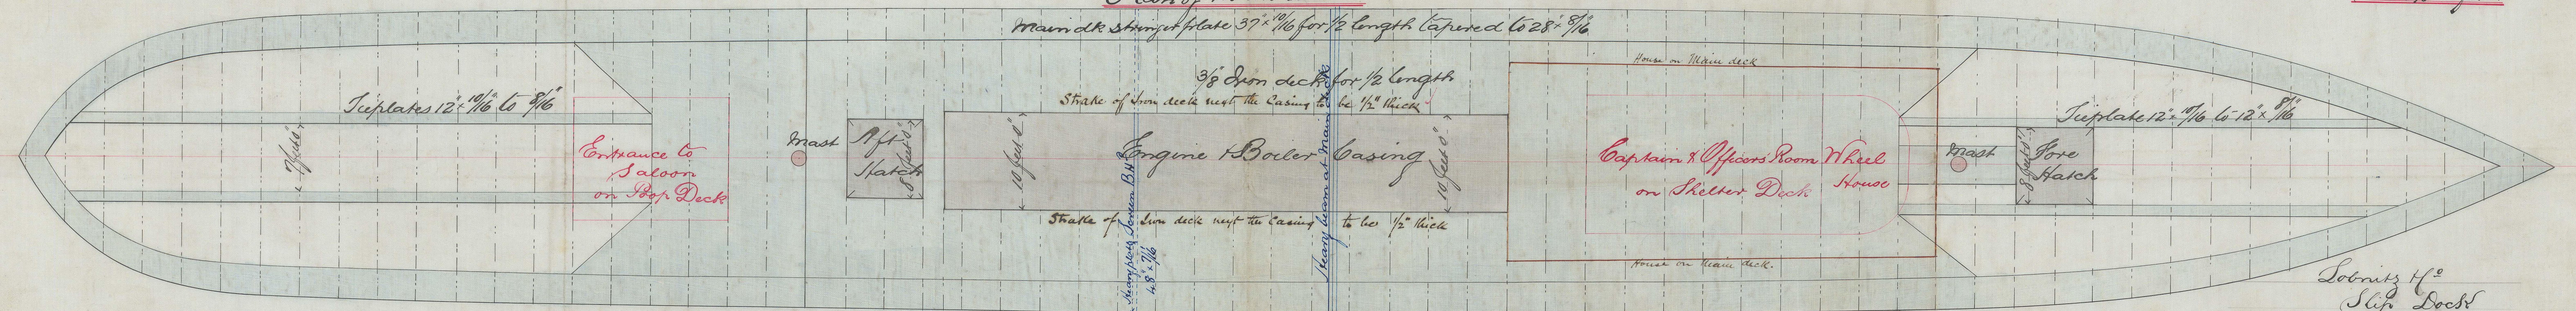

Lochnitz H²
Ship Dock

24.8.20

Lloyd's Register Foundation

GLS192-0099