

S. S. Manuel L. Villaverde "  
Glasgow Report  
No 5941

17.11.81

Scantling in way of Topgallant Forecastle & Shark poop.

~~2 1/2" x 5" Deck.~~

9"  $\frac{7}{16}$ " Forecastle Triplate




# MIDSHIP SECTION

No. 204

Length from fore side of Sternpost to aft side of Stern 238 feet 8"  
Breadth over frames 31 feet 8.34 Breadth in Length.  
Depth from top of Keel to top of Main Deck Beam 15 ft 9 13.7 Depth in "  
Depth to Hurricane Deck 26 feet 3"

Every alternate frame carried in way of Bridge.  
Every frame comes up in way of Roof and  
Top gallant Forecastle.

Two Decked Glass 100 A.I. with Shelter deck as per Small Sketch.

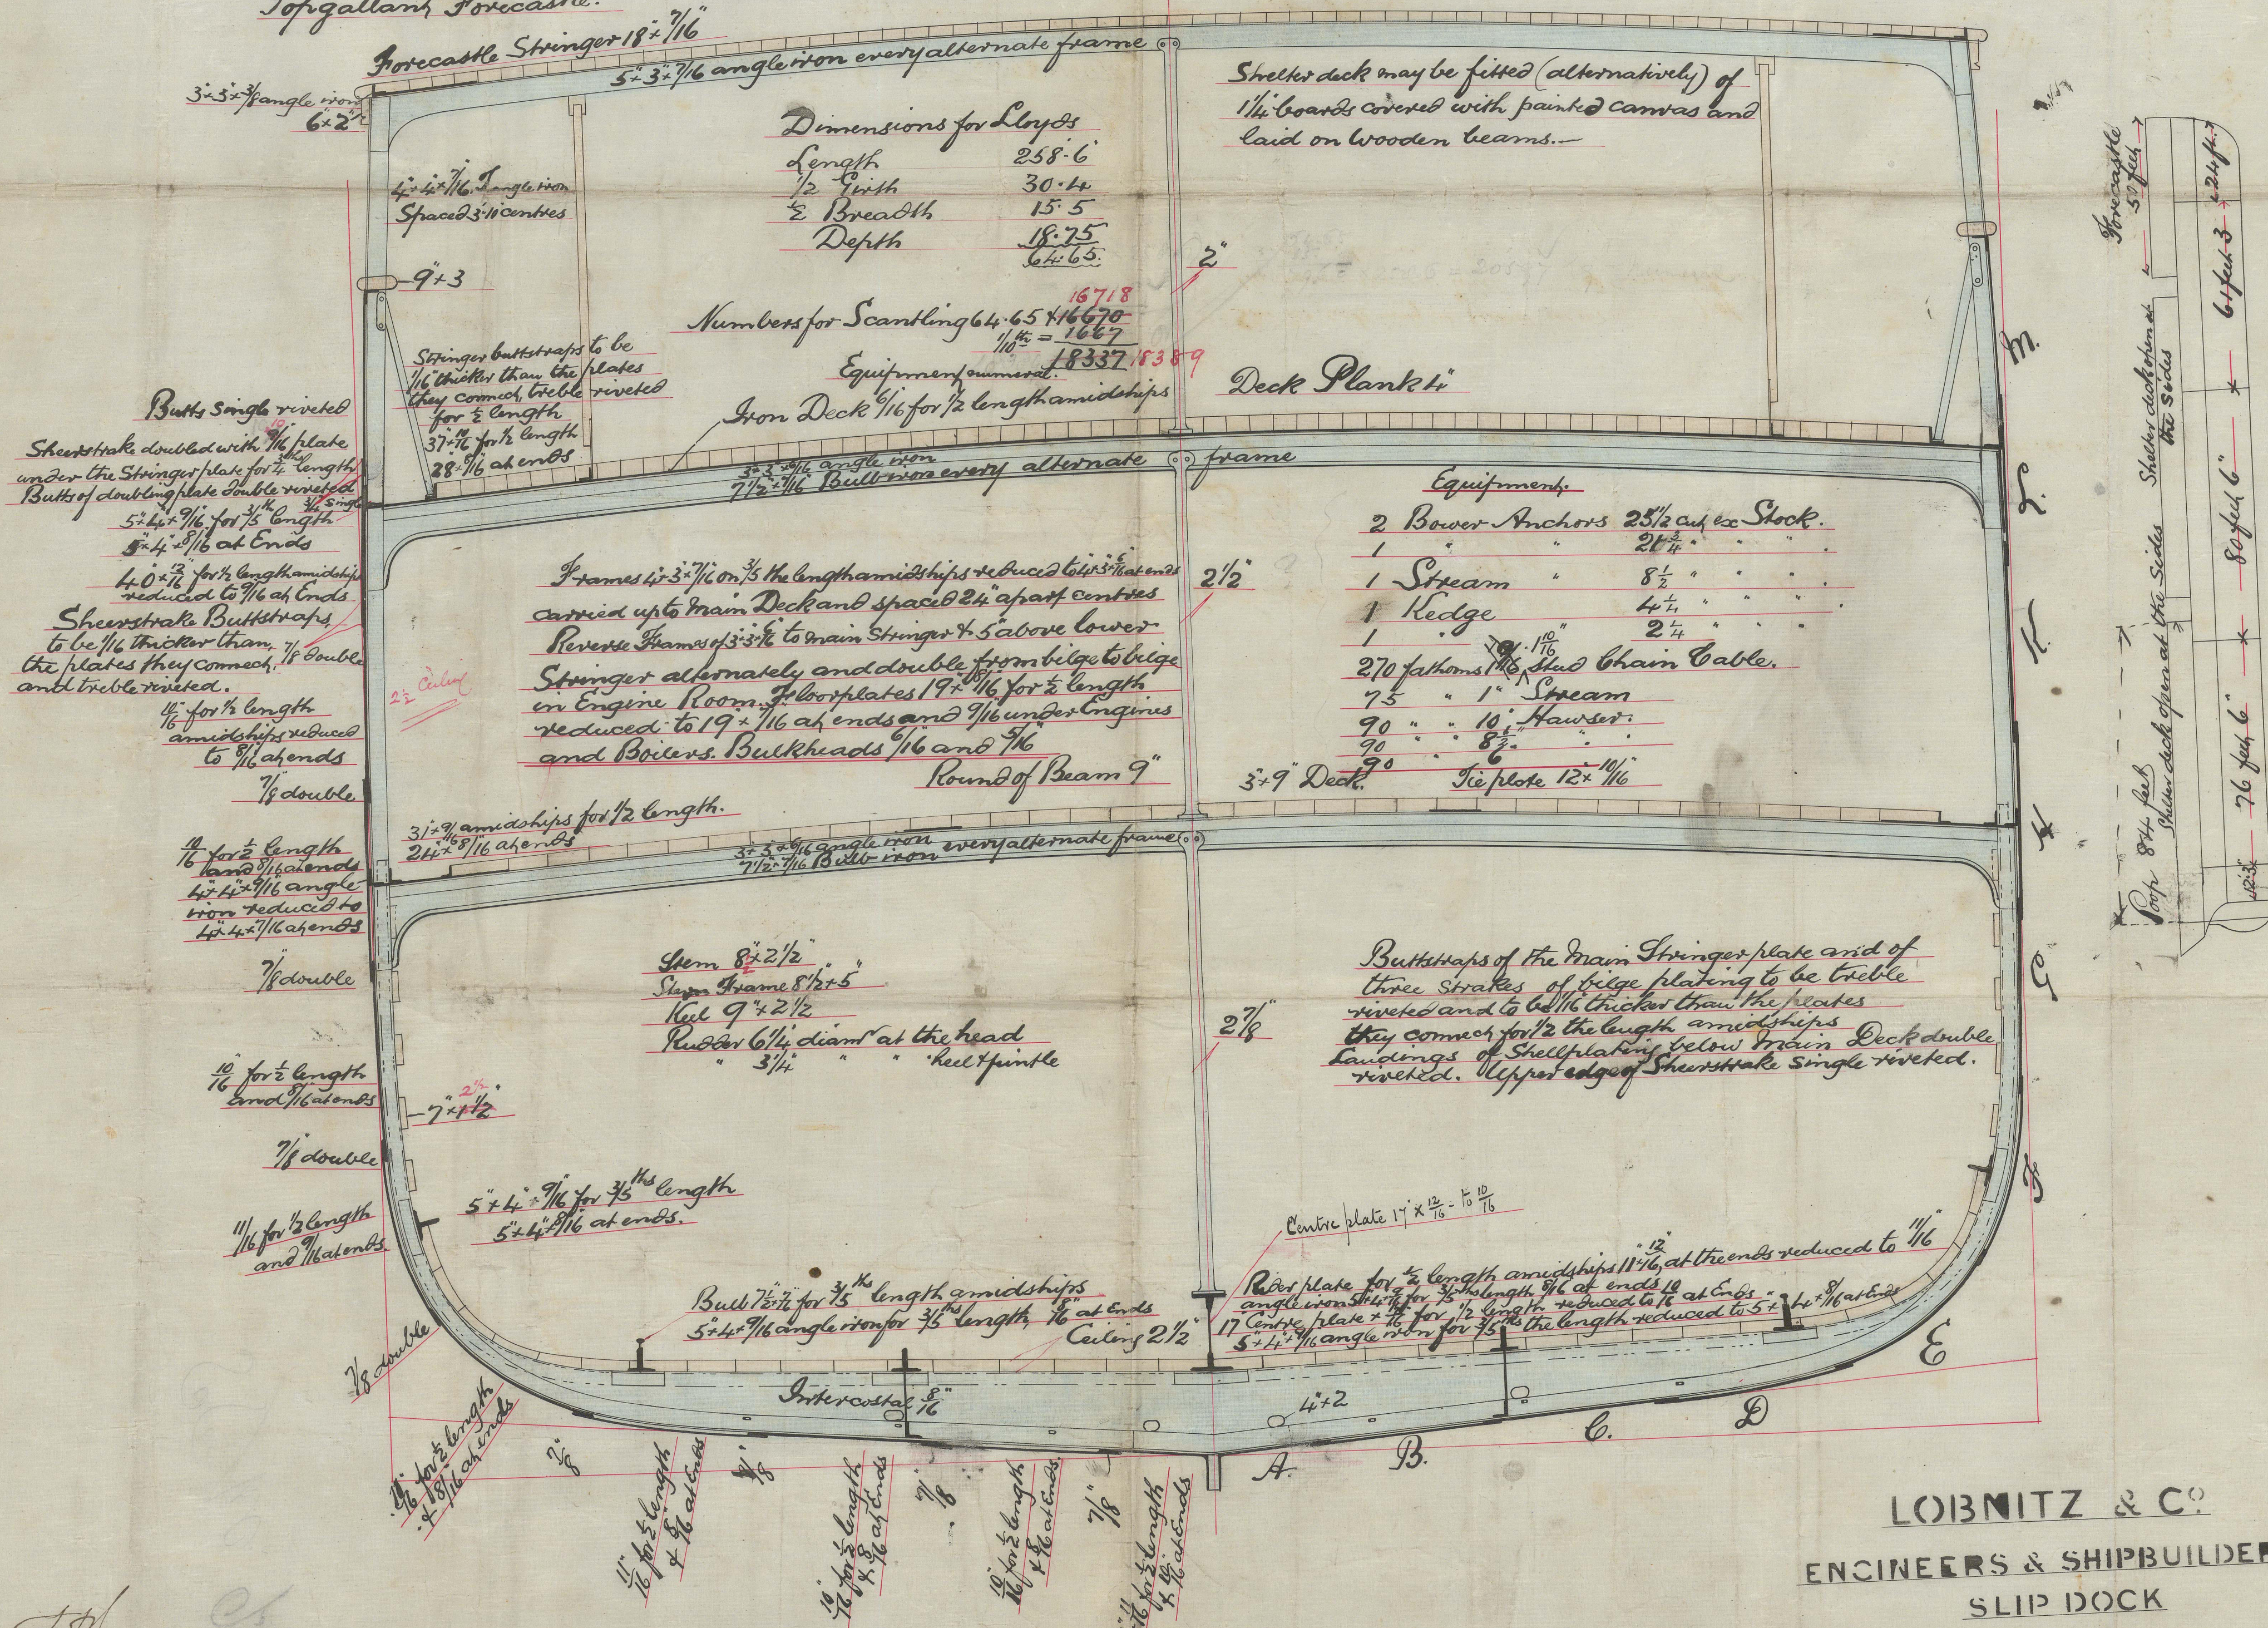

LOBNITZ & CO.

ENGINEERS & SHIPBUILDERS  
SLIP DOCK

RENFREW. 10<sup>th</sup> Nov 1881. B.D.

SCALE 1/2 INCH TO ONE FOOT

© 2021

Lloyd's Register  
Foundation