


S. S. N^o 204.


S. S. Manuel L. Villaverde
Glasgow Report
No. 5941

Am.
23/11/82

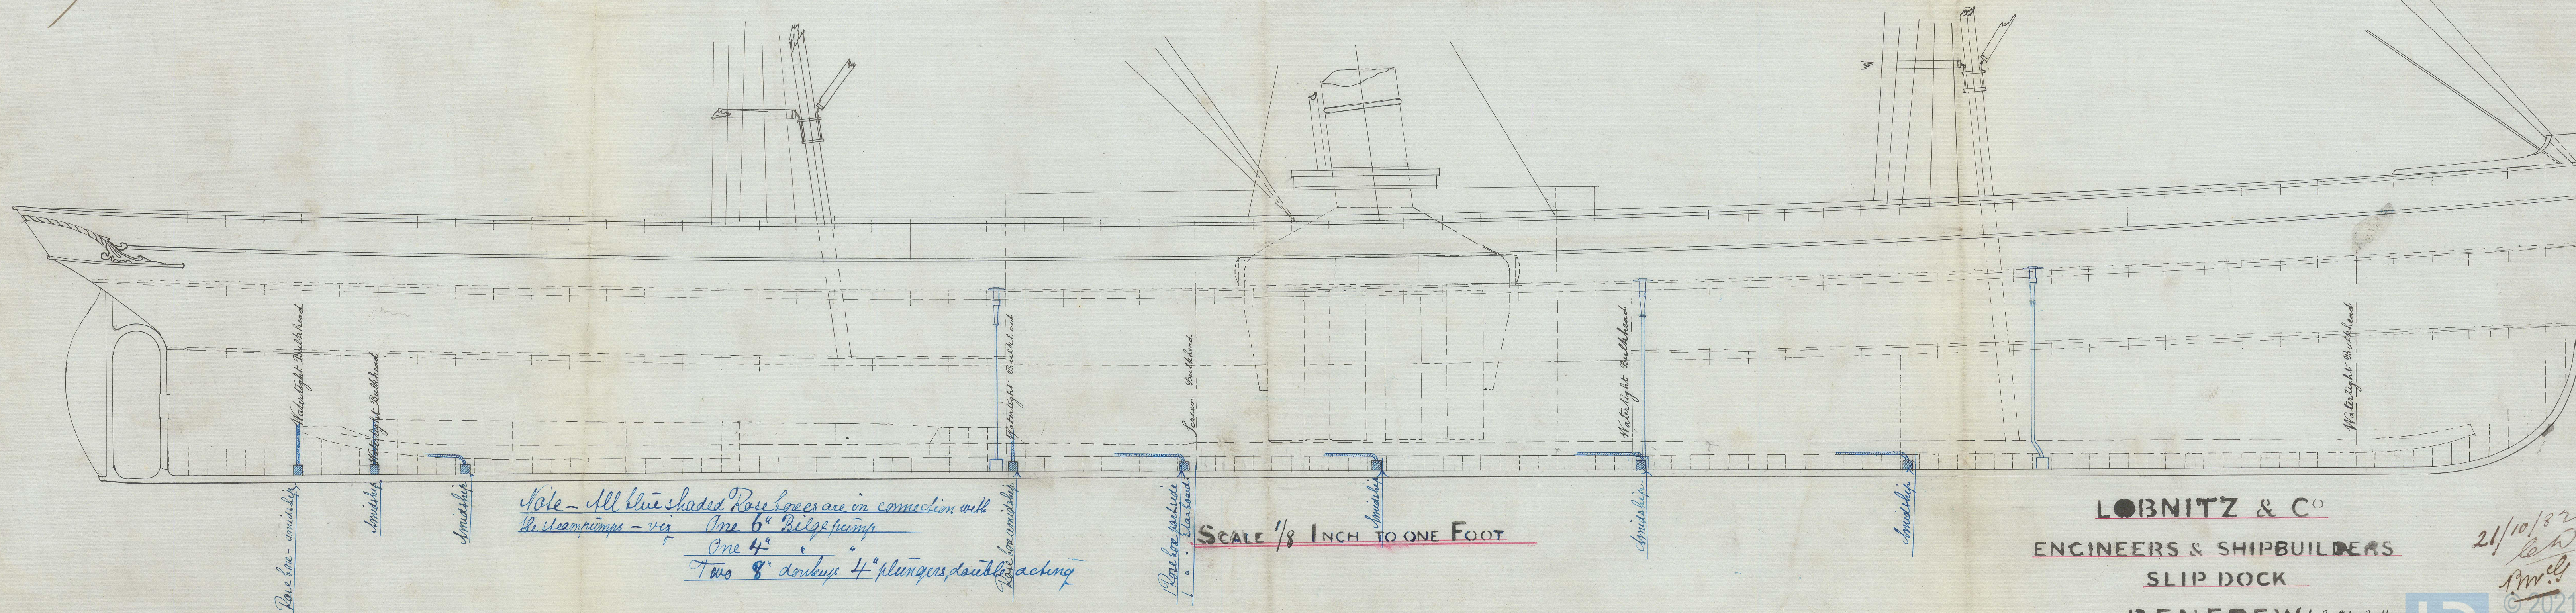

LOBNITZ & CO
ENGINEERS & SHIPBUILDERS
SLIP DOCK

RENFREW 1. 9. 82. A. 16.

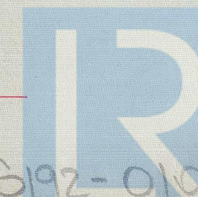

Lloyd's Register
Foundation

21/10/82
L. W.
1 m. cl.