


all steel plates
W. Banks (owners)

HUTSON, & CORBETT,
KELVINHAUGH ENGINE WORKS,
GLASGOW. 1/2/82

Im. G.
 3/2/82
 ely de dist

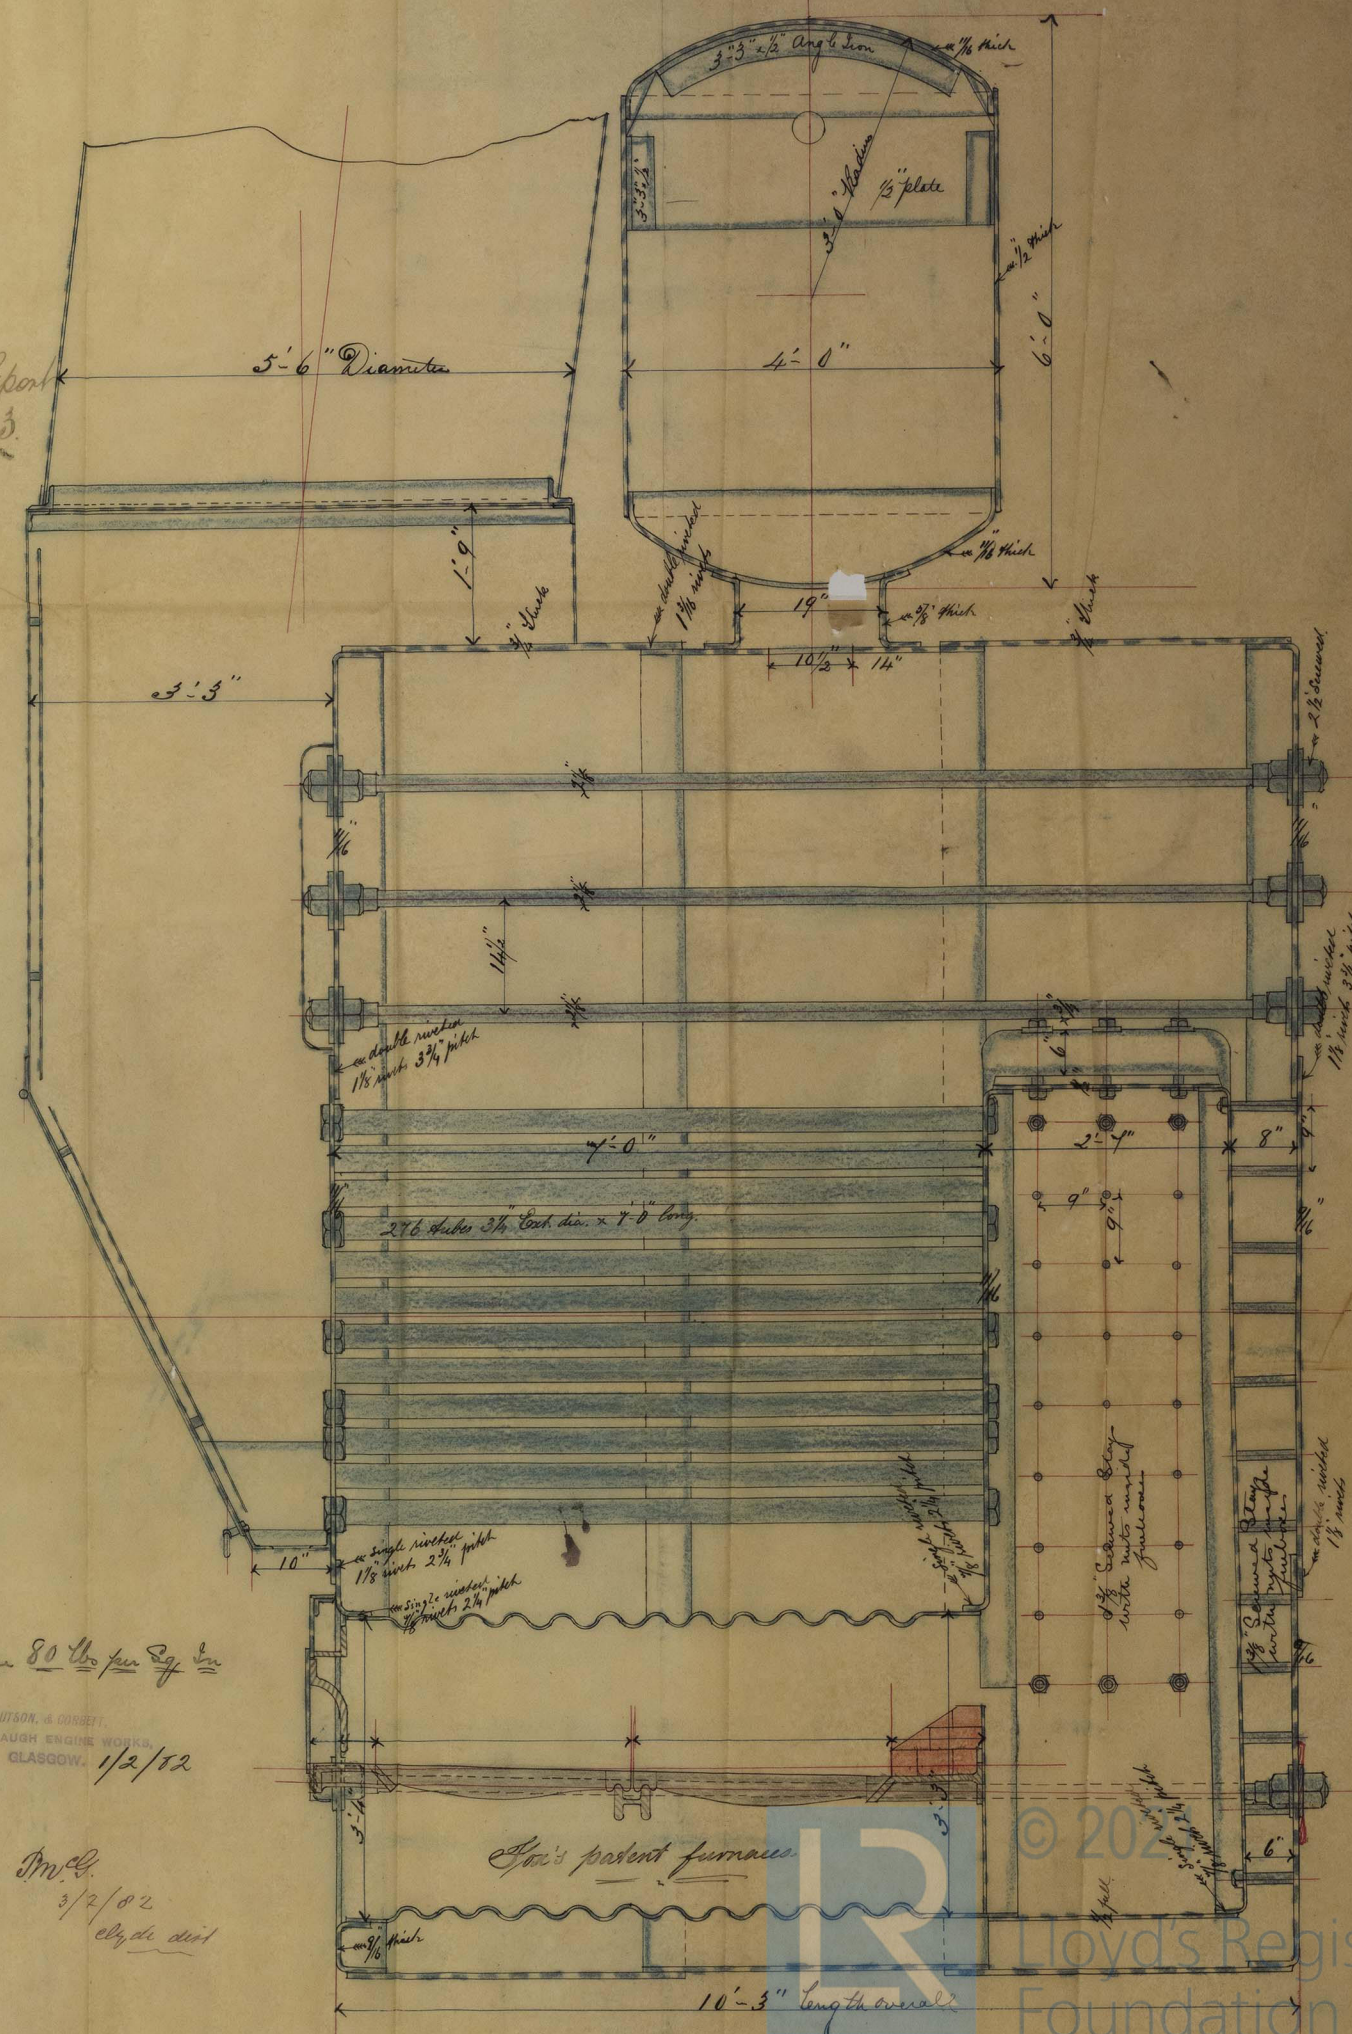

GLS192-0130

