


See Amended Section



S S N° 230

SCALE $\frac{1}{2}$ INCH

Alterations and additional strengthening to section
approved 17th Oct. 1881

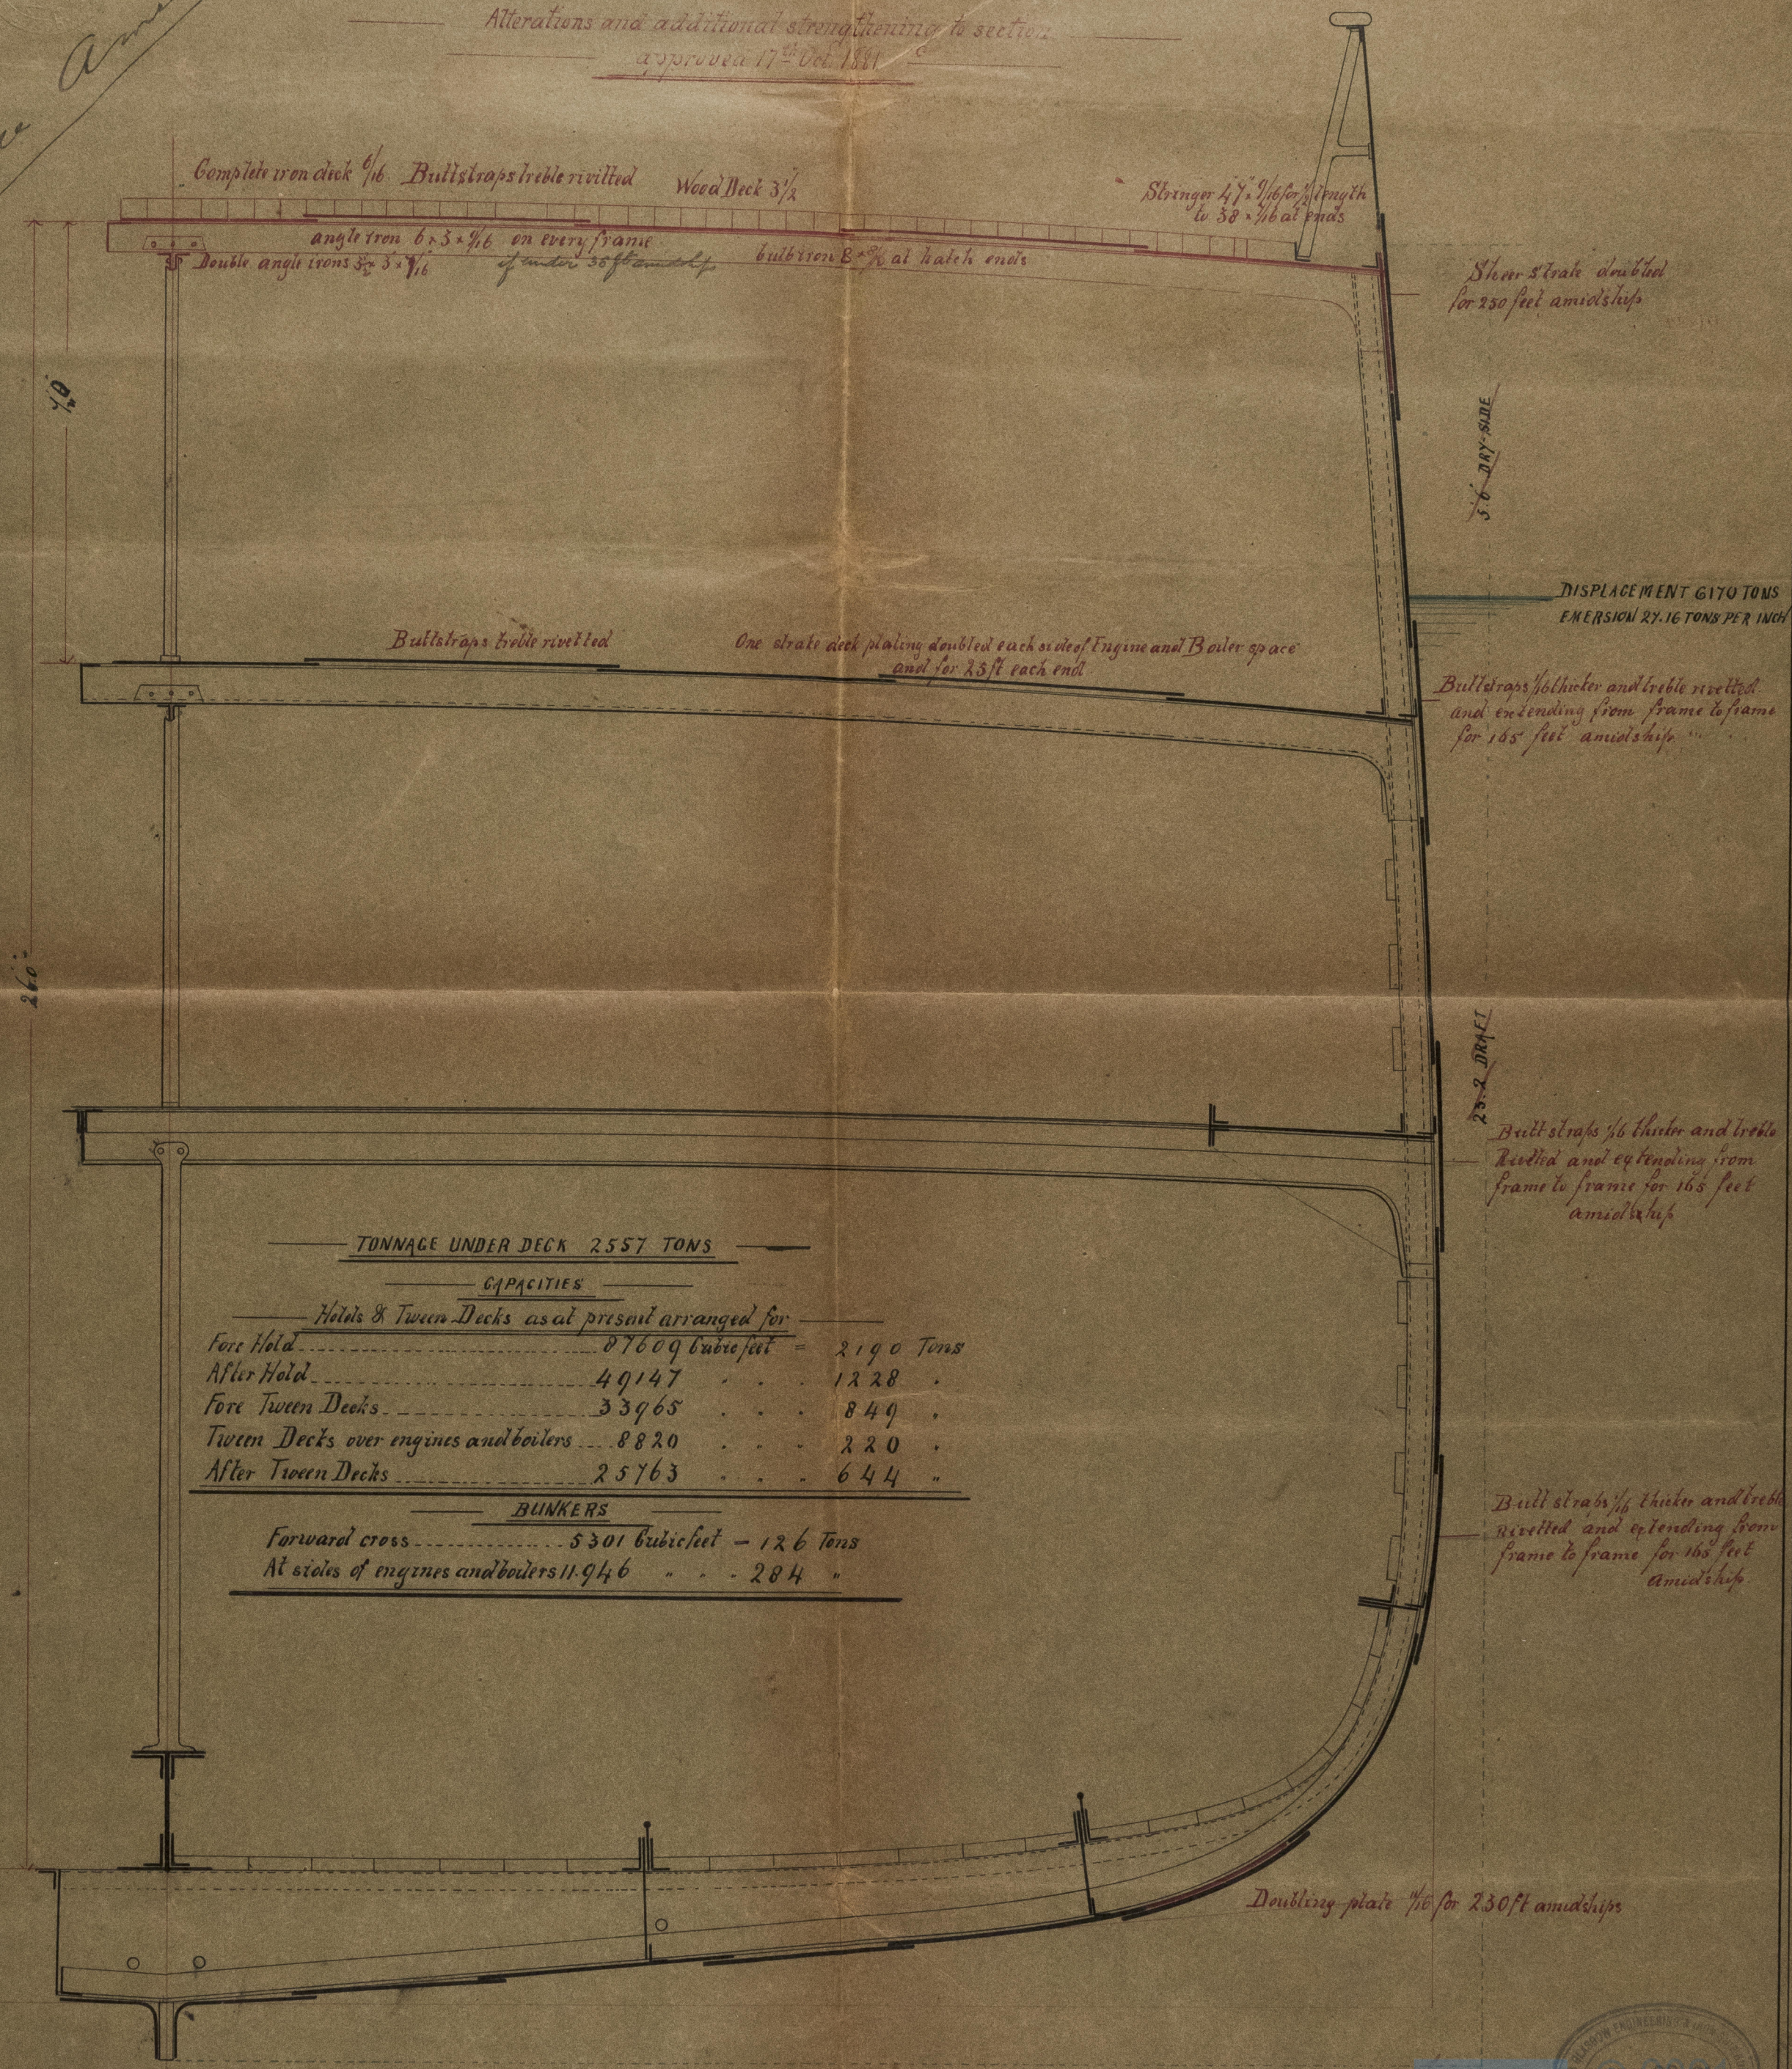

TONNAGE UNDER DECK 2557 TONS

CAPACITIES

Holds & Tween Decks as at present arranged for

Fore Hold	87609 cubic feet	=	2190 Tons
After Hold	49147	.	1228
Fore Tween Decks	33965	.	849
Tween Decks over engines and boilers	8820	.	220
After Tween Decks	25763	.	644

BUNKERS

Forward cross	5301 cubic feet	=	126 Tons
At sides of engines and boilers	11946	.	284

26/11/81



Lloyd's Register Foundation

C15192-0133