

S.S. "Tarawera" - Glasgow Report No. 5917 -
 S.S. "Waihora" - " " " " 5948 -

5.1.82





PEAK BULKHEADS

S.S. 285 x 36 x 25

No. 2634

SCALE 1/8" = 1 FOOT.

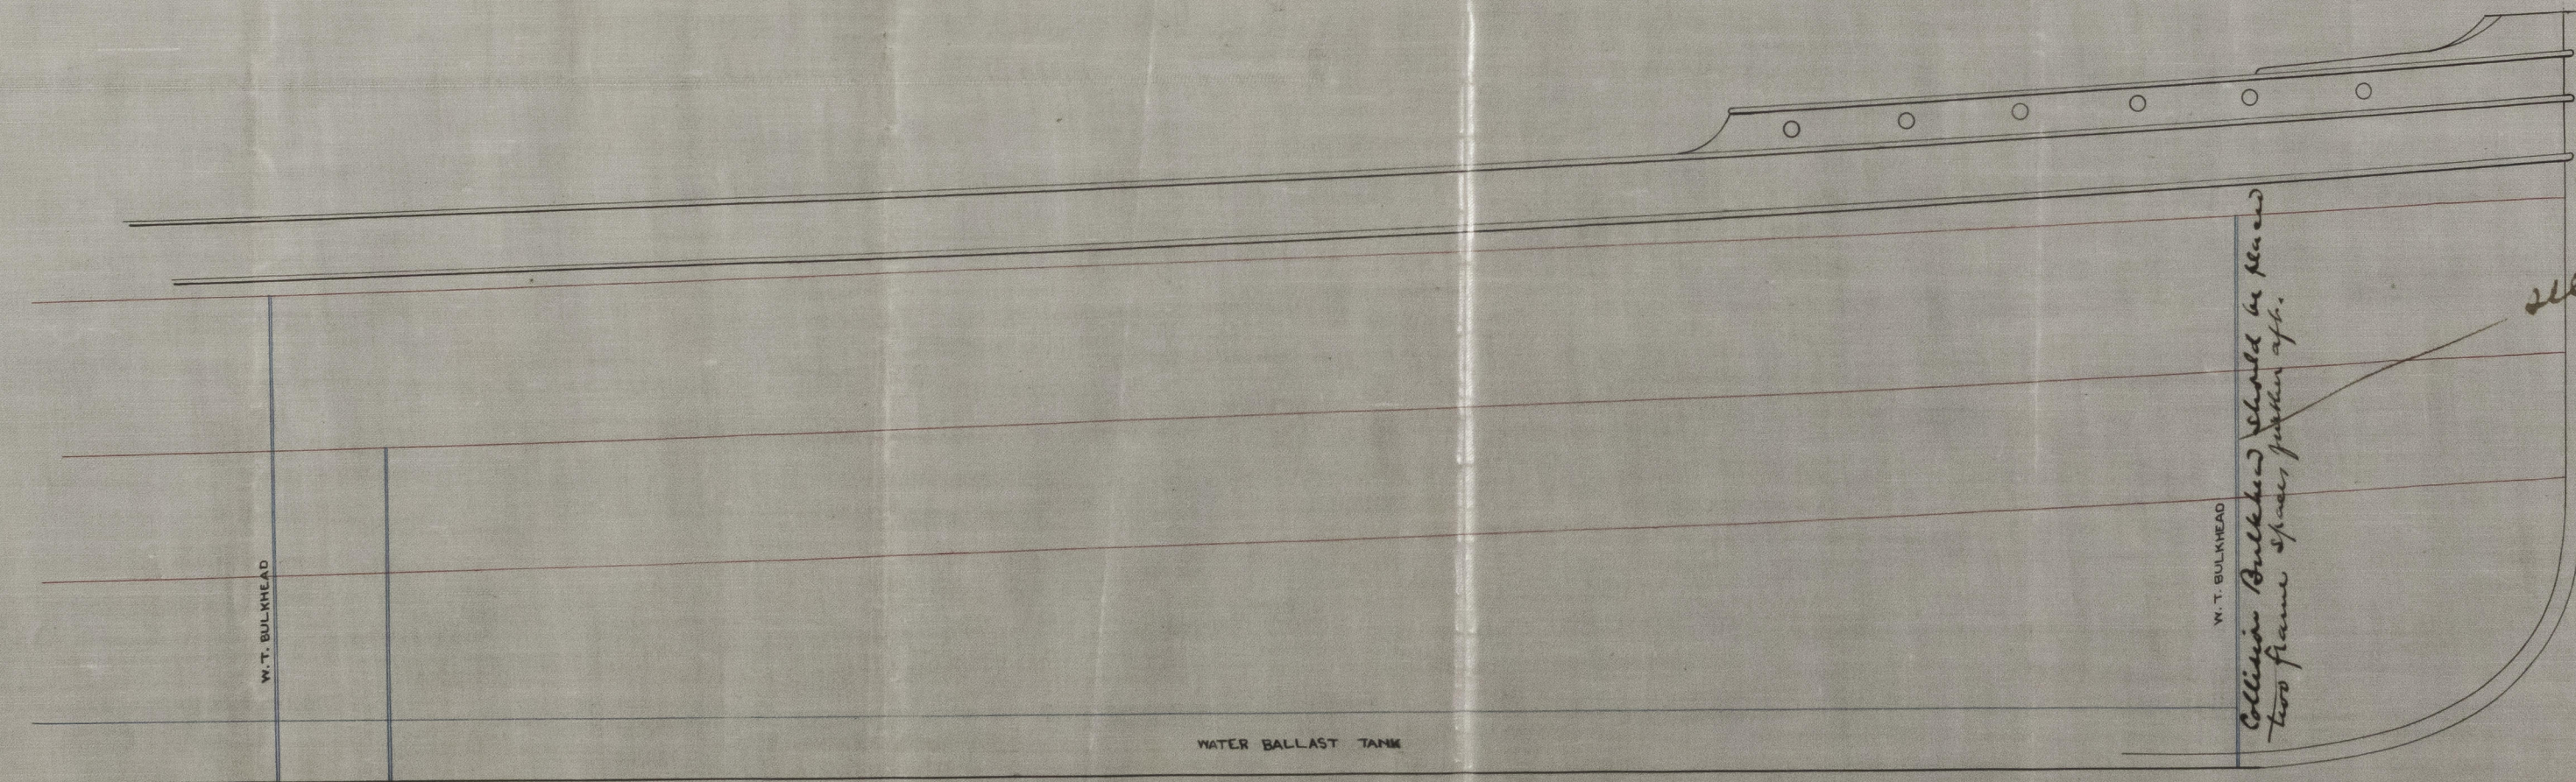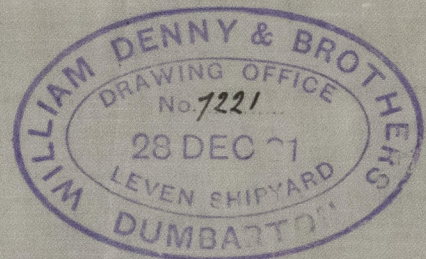

see amended sketch
 J.P.

J.H.
 2/1/82



© 2021

Lloyd's Register
 Foundation

4LS193-0009