




Dr. to Gls. 20/2/82.

S.S. "Kawatiro" Glasgow Report N<sup>o</sup> 5894.  
S.S. "Crowaiti" do do 6008.

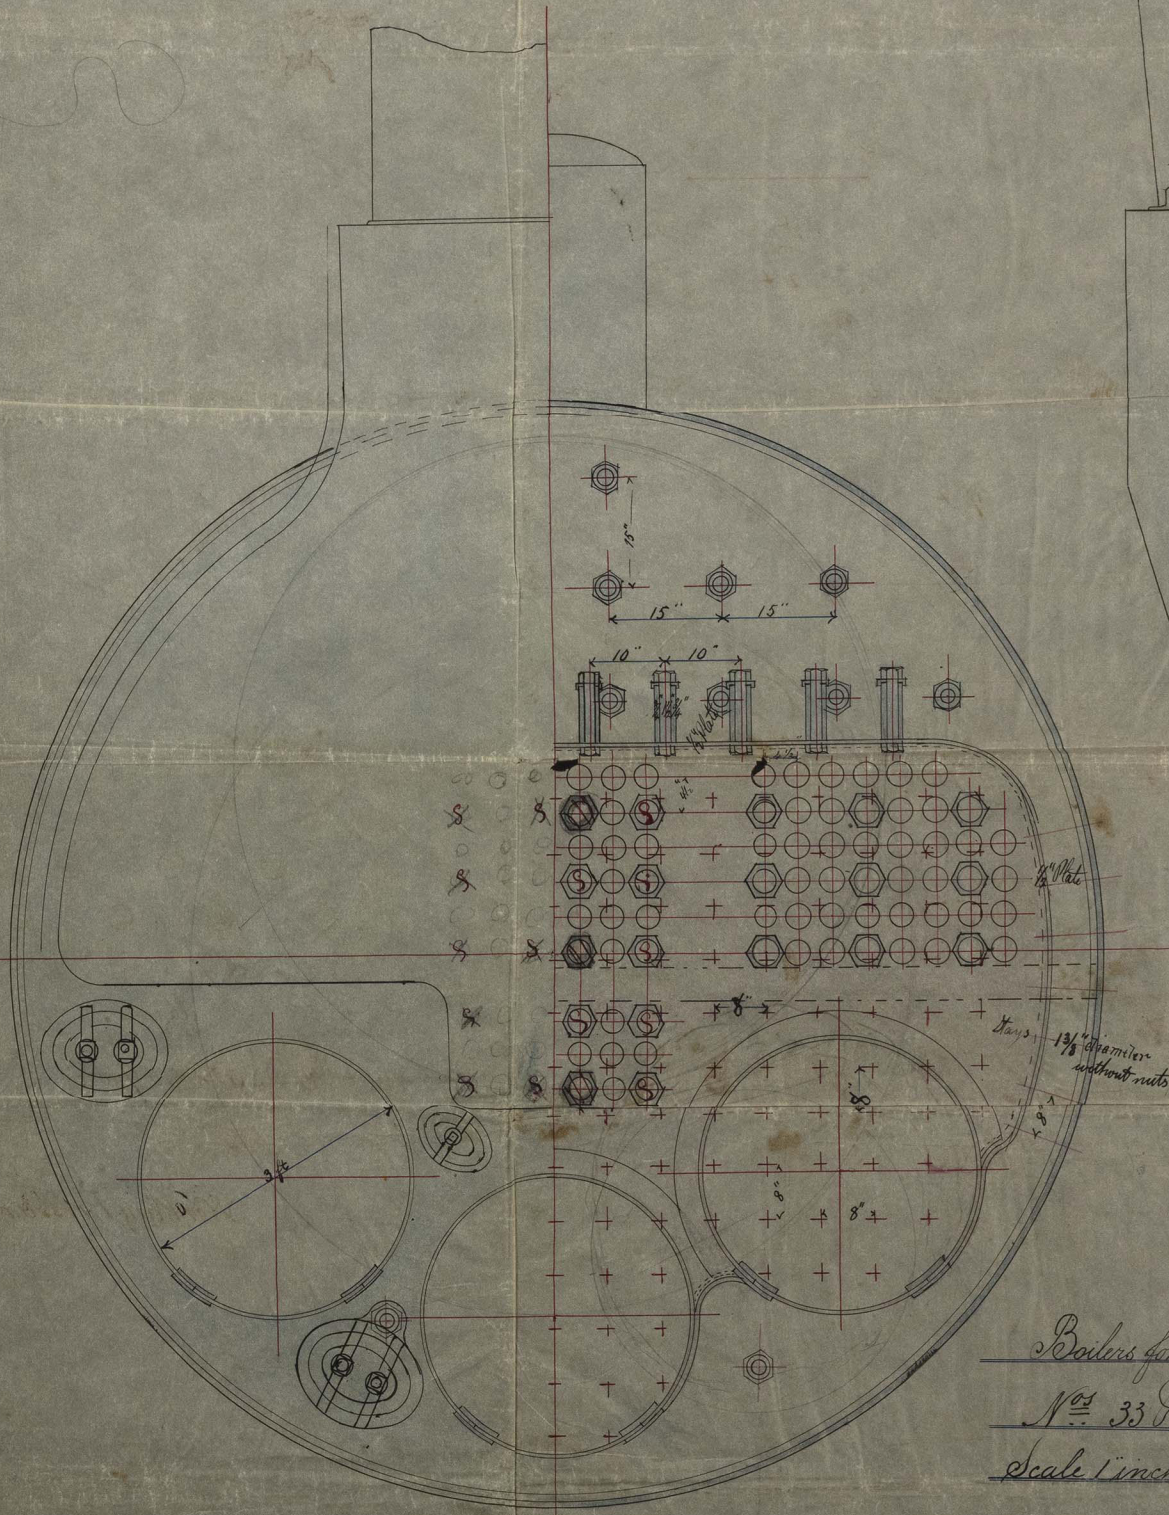

Boilers for Engines  
Nos 33 & 34  
Scale 1 inch to the foot

FLEMING & FERGUSON,  
ENGINEERS AND BOILER MAKERS,  
PAISLEY.

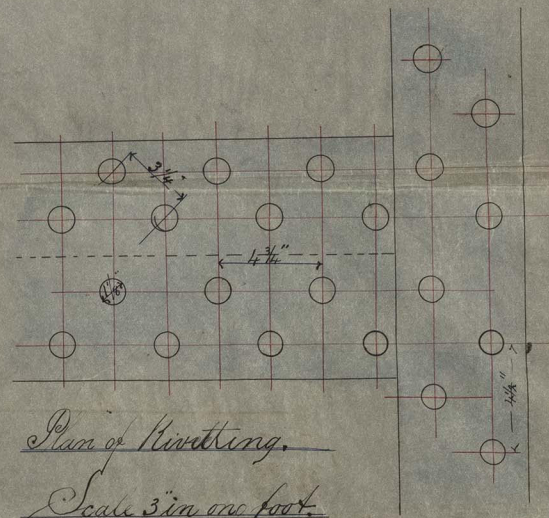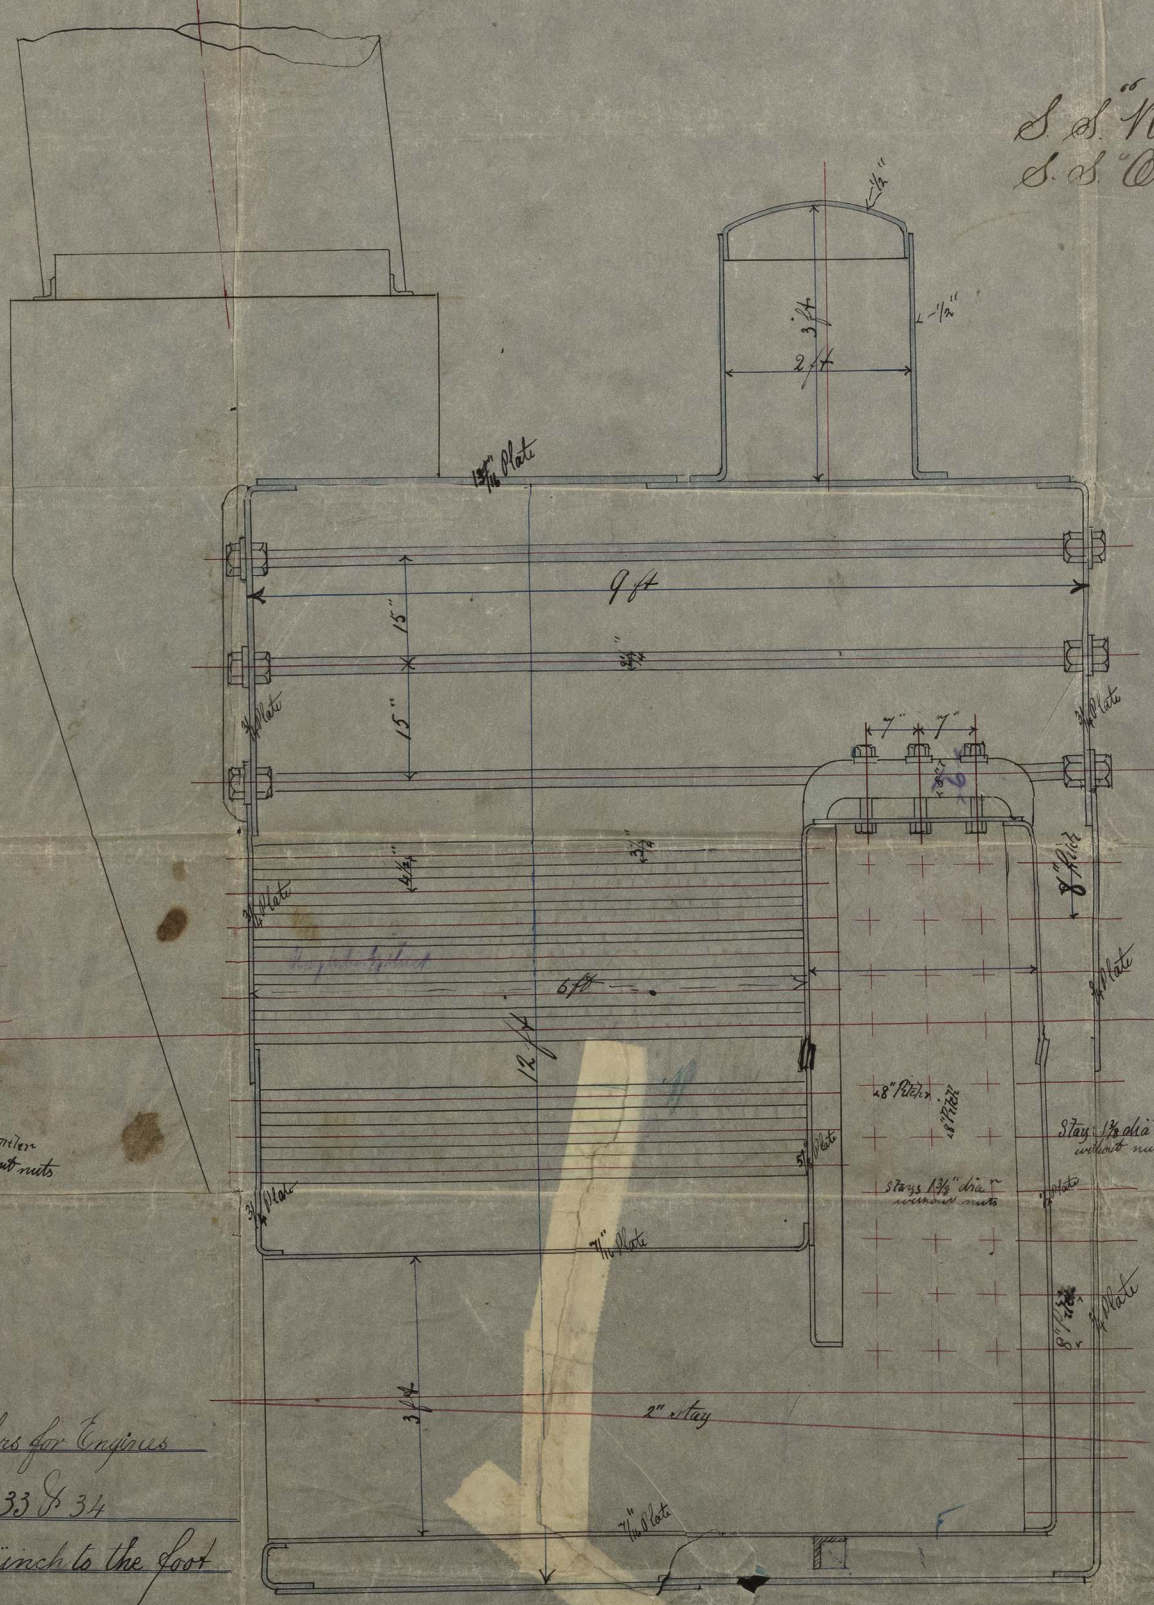

Plan of Rivetting.  
Scale 3 in one foot.

Working Pressure 80 lbs



© 2021  
Lloyd's Register  
Foundation