


COPY DRAWING.
No 851

DIMENSIONS REGISTER 210' x 29' x 15.75'

Lloyds $208.2 \times 28.83 \times 17.42$

S.S. "Elbe" Glasgow Report No 6054.

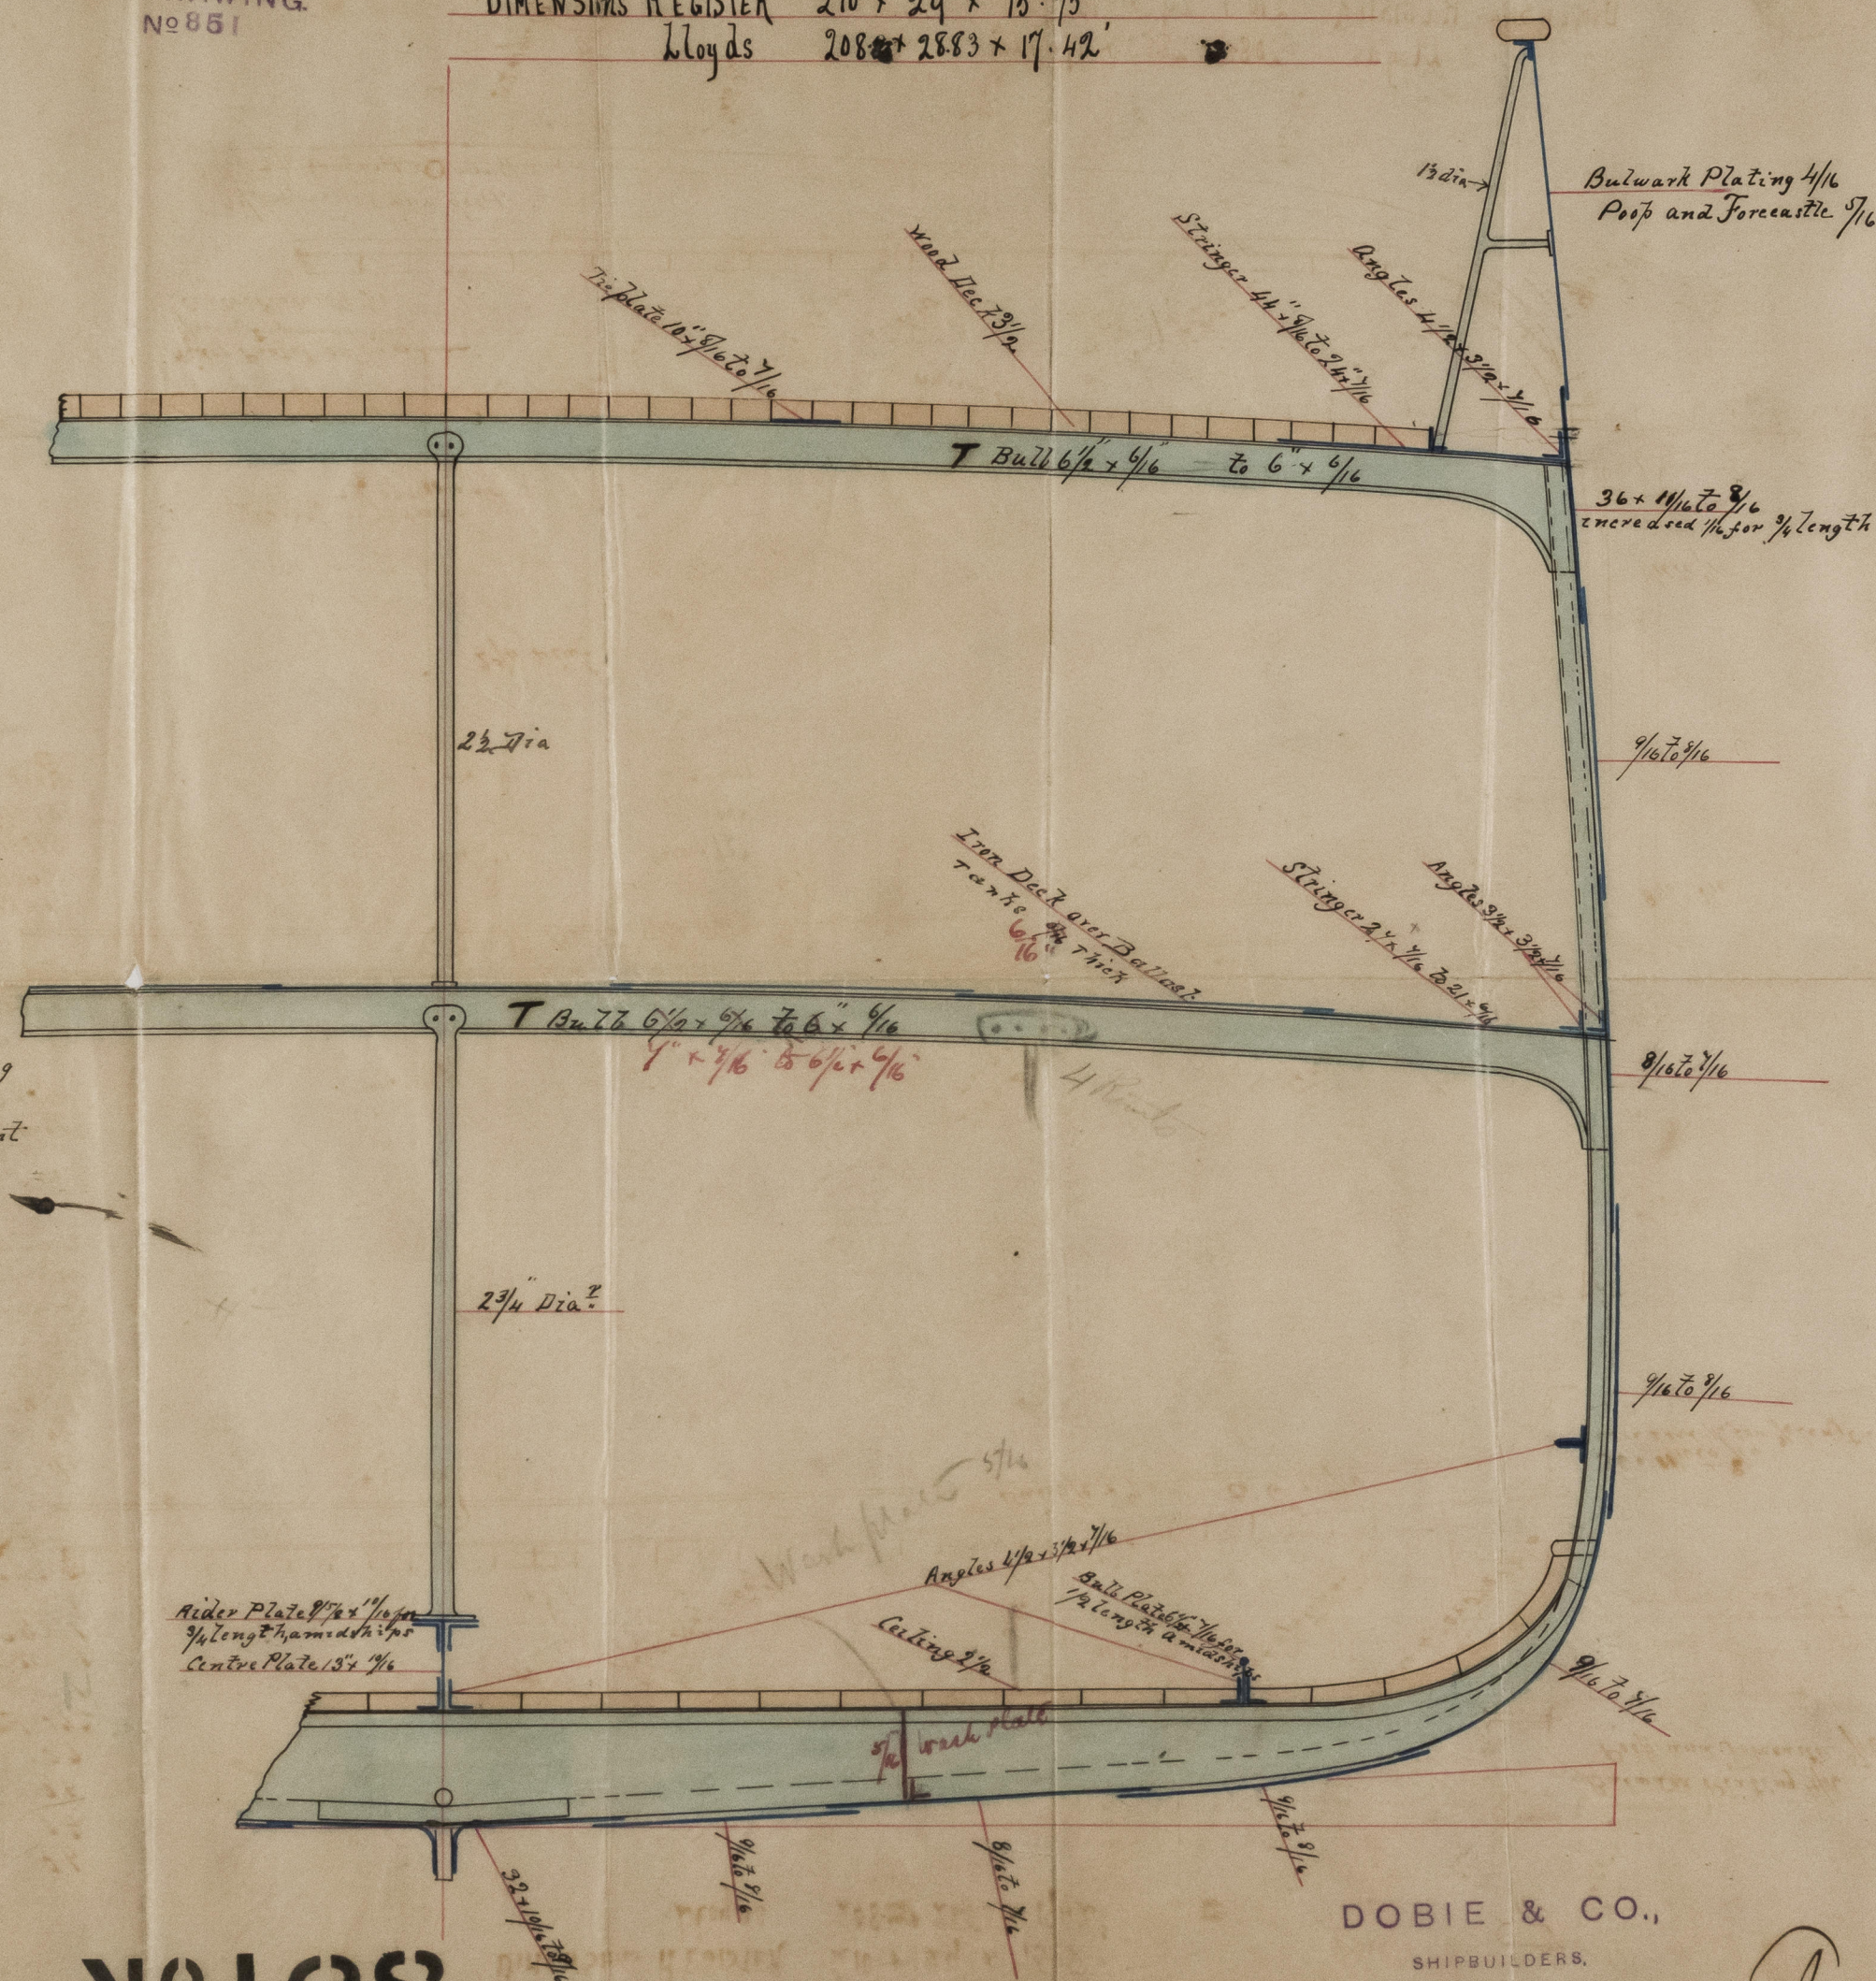

Scantlings.

KEEL $8" \times 2\frac{3}{4}$
 STEAM $7" \times 2\frac{3}{4}$ To $5\frac{1}{4} \times 2\frac{3}{4}$
 STERN POST $7 \times 4\frac{3}{4}$
 RUDDER 5" dia at head to 3" at heel & Pinholes
 FRAMES $3\frac{1}{4} \times 3 \times \frac{1}{16}$ in spaced 22 apart
 " (REVERSE) $3 \times 2\frac{1}{2} \times \frac{1}{16}$ in upper & lower Decks Alternately
 FLOORS $1\frac{1}{2} \times 3 \times \frac{1}{16}$ to $1\frac{1}{2} \times \frac{1}{16}$ in machinery space
 BULKHEAD PLATING $\frac{3}{16}$
 " Angles $3 \times 2\frac{1}{2} \times \frac{1}{4}$
 POOP BEAMS $5 \times 3 \times \frac{1}{4}$
 FORECASTLE BEAMS $5\frac{1}{2} \times \frac{1}{4}$ Bulk Angles 23-23- $\frac{3}{4}$
 " Stringer $23 \times \frac{1}{4}$
 POOP Stringer $24 \times \frac{1}{4}$
 BRIDGE BEAMS $5 \times 3 \times \frac{1}{4}$ Stringer $24 \times \frac{1}{4}$
 Bull Straps of the Main Deck Stringer Plate
 Sheer Straps & two Straps of Plating Round
 the Bilges to be $\frac{1}{4}$ in thicker than the plates
 they connect & double rivetted for $\frac{1}{2}$
 length amidships
 $\frac{1}{8}$ Rivets in Garboard & Sheer Straps
 $\frac{3}{4}$ " " Remainder of Sheer
 $\frac{1}{4}$ " " Keel Stem & Stern post &

EQUIPMENT

2	Bowyer Anchors	18 cut Ex Stock
1	" "	15 1/4 - " "
1	Stream "	6 1/2 " "
1	Kedge "	3 1/4 - " "
1	" "	1 1/2 - " "
240	Fathoms	1 3/4 Chain Cable
60	"	1 5/8 Stream Chain
90	"	3" Steel wire
90	"	7 1/2 Hawser
90	"	5 1/2 Warp

No 128

SCALE $\frac{1}{2}$ INCH = 1 FT

DOBIE & CO.,

SHIPBUILDERS.

GOVAN.

GLASGOW.

9/6/82
J. M. L.

Lloyd's Register
Foundation