


COPY DRAWING
No 854

LONGITUDINAL SECTION OF IRON STEAMER WITH POOP, FORECASTLE AND BRIDGE HOUSES

S.S. "Elbe" Glasgow Report No 6054.

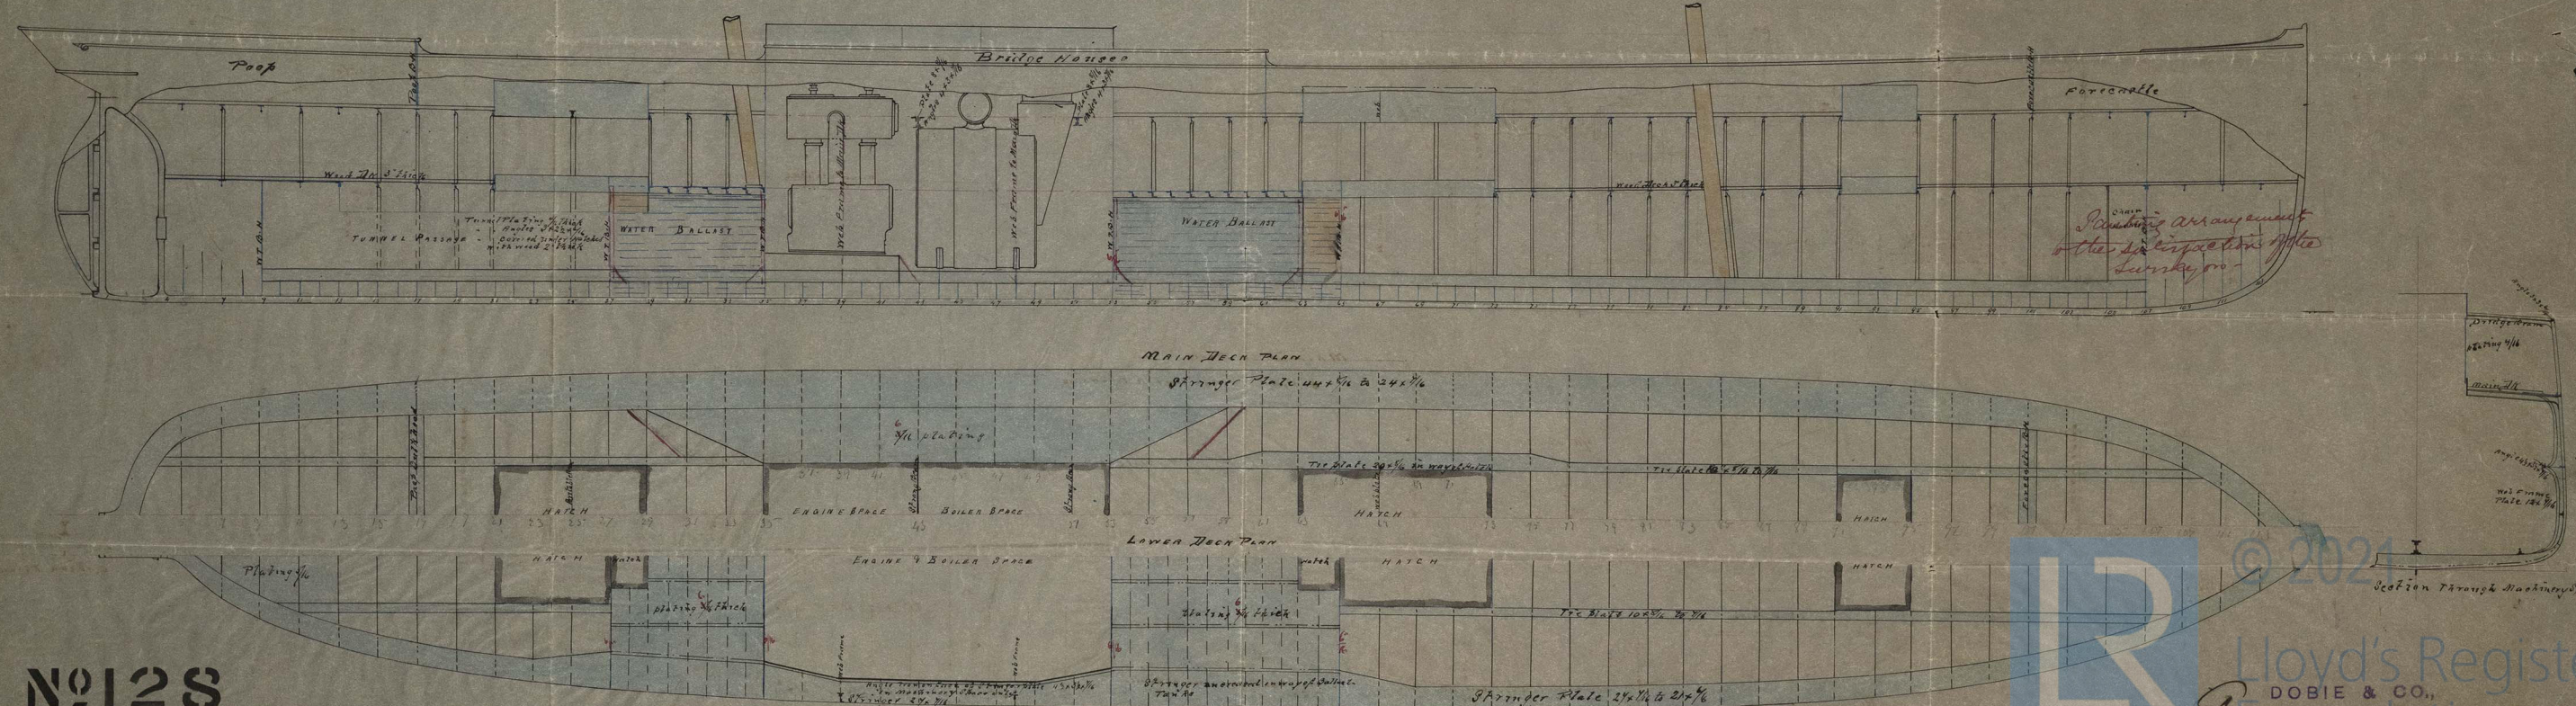

No 128

SCALE 1/8" INCH = 1 FT



Lloyd's Register
DOBIE & CO.,
SHIPBUILDERS,
GLASGOW.

19/6/82


GLASGOW.

GLS 173-0074

GLS 193-0099


COPY DRAWING
No 884

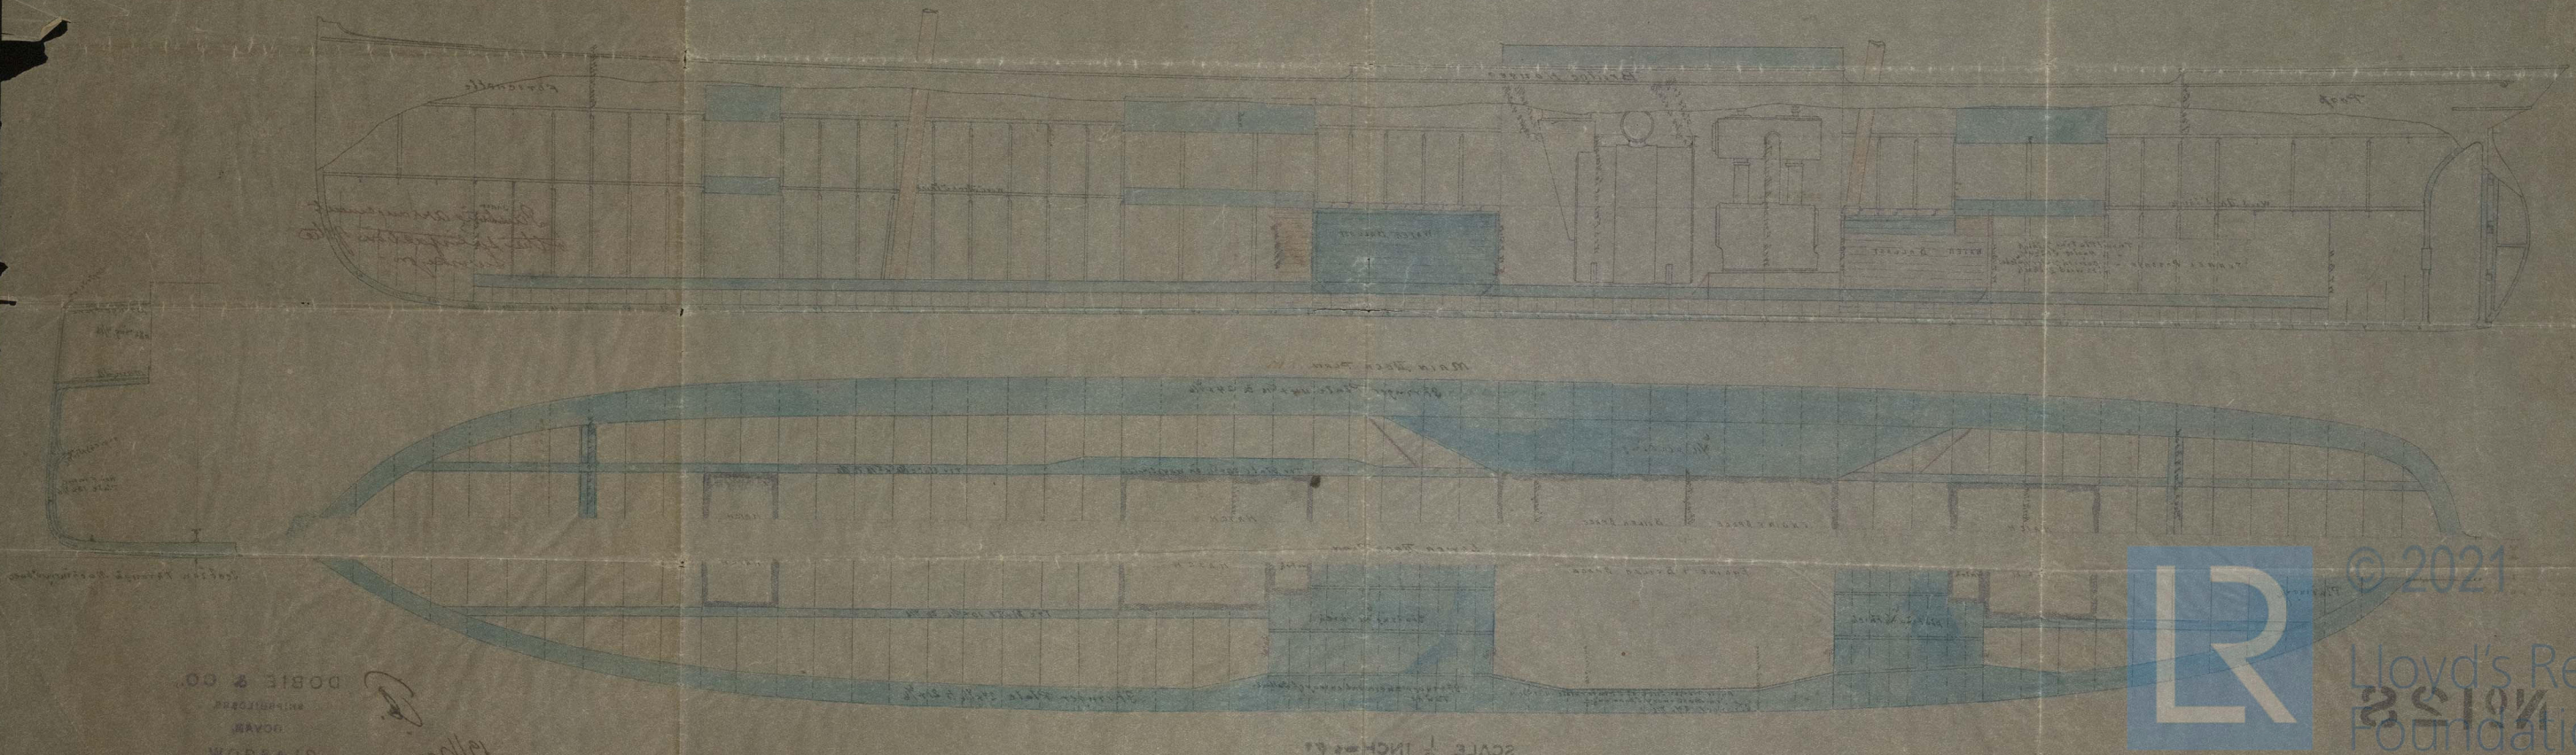

SCALE 1/8" = 1'

DOBIE & CO.
GLASGOW



© 2021
Lloyd's Register
Foundation