


RECEIVED 17th JAN. 88

COPY DRAWING
NO 128

M. 17/1/88

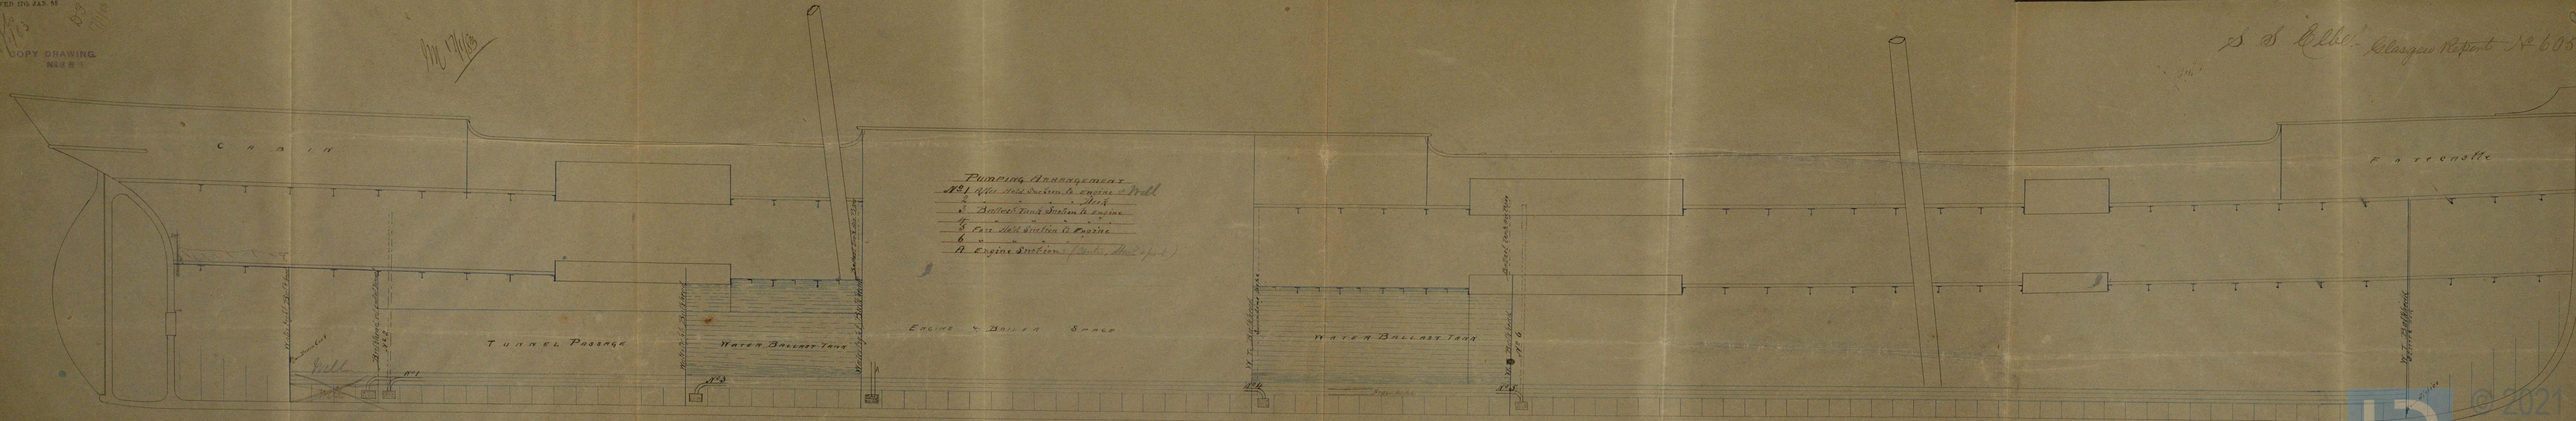


NO 128

SCALE $\frac{1}{4}$ INCH = 1 FT

© 2021
Lloyd's Register
Foundation