

8.6.82

S. S. "Hona" Glasgow Report No. 6083.

Arrangement in line of
Web frames in boiler shell.
(below Lower deck)

J & G. Thomson.
No. 192. (Stat).

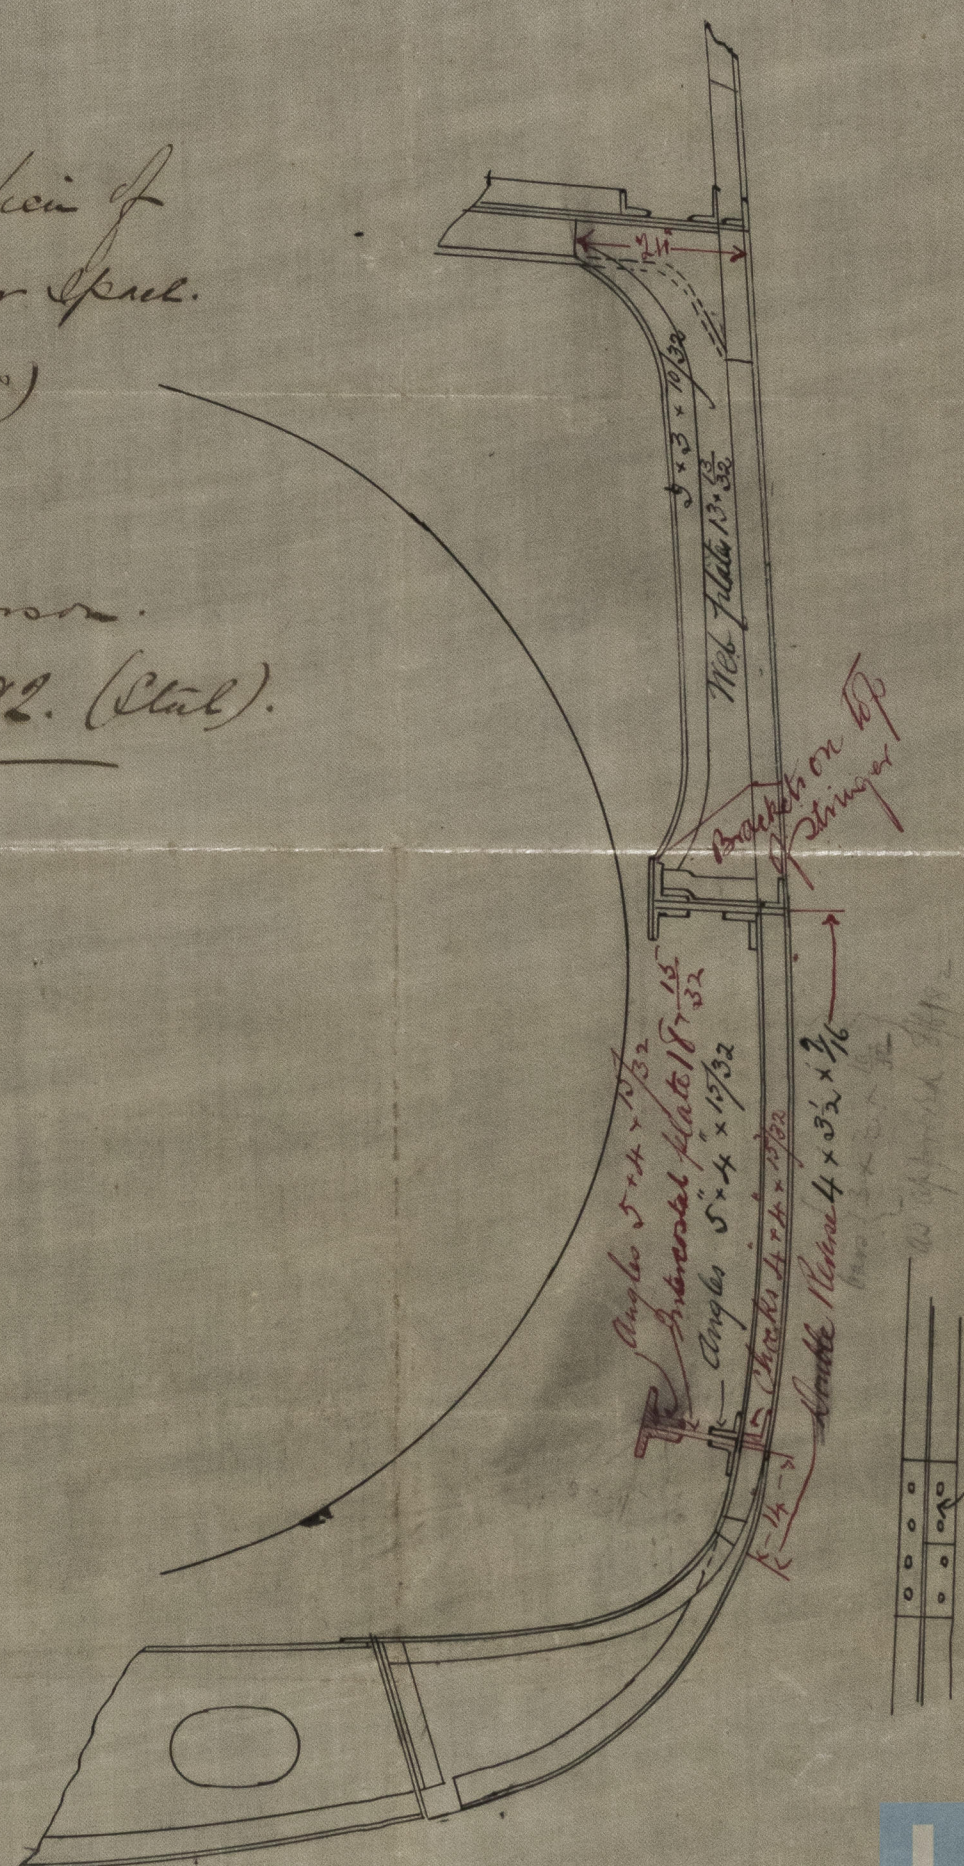


Plate on face
of Ribbed frame



V-8 M
116712

Lloyd's Register
Foundation

GLS193-0113