


S.S. "Iona"
Glasgow Report
No. 6083.

Lower deck frame = 2737
for which compensation = 4350
and therefore for 1/2 = 5700 = 1000
1000
1000

In Machine (170) compensation for reduction of L.D. Straps from 32-7/16 to 13-10/16
in two sets frames 13 x 7/16
We propose in compensation for reduction of L.D. Straps from 32-7/16 to 13-10/16
in two sets frames 13 x 7/16
Slips to the extent of 3 inches in the side
We propose this sketch
My approval of it



S.S. No. 192.

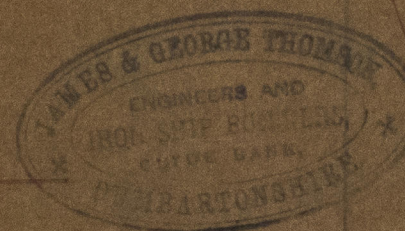

23/5/82

