


RECEIVED 15 MAY 1882

110-21233

S.S. "Sona"
Glasgow Report
No 6083.


Lower deck Plan

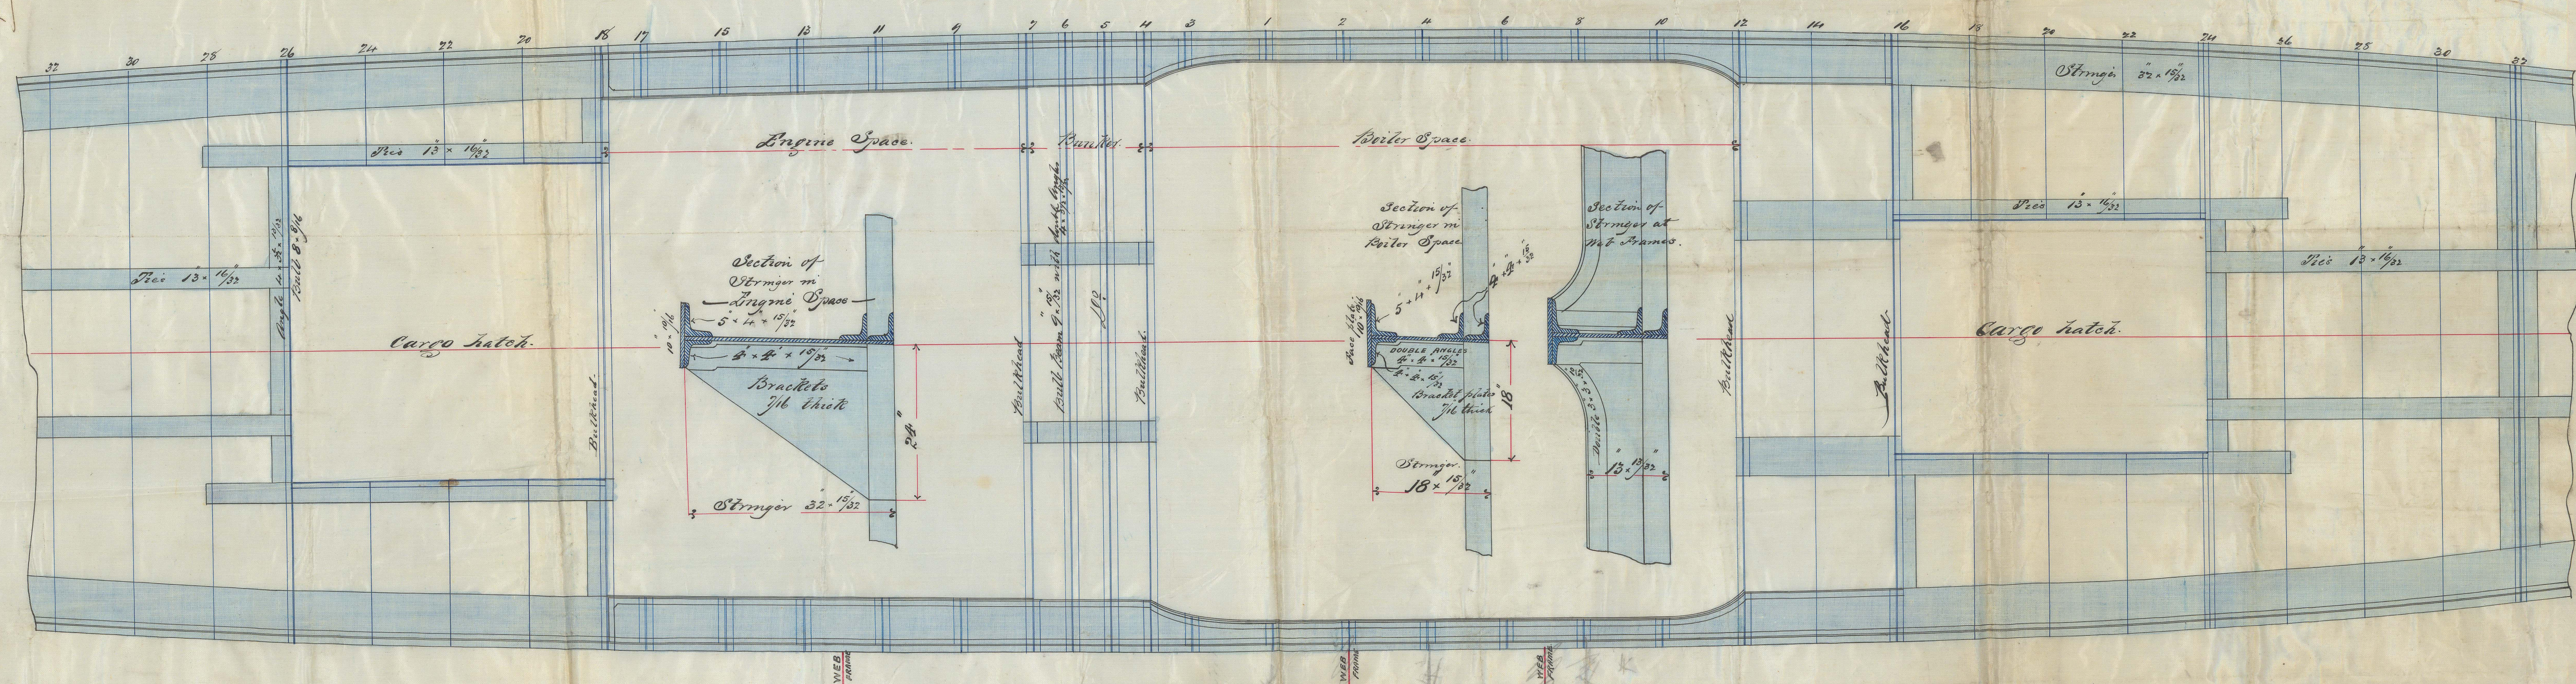

TRACING SHEWING POSITION OF WEB FRAMES AND PROPOSED STRENGTHENING
IN THE ENGINE & BOILER SPACES"

Main deck Plan

S.S. No 192 Scale 1/2 inch = one foot

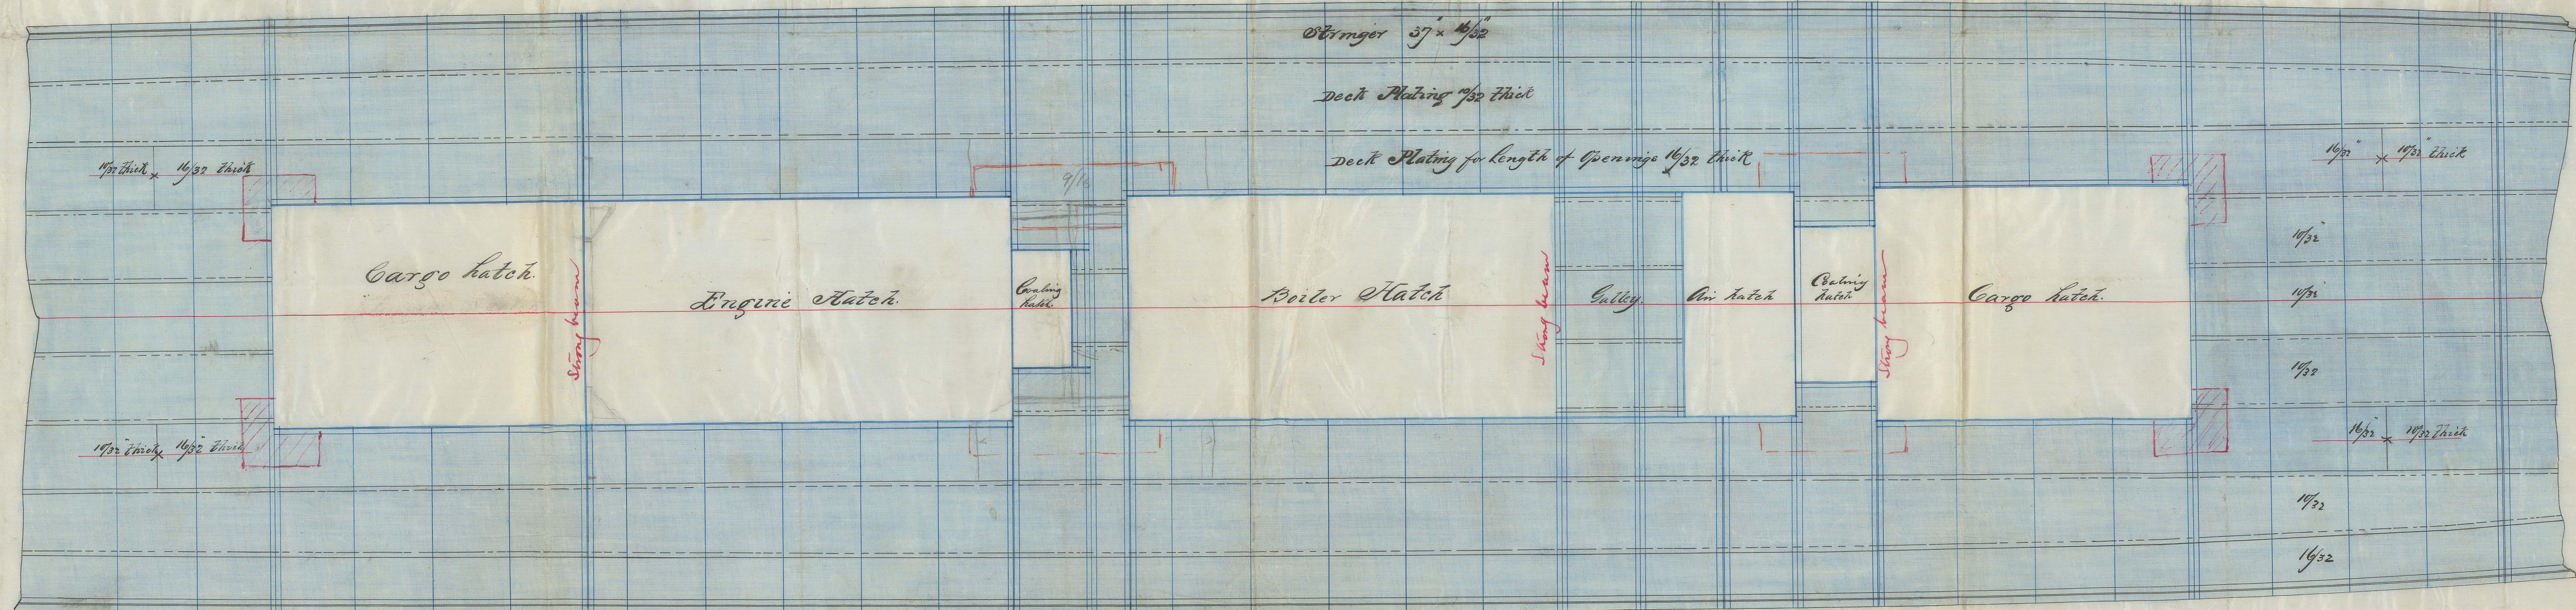

JAMES & GEORGE THOMSON
ENGINEERS AND
IRON SHIP BUILDERS
GLIDE BANK,
GLASGOW.

11/5/82

11/5/82