


Ship "Imberhorne" Glasgow Report N<sup>o</sup> 5960  
Ship "Falconhurst" — do — 6134.


Lt. Glasgow  
21/8/82.

Plan of Bridge for Ships Nos 245-6  
scale  $\frac{1}{4}$  = one foot

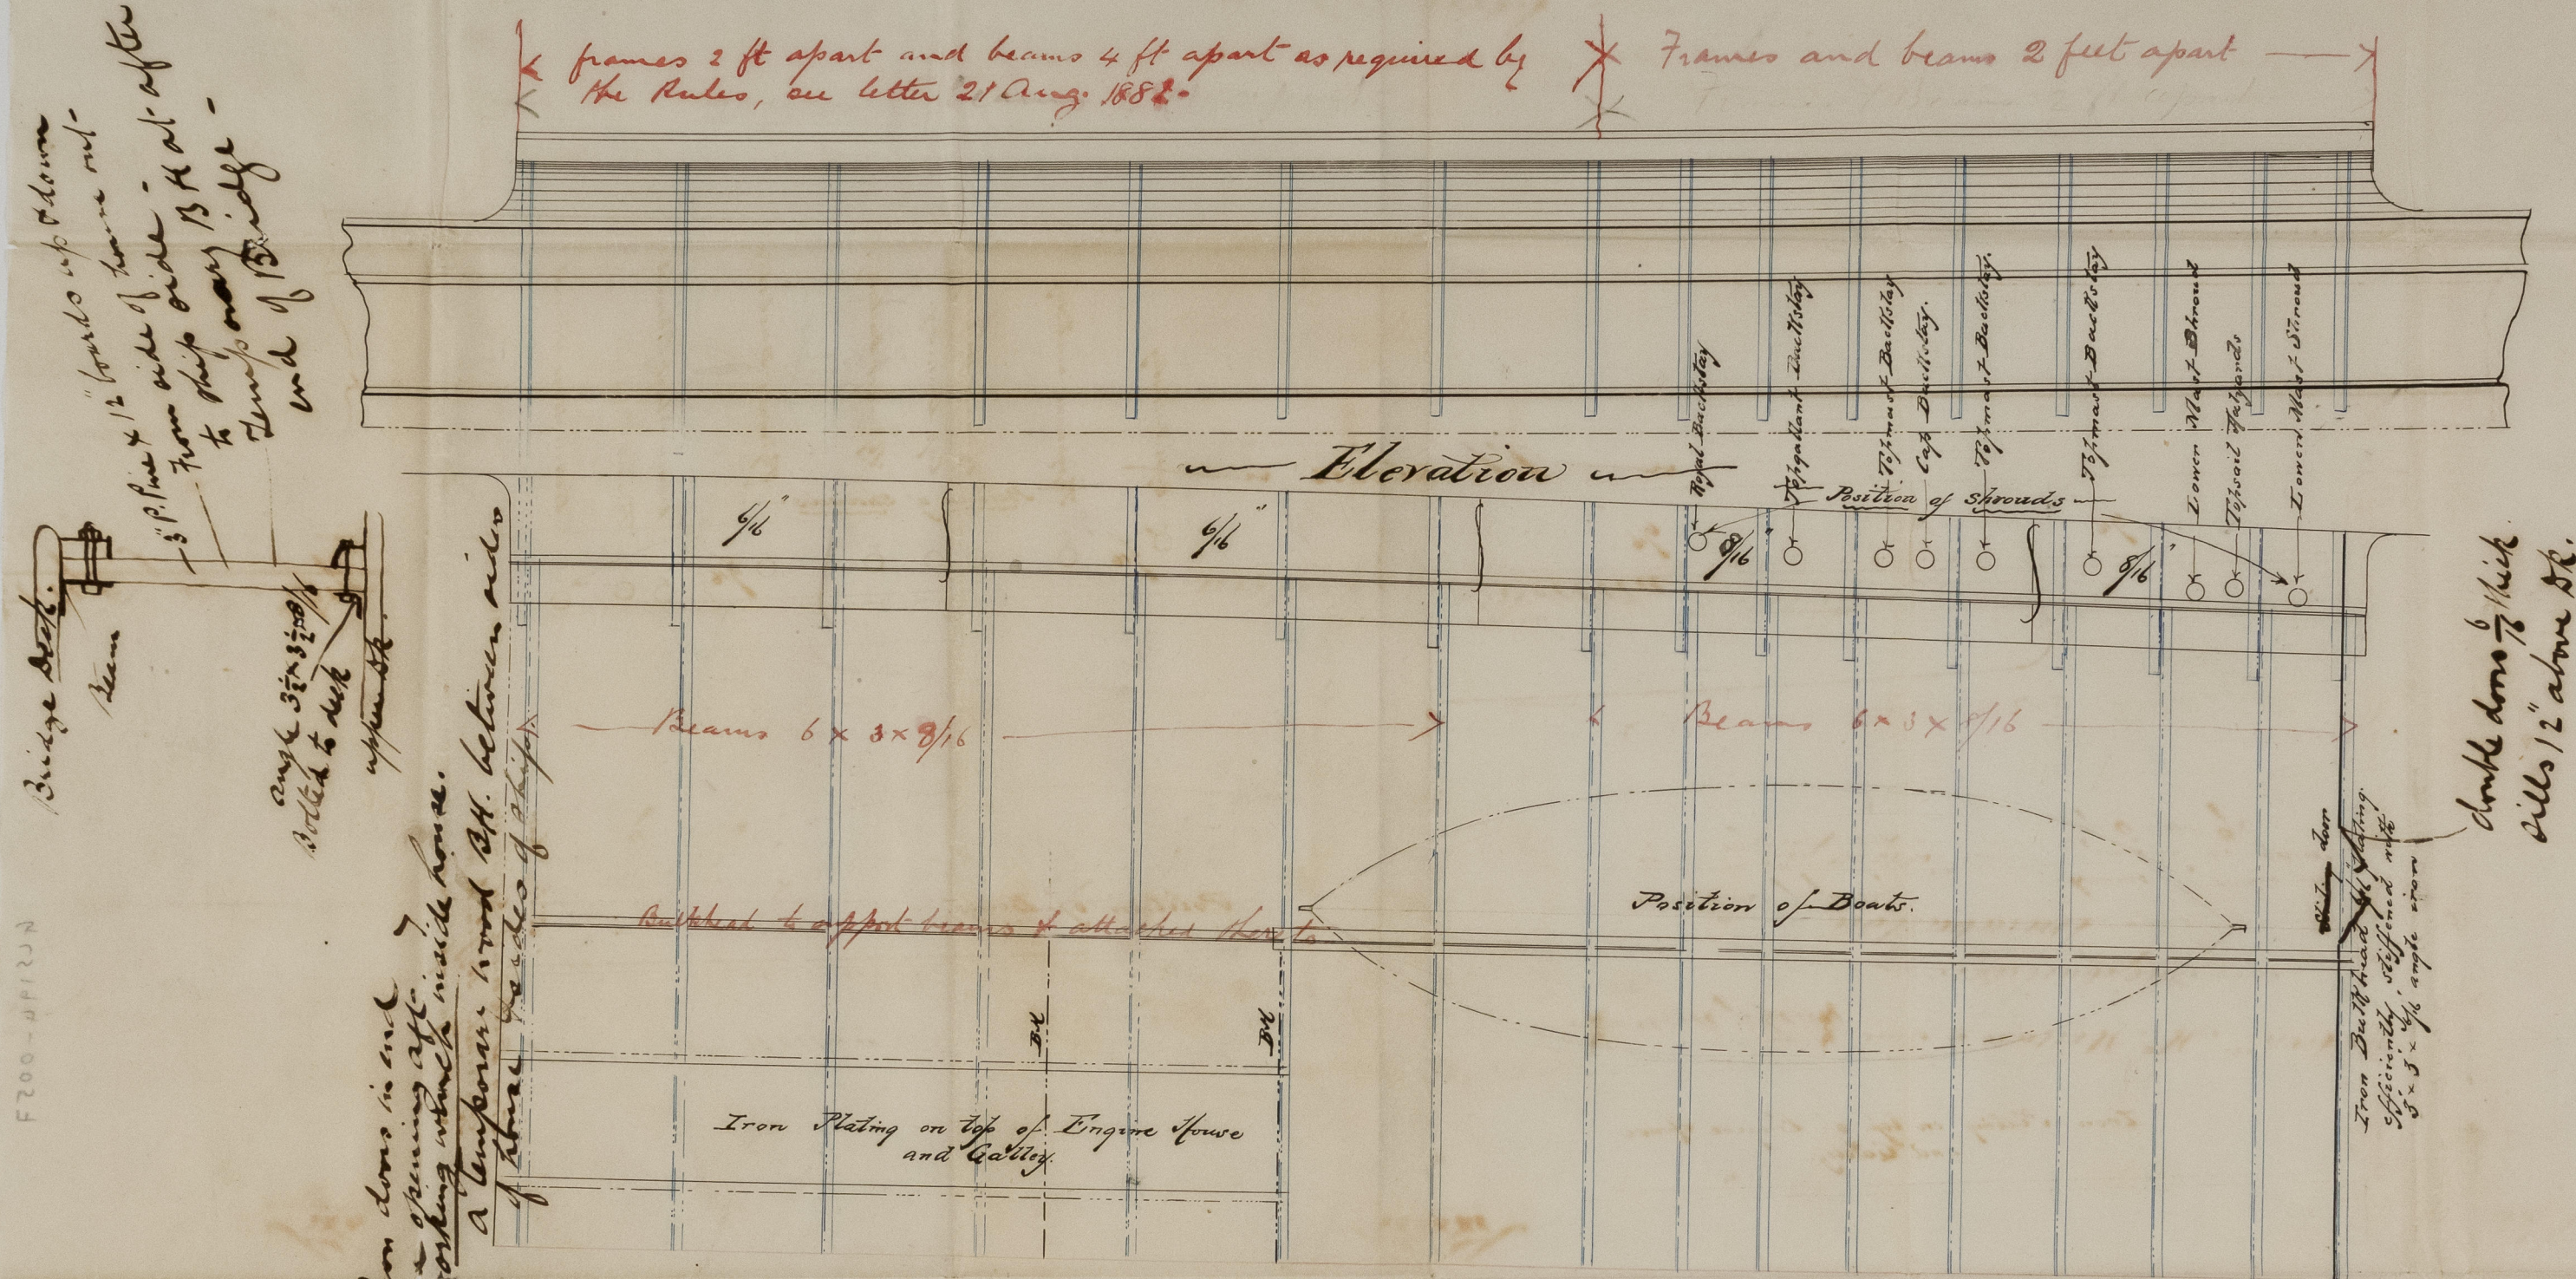

Plan

Arch<sup>d</sup> M<sup>e</sup> Millan & Son  
Shipbuilders  
Dumbarton  
18<sup>th</sup> August 1882

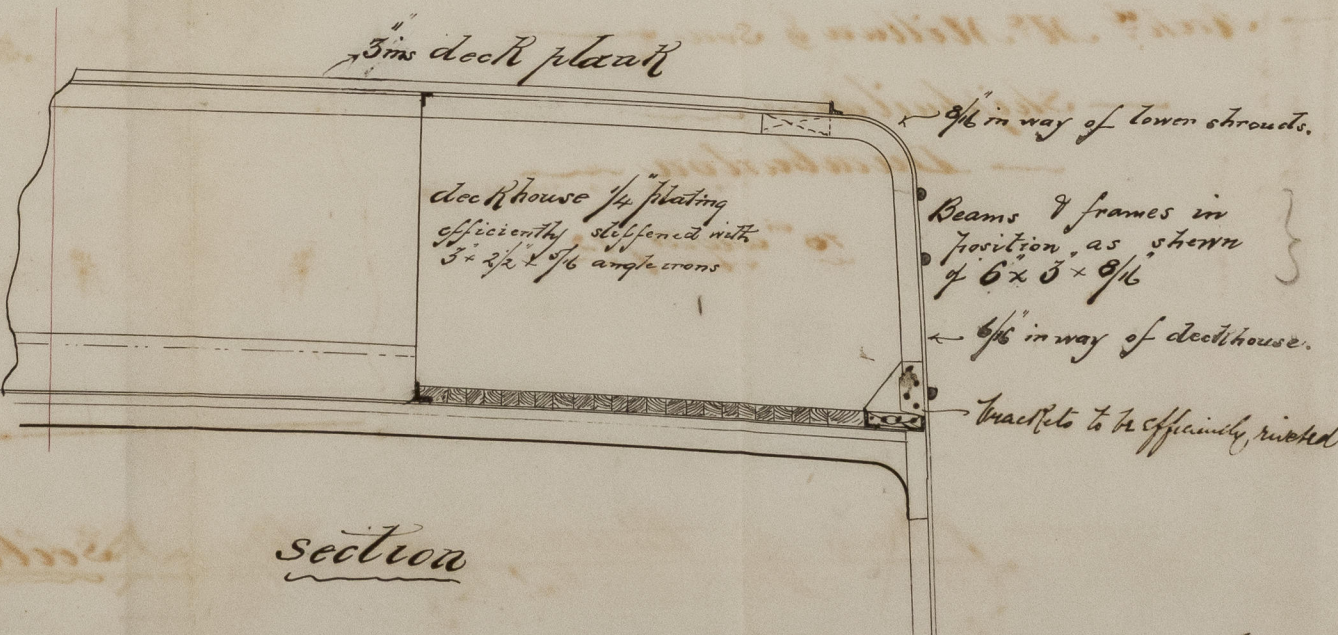

section

see letter to Surveyor