


Sketch showing proposed arrangement of Reelers
 & scuttlings of same Ship No. 246
 Ld. Glasgow.
 3/10/82.

A McMillan & Son
 Dockyard
 Dumbarton.
 2/10/82

Ship "Falconhurst"
 Glasgow Report
 No. 6134.

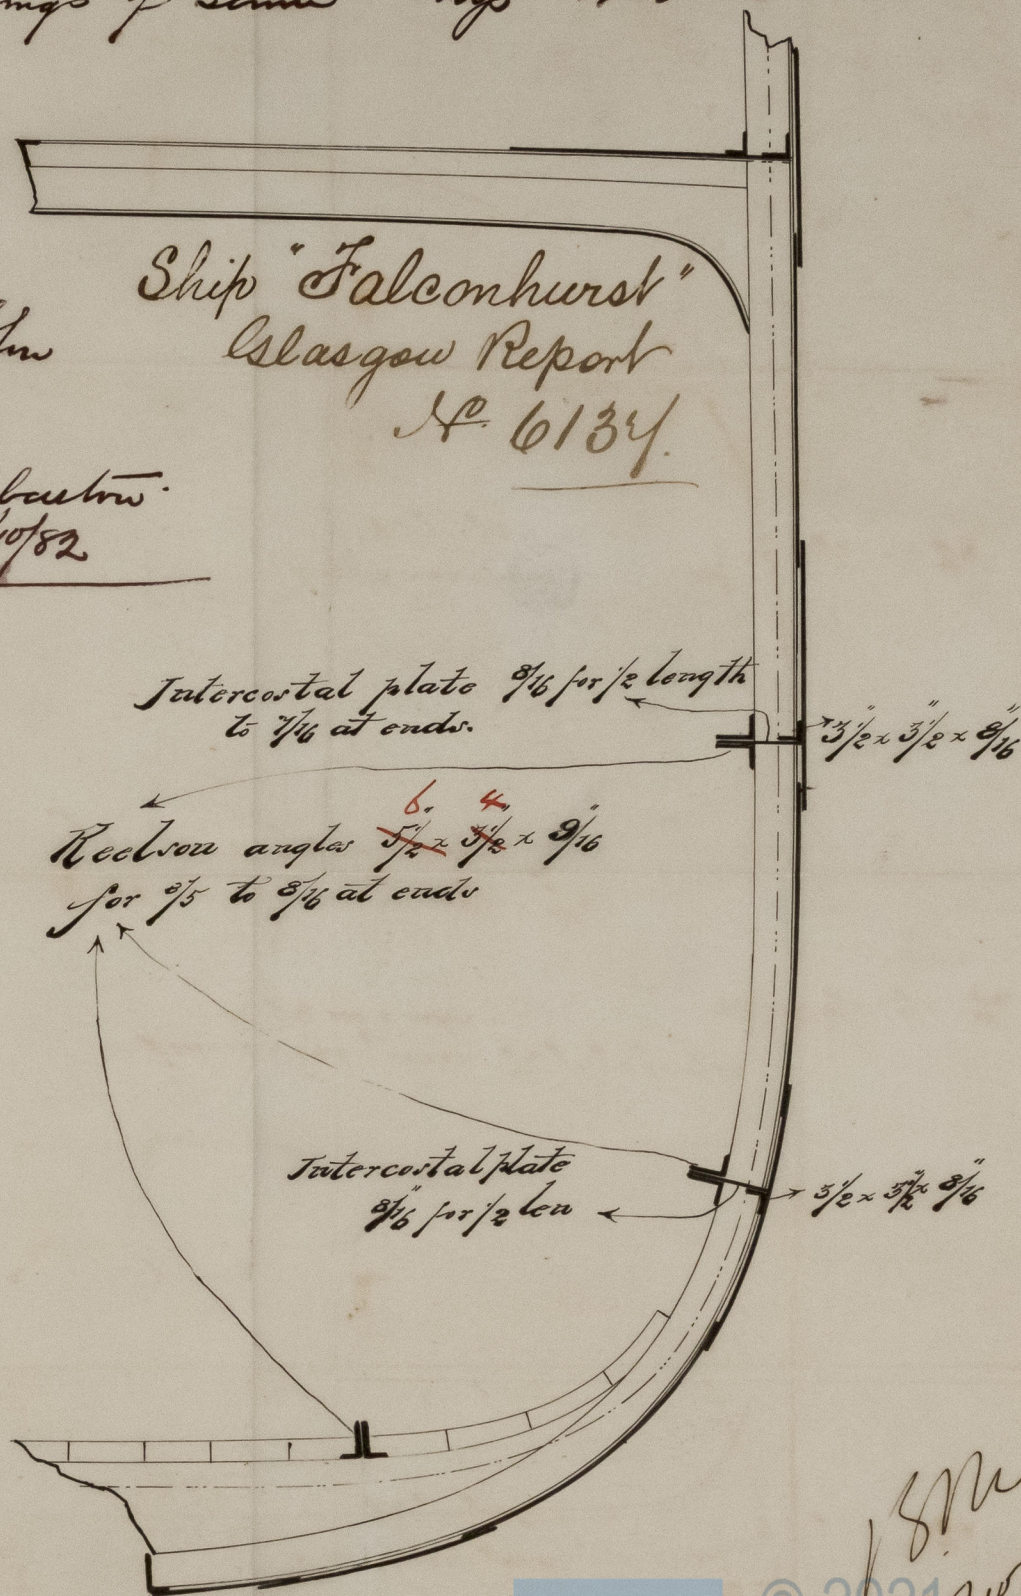

P200-40123N



© 2023/10/82

Lloyd's Register
 Foundation

GLS194-0059