

22 5-82

1/2 Length

Stringer Plates 4 1/2" x 1/8" for 1/2 Length to 3 1/2" x 1/8" at ends

Diagonal Joints 15" x 9 1/16"

Joints 15" x 9 1/16"

Two plates 15" x 1/8" for 1/2 Length to 1/8" at ends

3 1/2" x 1/8"

Match

Match

Capstan Plate 7 1/2"


Match

Match

22/5/82



Ship "Imberhorne" - Glasgow Report No. 5960  
 Ship "Falconhurst" - do - 6134

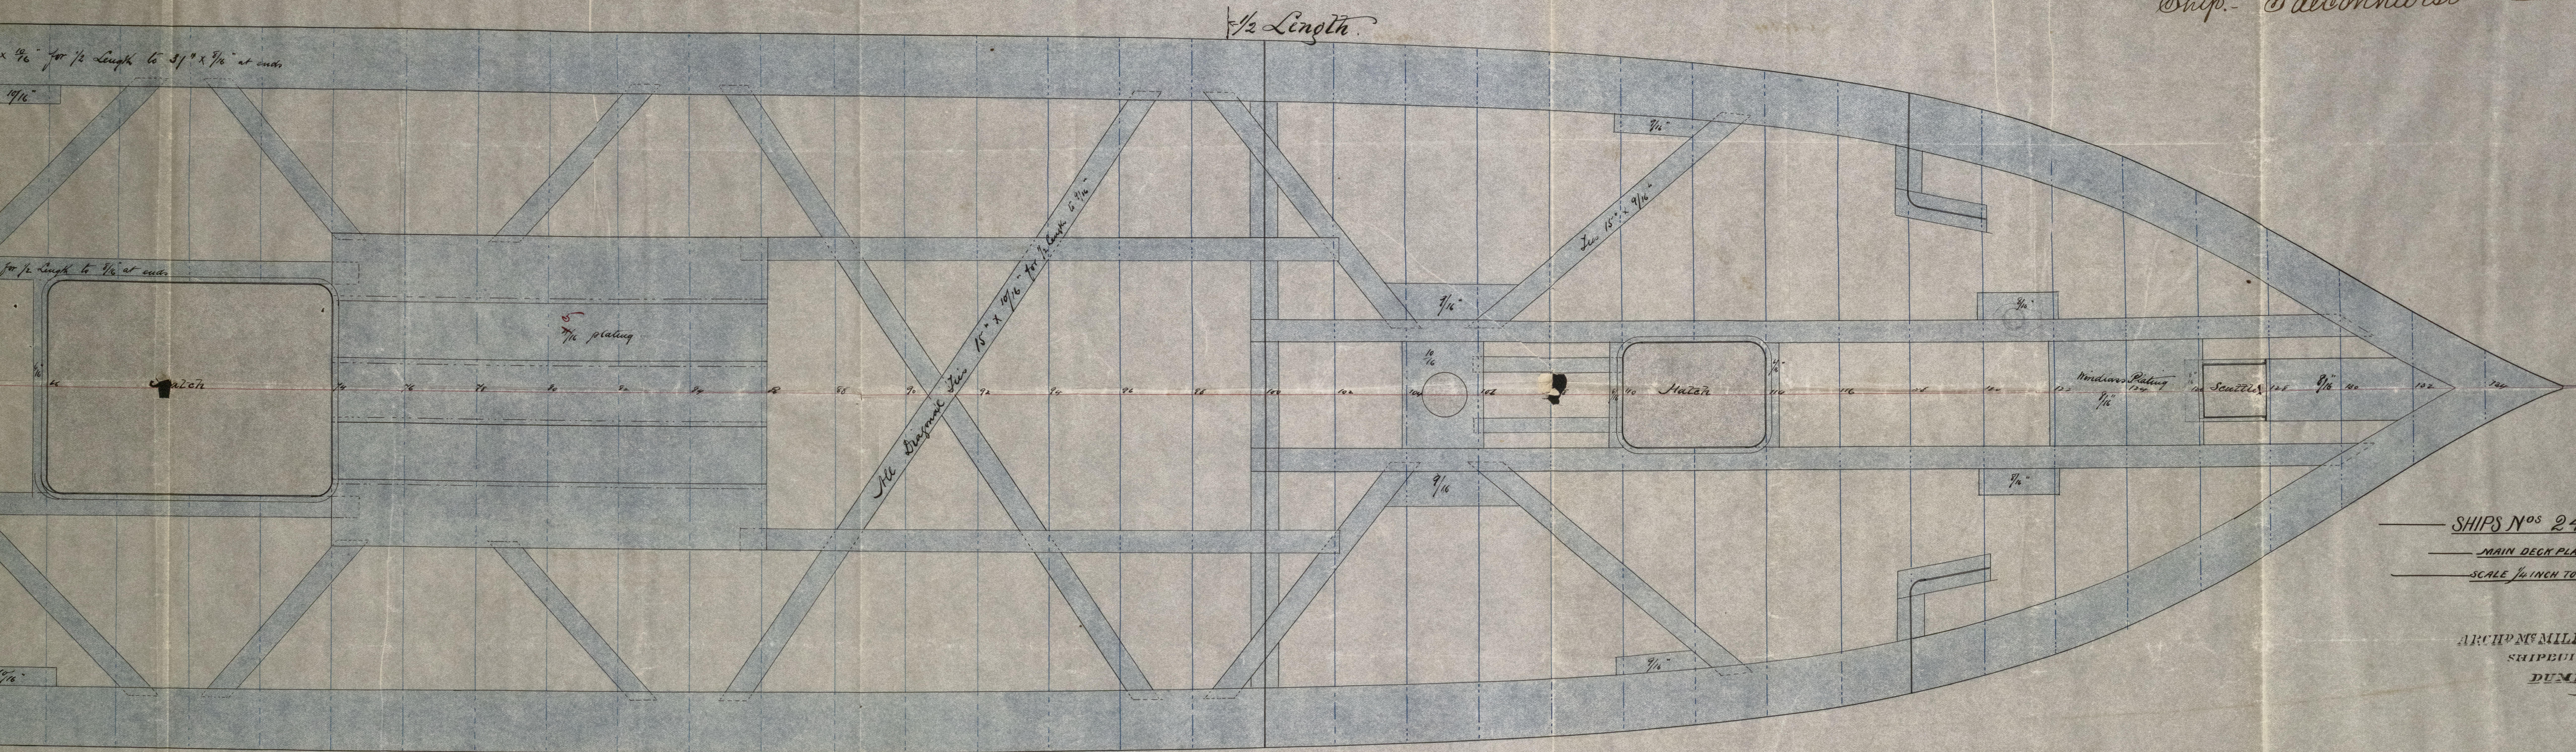

SHIPS NOS 245-6  
 MAIN DECK PLAN  
 SCALE 1/4 INCH TO THE FOOT

ARCHD. MILLAN & SON  
 SHIPBUILDERS  
 DUMBAULTON  
 19th May 1882