

Lloyd's Register of British and Foreign Shipping.

Received in the London Office, RECEIVED 27th JAN. 83

P.

No. 145

REPORT ON SHIP FORGINGS.

Sir,

I beg leave to report that the undermentioned Forgings, manufactured by Messrs Hanna, Donald & Wilson of Paisley for the Vessel No. 87, being built by The Abercorn Shipbuilding Co of Paisley have been inspected by me in course of being forged and smithed, and found to be, so far as can be seen, sound and satisfactory

Mark on Forging.

Lloyd's

No. 145

G. N

The Secretary,
London.


I am, Sir,

Your Obedient Servant,

George Newcomb
Glasgow

	STERN FRAMES.	RUDDER FRAMES.	STEMS. & Keel bars
Material*	Scrap iron	Scrap. iron	Rollled iron
How made	Forged	Forged	Rollled
Dimensions	5 x 13/4	2 1/2 & 1 1/2	5 x 7/8
Progress on Inspection	Finished	Finished	Finished
Dates when Inspected	25/1/83	25/1/83	25/1/83

SKETCHES OF FRAMES SHEWING POSITION AND DESCRIPTION OF WELDS.

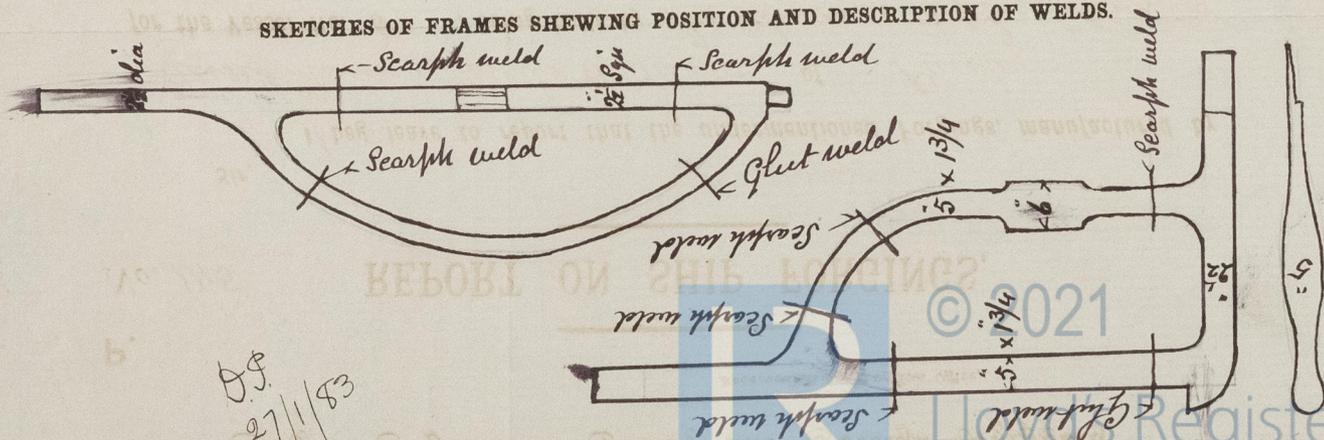

* If of iron, state whether scrap or puddled iron.