

RECEIVED 14 MAR. 82.  
RECEIVED 9th MAR. 83.

Ship "Gogoburn." Glasgow Report No. 5925.-  
Bk. "Hoddleburn" — do — 6143.-

24.12.81

12/3/82  
12/3/83

Monkey Forecastle Beams 6" x 3" x 5/16 Angles  
" " Stringer 20" x 7/16

No. 37 & 38.  
Midship Section  
Scale 1/2" = One Foot

Plan of Deck to be submitted  
diagonal tie plates  
to be submitted for  
approval.

Deck & Diagonal Ties 12" x 5/16 to 7/16

According to Main Deck Stringer below  
3 1/2 x 3 x 7/16  
Deck Beams 6" x 3" x 5/16 Angles

Angles 3" x 3" x 5/16  
Bulb 8" x 5/16 to 7" x 7/16  
Deck 5" x 3 1/2  
Stringer 30" x 7/16 ends 23" x 7/16  
36" x 7/16 to 2 1/2 forward

Half Moulded Port 34.33  
" Breadth 17.00  
Depth from top of keel 22.16  
Small No. 73.49 x 206.67 = 15188 Large No. 16200 Equip. No.  
Proportions 9.32 Depth & 6.07 Breadths

2 1/2  
Bulbhead Lower Half 1/4 Upper 1/4 Angles 3" x 3" x 5/16 Spaced 30" apart  
Smaller Head 3/4 Keel 3 Angles 3"  
Bulbheads of Main Deck Stringer. Sheerstrake &  
of 3 strake of Plating at edge to be 1/4 thicker  
than the plates they connect & double riveted for 1/4 length

Sheerstrake 12" x 5/16 to 7/16


Stringer 30" x 7/16 ends 24" x 7/16

Angles 3" x 3" x 5/16  
Bulb 8 1/2" x 5/16 ends 7 1/2" x 7/16

Outfit

2 Bower Anchors 30 cwt each Stock  
1 " " 25 1/2 " " "  
1 Stream " 9 1/2 " " "  
1 Kedge " 4 3/4 " " "  
1 " " 2 1/2 " " "  
336 270 fathoms 1 1/2 steel chain cable  
75 " 1 1/2 stream chain  
90 " 10 1/2 Towline  
90 " 9" Warp  
90 " 5 1/2 "

Pirrell, Steinhilber & Co  
SHIP BUILDERS  
DUNDEE

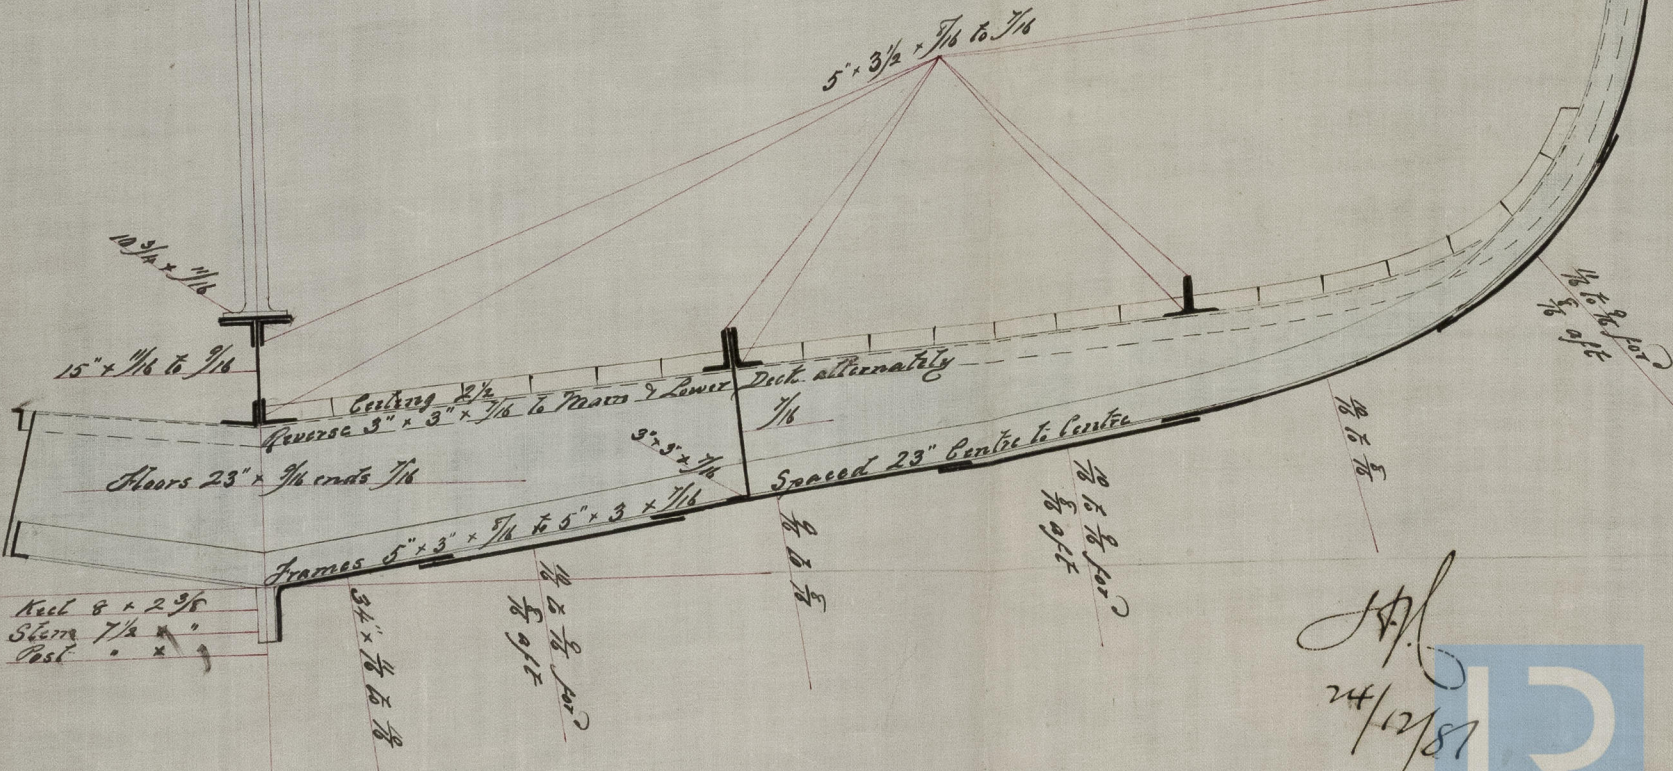

24/12/81



© 2021

Lloyd's Register  
Foundation

GLS194A - 0005