


2.10.82

S.S. Sargasso:
Glasgow Report No. 6159.

MASTS. (STEEL)
Nov 193.

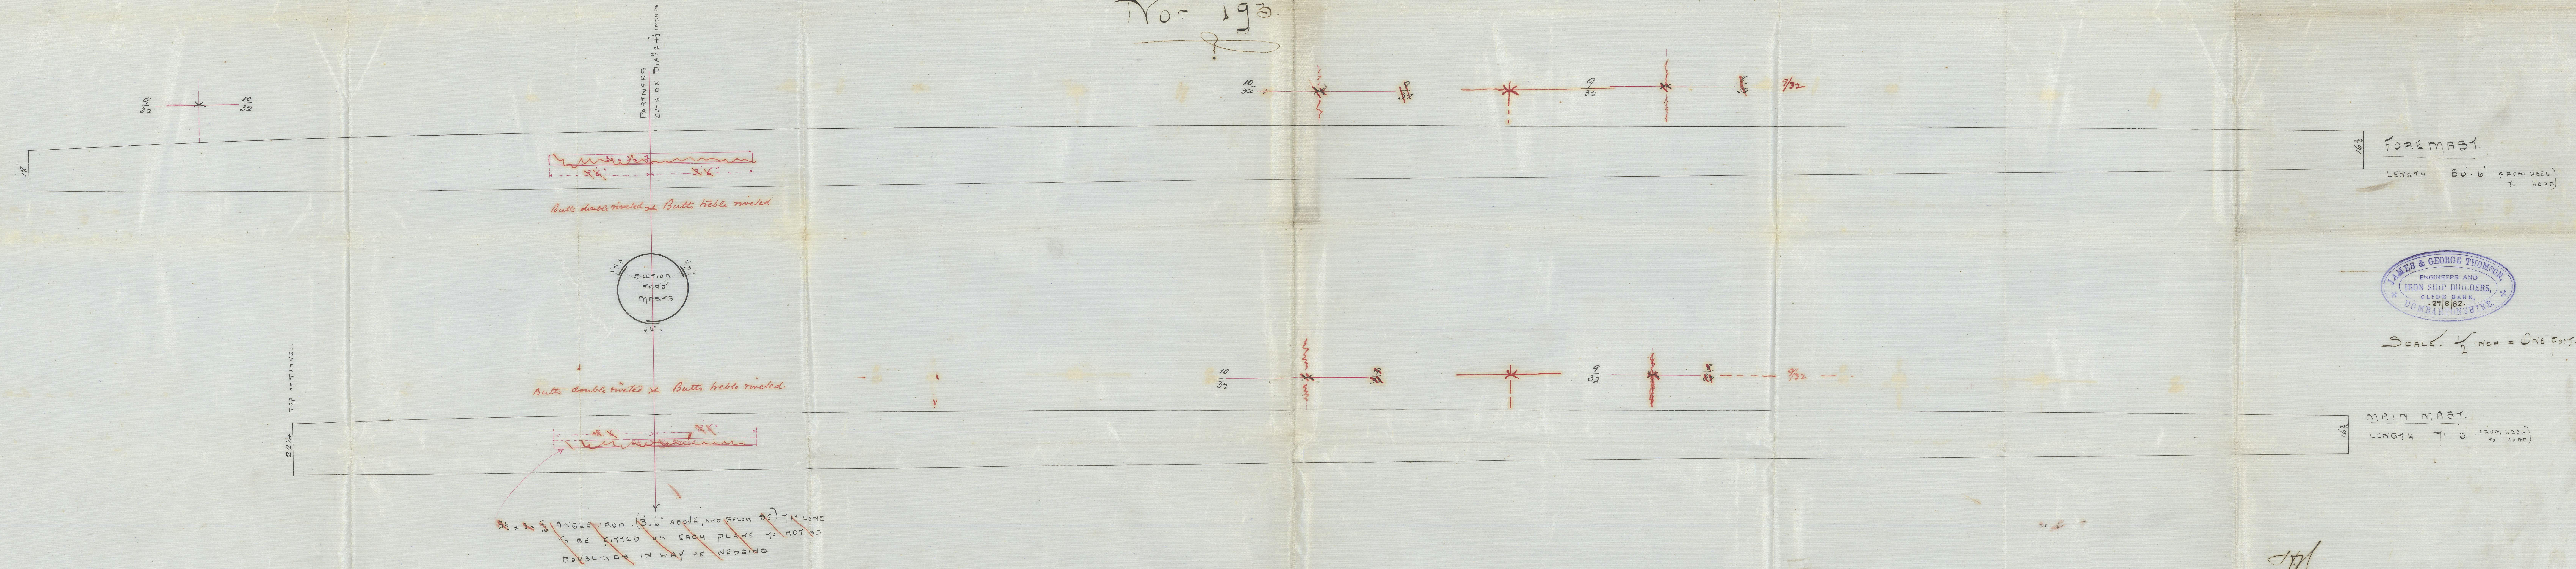

SCALE. 1/2" INCH = ONE FOOT.

17/11
30/9/82