

Lt: H. Pearson
19/8/82
H. Pearson
29/9/82

MIDSHIP SECTION


S.S. N^o 193

SCALE 1/2 INCH = ONE FOOT.

DIMENSIONS 275' x 33' x 20'6" moulded.

S.S. "Sargasso"

Glasgow Report N^o 6159.

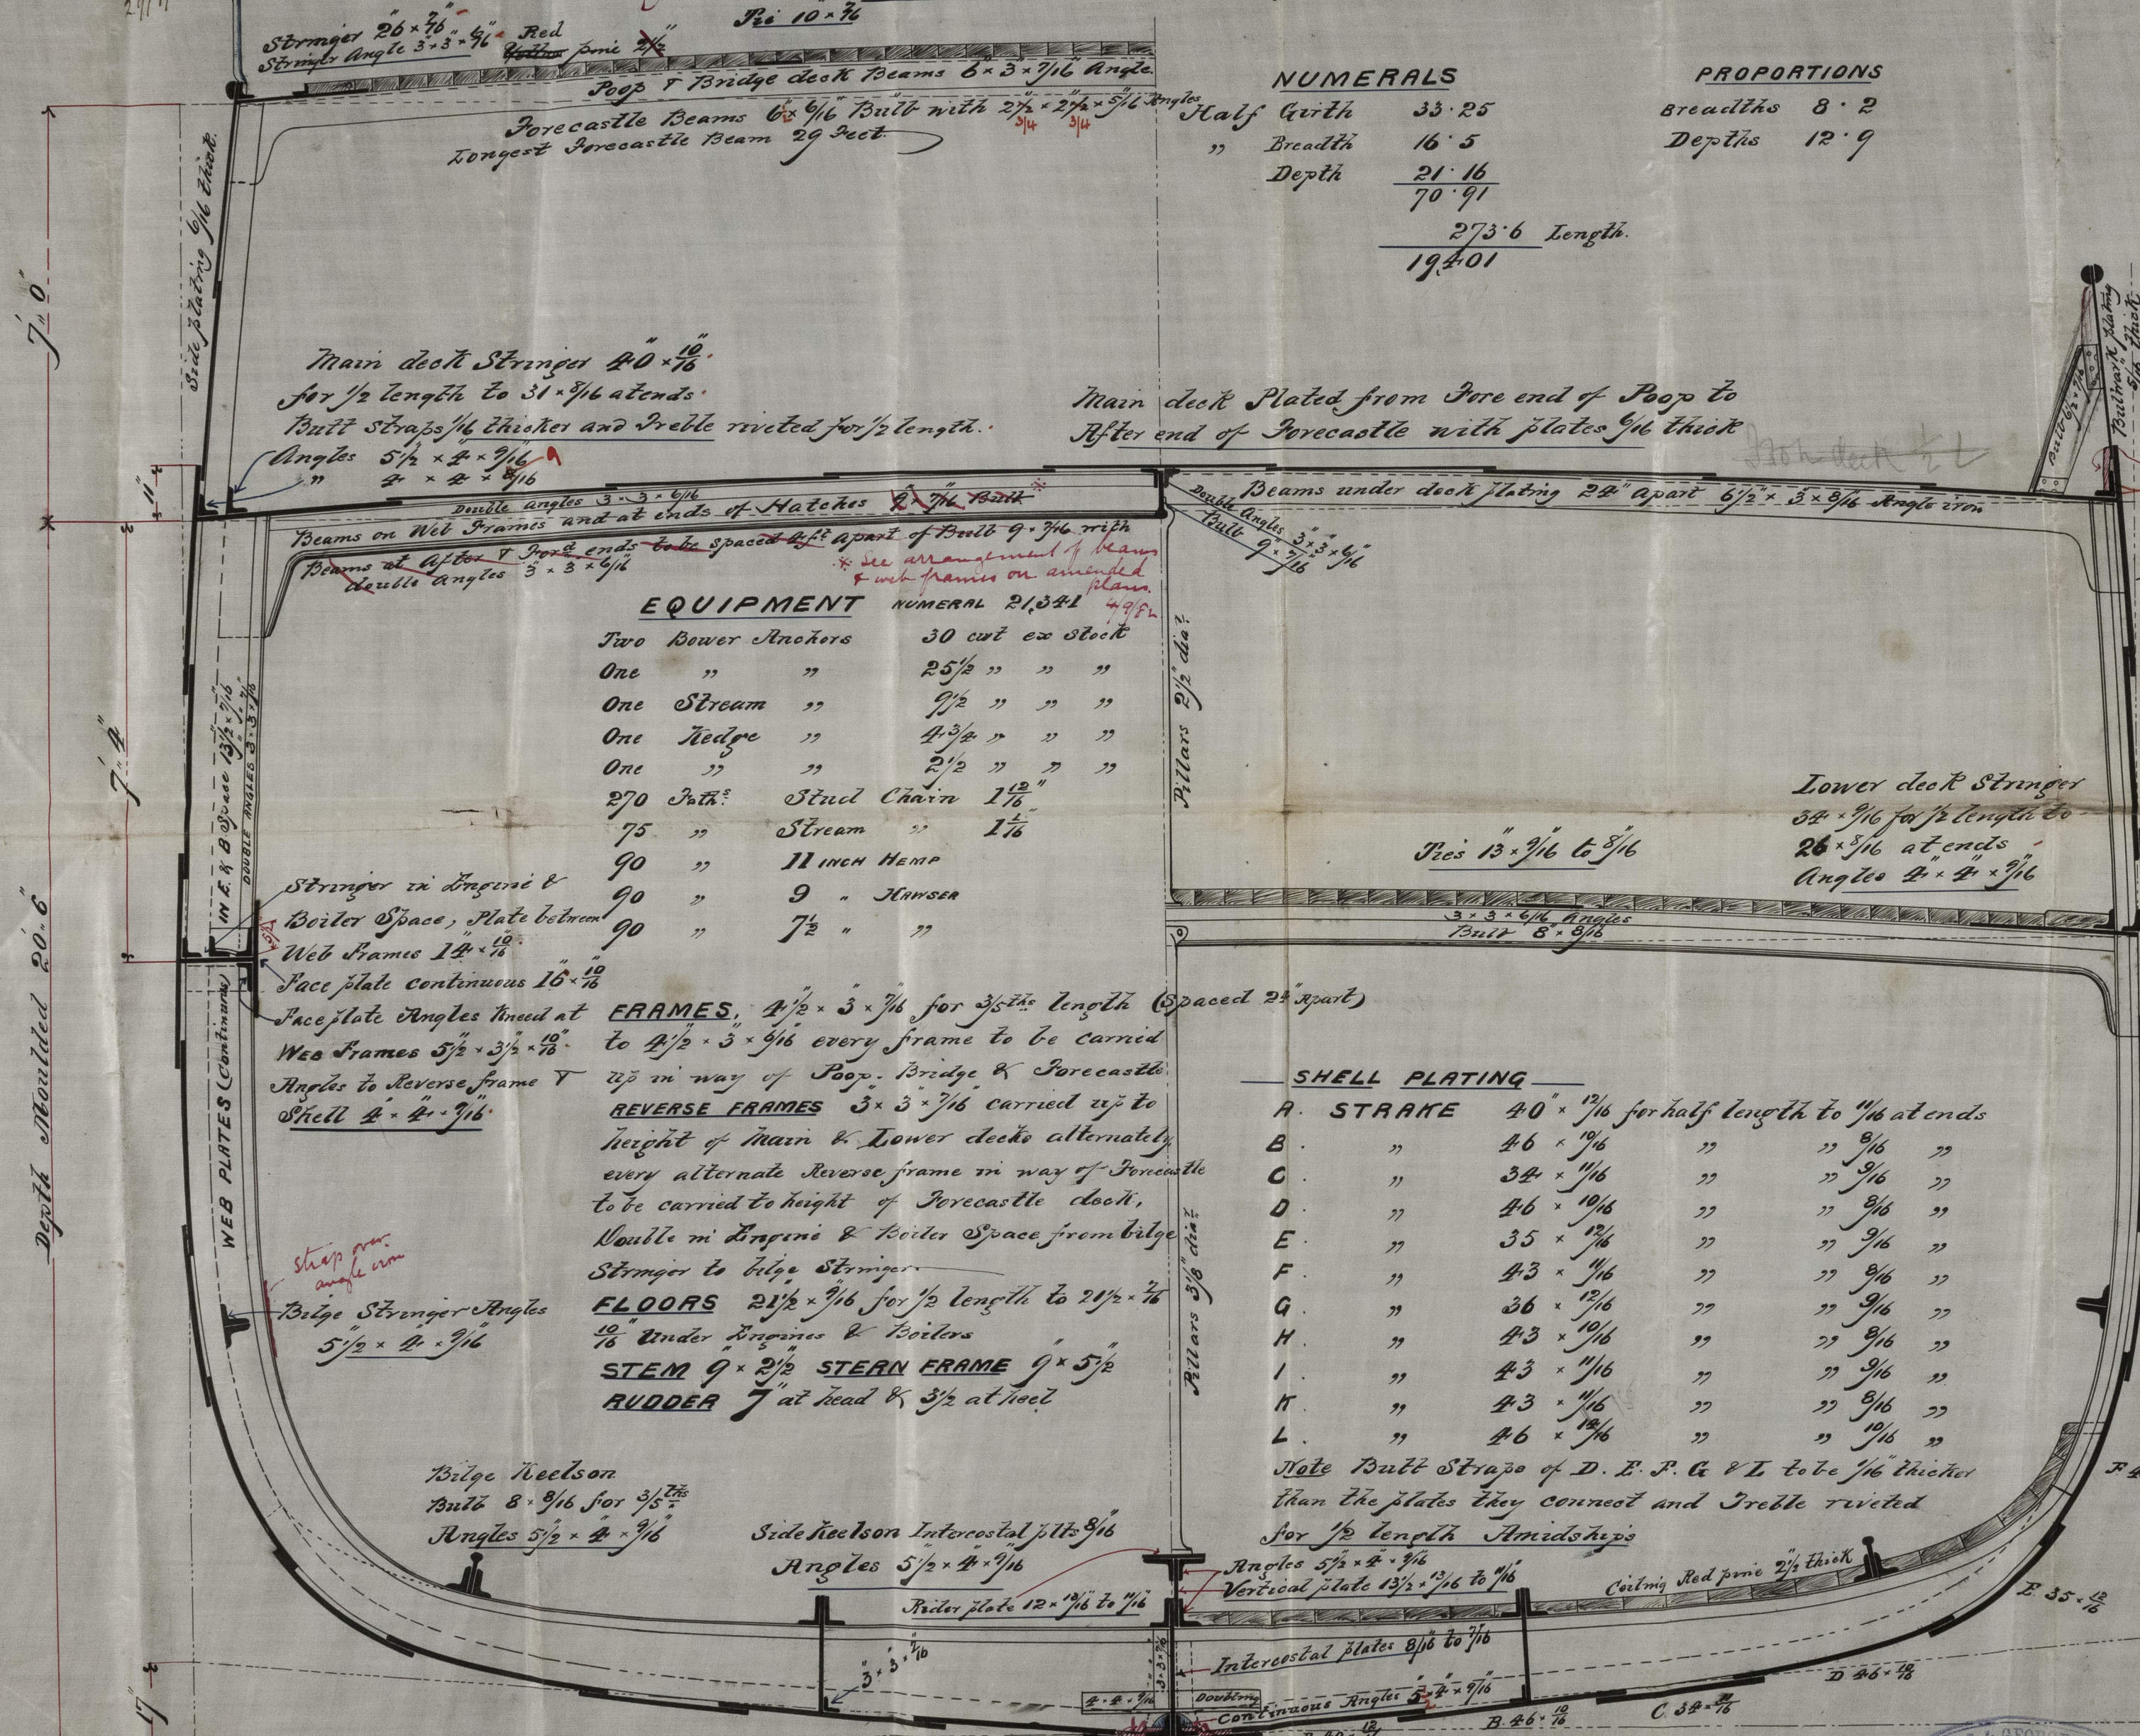

Note -
For position of Web Frames & Beams see Profile tracing
to be submitted for approval

19/8/82
on letter 4/9/82

