



7.82  
7.82  
7.82

19/10/82. L.R. Glasgow.  
J. J. J.  
18/10/82  
20/10/82

UNCLASSIFIED

N. 54. - S. S. "Strathadder" Glasgow Report No. 6192.  
58. - S. S. "Strathpeffer" do 6224.

Profile & Deck Plan of Nos 57+58  
showing Pumping arrangement  
Scale 1/2 Inch to a Foot.

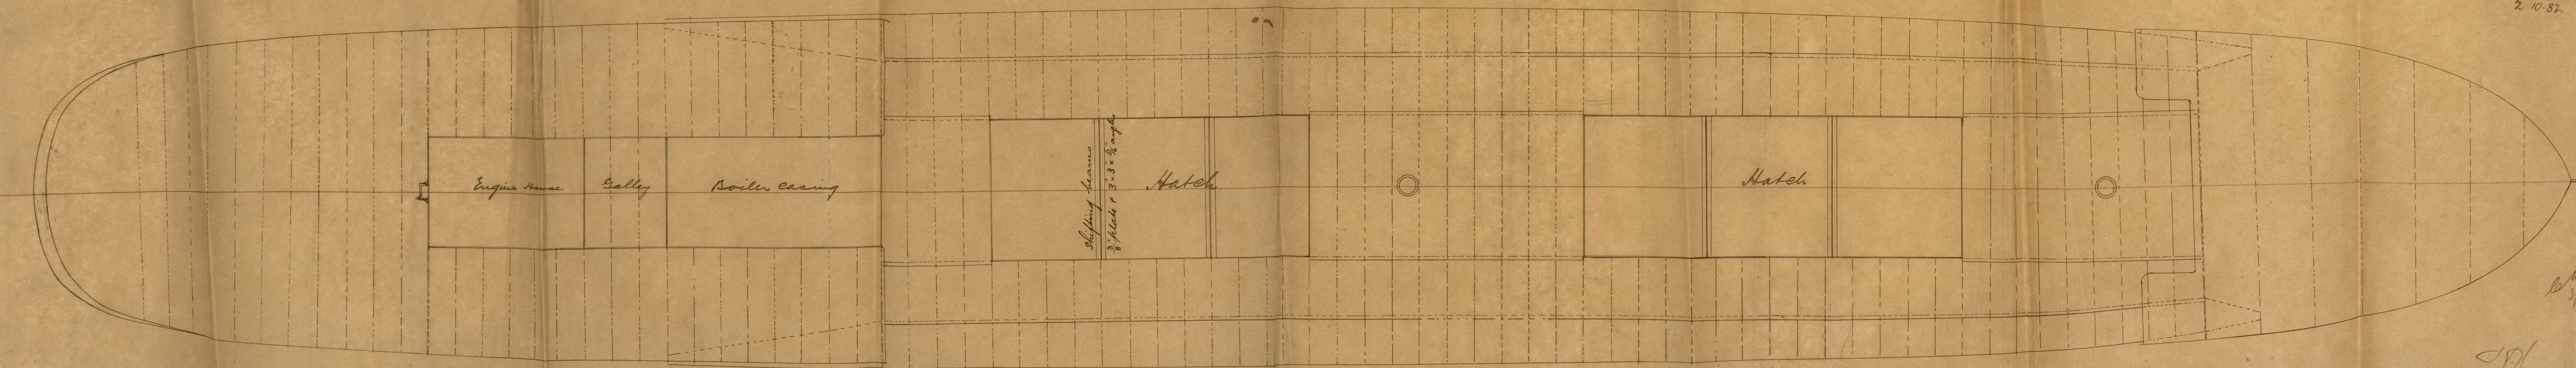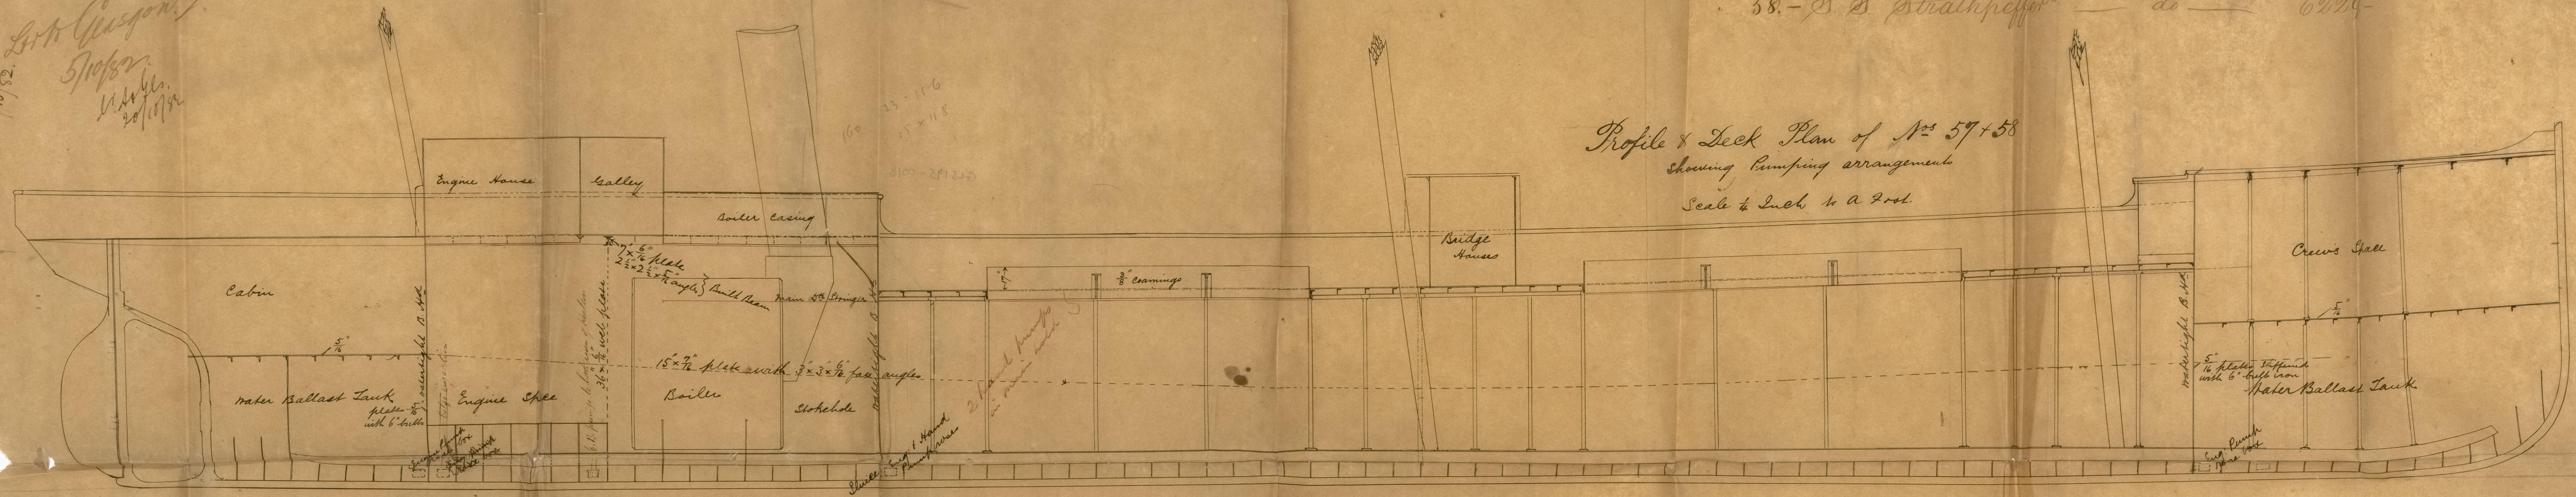

2. 10. 82.

18/10/82



© 2021  
Lloyd's Register  
Foundation



Strathadder

GLS 195-0018

