

RECEIVED OCT 22

DRAWING NO 31

# MARINE BOILER 10'-9" DIAM. 9'-6" LONG.

Working Pressure 50 lbs per sq inch

W. & A. Stewart at Paisley for Messrs Hay & Sons by Ballantyne.

SCALE 1/2 INCH TO ONE FOOT.

S.S. Strathadder Glasgow Repd. 1892.  
S.S. Strathpeffer do 6229

27/10/92

## Heating Surface

138 Tubes 1" x 3 1/2" = 95.5 x 2.5 sq feet  
2 Cornish Headers = 142.65  
2 Furnaces = 57.1  
Total = 295.25



Gross Area = 32.4 sq feet

## List of Plates - S.S. Steel

4 Plates	17'-0" x 5'-0"	1/4"	Shell
2 "	16'-0" x 5'-0"	1/4"	End
3 "	16'-0" x 5'-0"	1/4"	End
1 "	8'-0" x 5'-0"	1/4"	End
1 "	8'-0" x 5'-0"	1/4"	End
1 "	11'-0" x 4'-0"	1/4"	End
1 "	11'-0" x 4'-0"	1/4"	End
1 "	8'-0" x 4'-0"	1/4"	End
1 "	4'-0" x 1'-0"	1/4"	End
2 "	3'-0" diam	1/4"	End
2 "	6'-0" x 6'-0"	1/4"	End
2 "	6'-0" x 3'-0"	1/4"	End
2 "	9'-0" x 3'-0"	1/4"	End
2 "	10'-0" x 3'-0"	1/4"	End
2 "	7'-0" x 5'-0"	1/4"	End
2 "	5'-0" x 5'-0"	1/4"	End
6 "	3'-0" x 9'-0"	1/4"	End
6 "	2'-0" x 7'-0"	1/4"	End
8 "	3'-0" x 3'-0"	1/4"	End

## Double Riveted

1/2" Rivets 5" Pitch

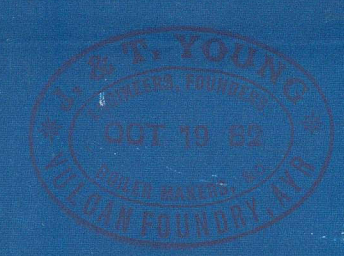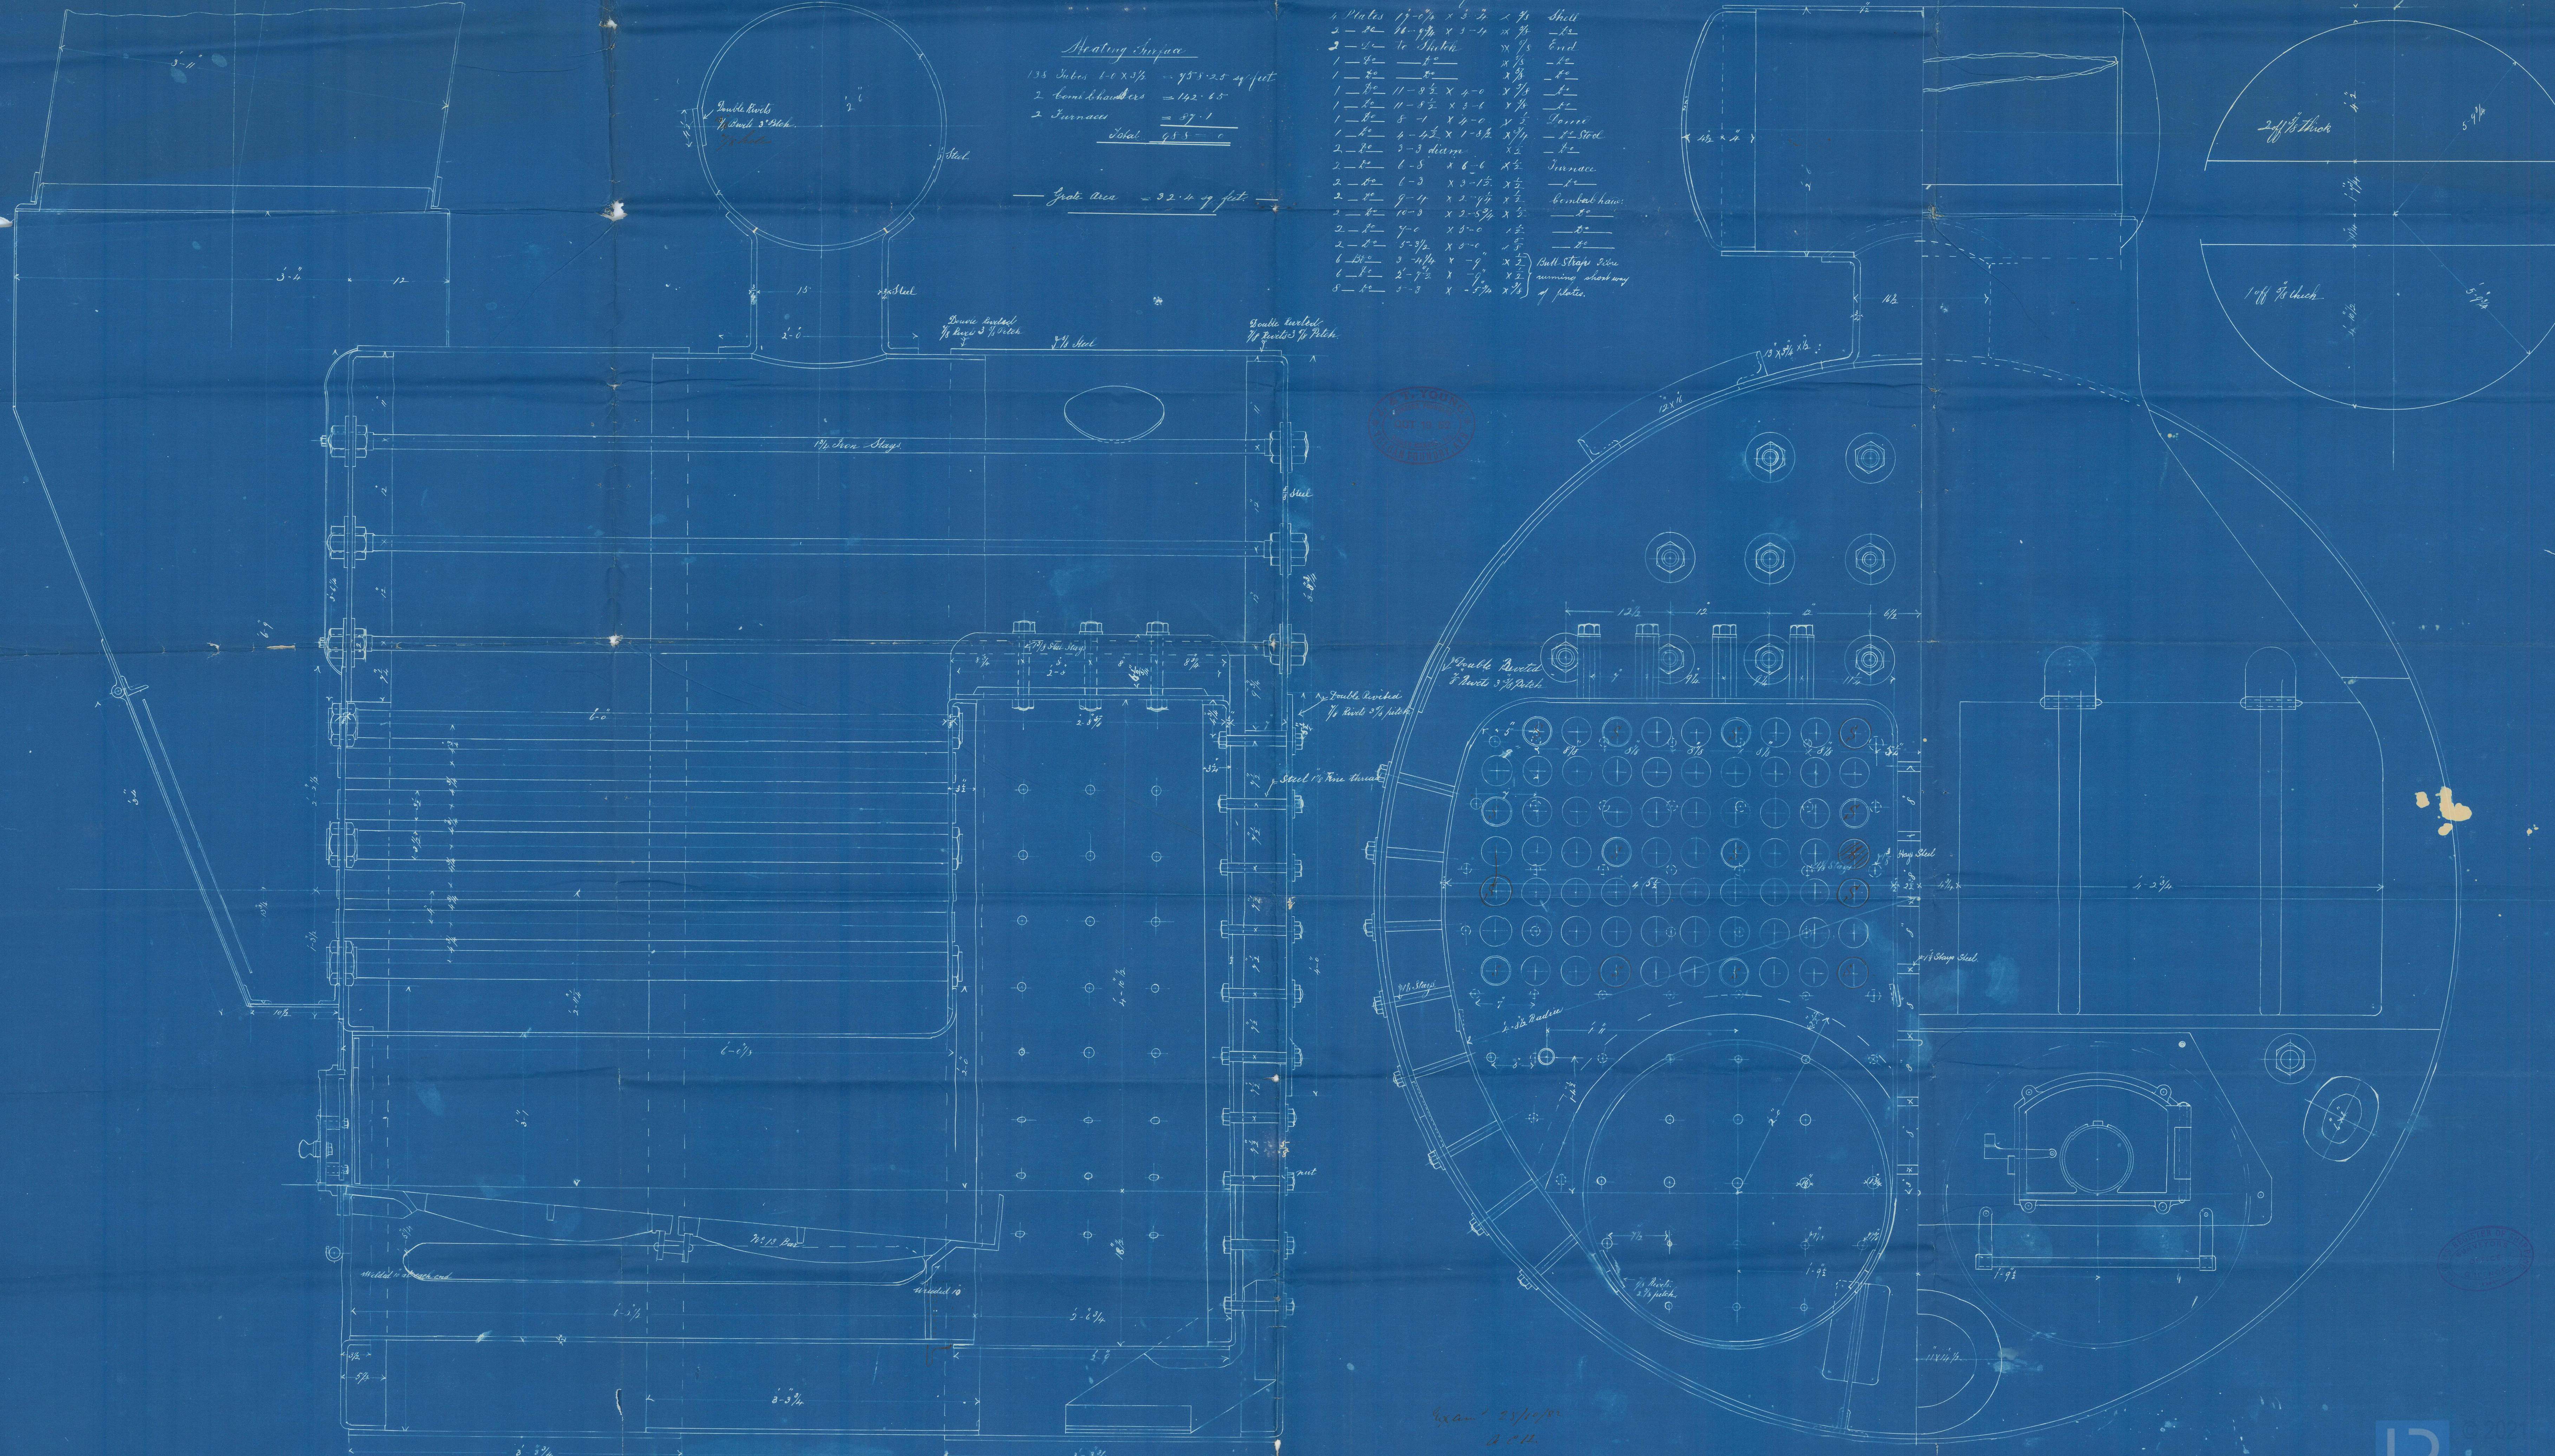



Strathadder

Strathpeffer

GLS195-0019



© 2021

Lloyd's Register  
Foundation