



S.S. "Torreador"
Glasgow Report No. 6205.

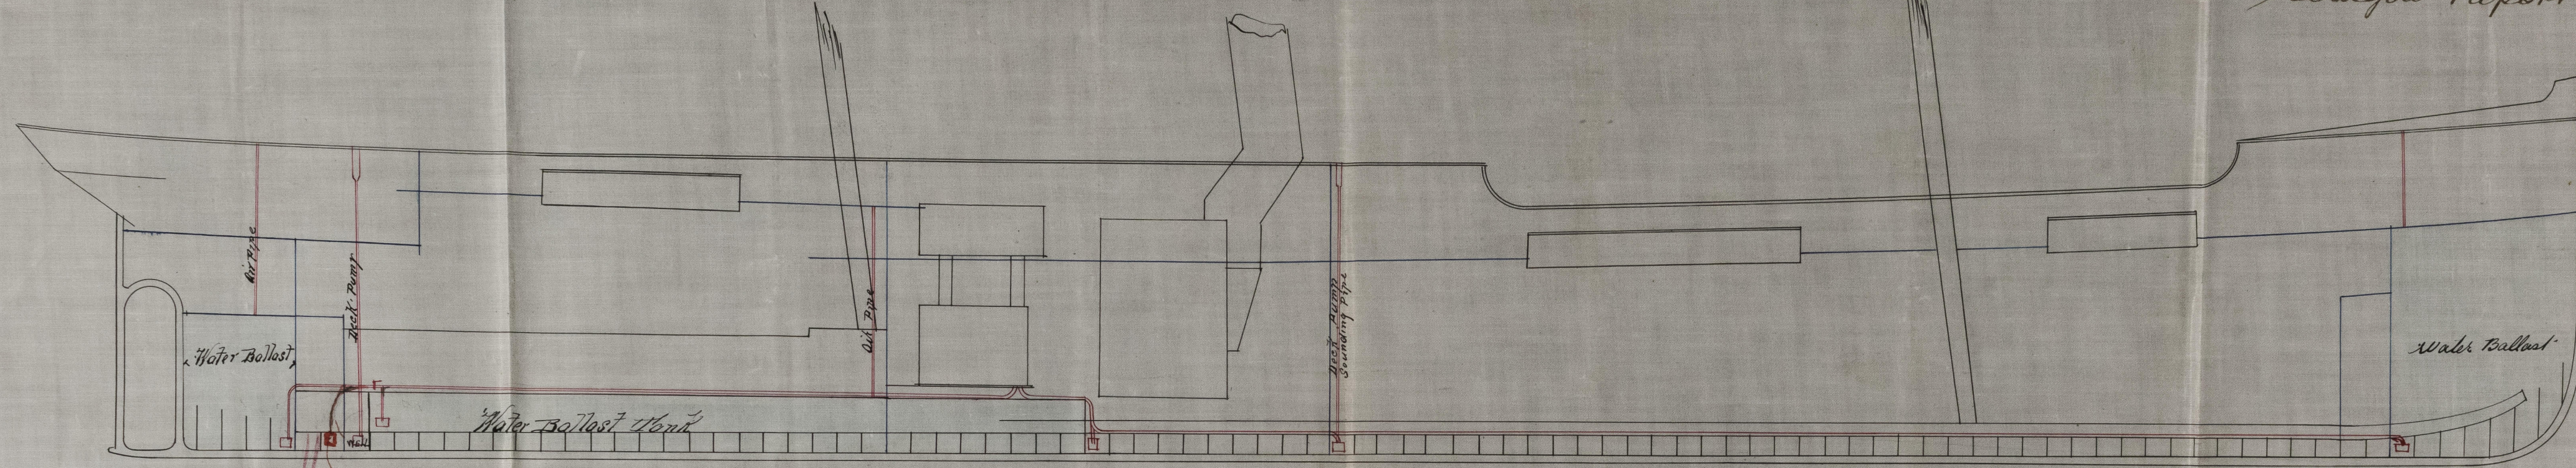


suction into tunnel well

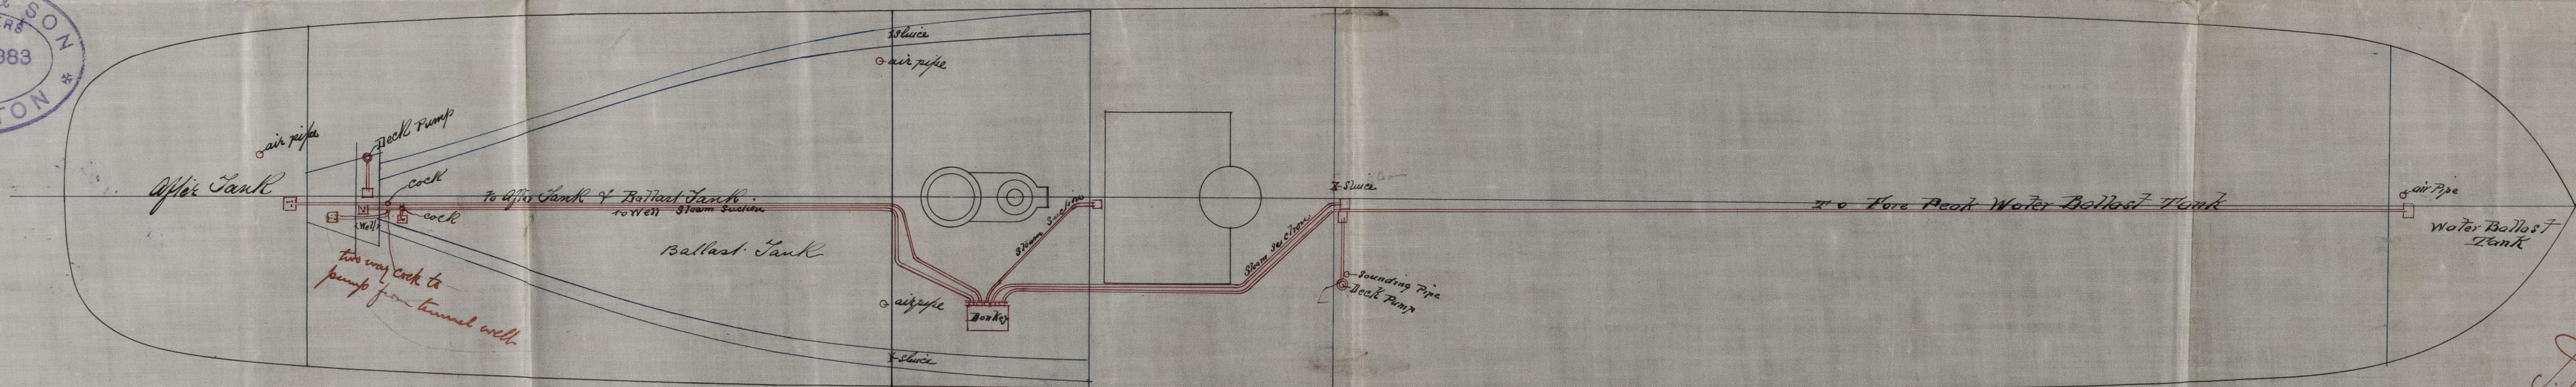

two way cock to pump from tunnel well

*Piping Plan for S.S. No. 24
— Scale 1/8" = one foot —*

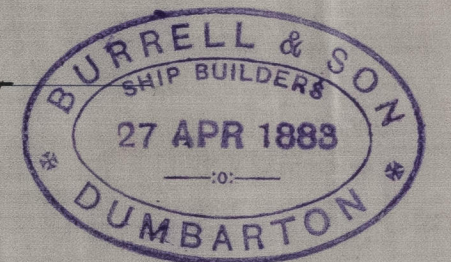

J. H. J.



© 2021
Lloyd's Register Foundation
GLS195-0040